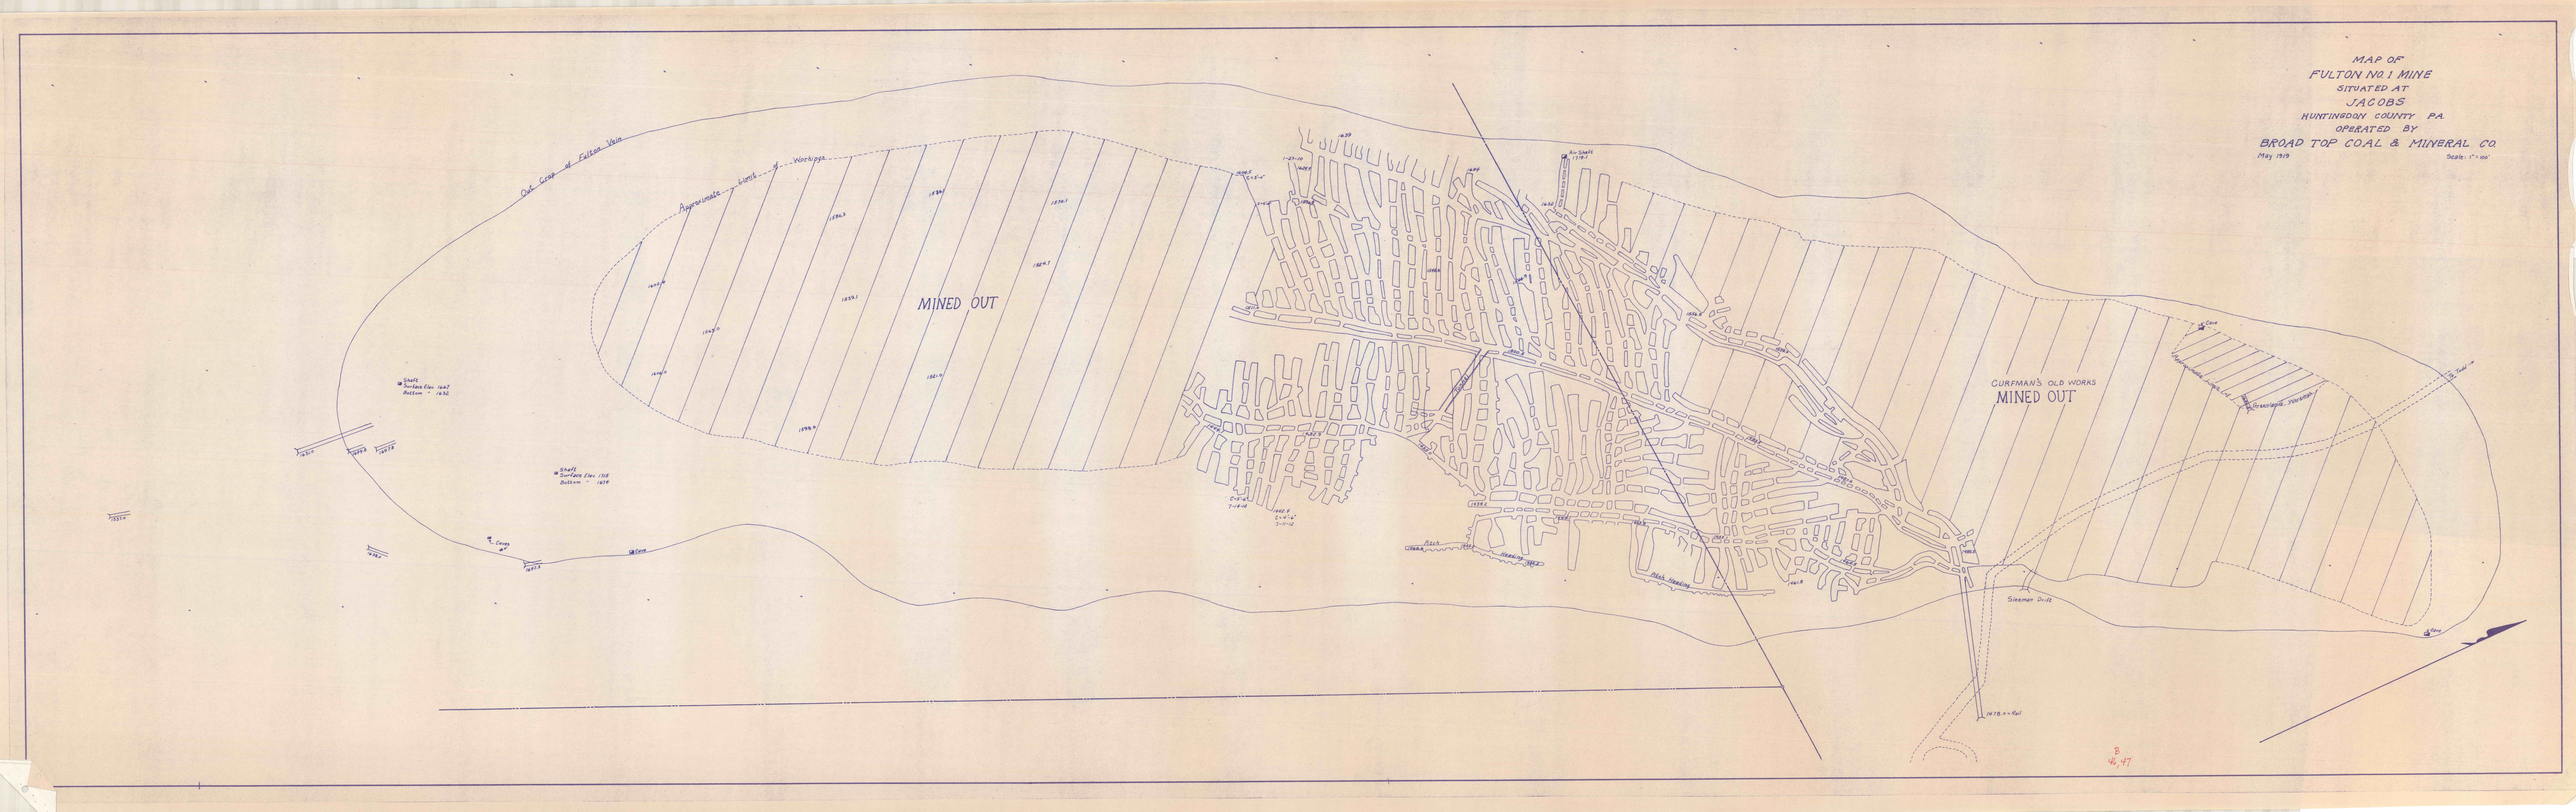
MAP OF
FULTON NO. 1 MINE
SITUATED AT
JACOBS
HUNTINGDON COUNTY PA.
OPERATED BY
BROAD TOP COAL & MINERAL CO.
May 1919
Scale: 1" = 100'
Out Crop of Fulton Vein
Approximate Limit of Workings
MINED OUT
Shaft
Surface Elev. 1647
Bottom " 1632
Shaft
Surface Elev. 1715
Bottom " 1679
Air Shaft
1784
Crop
Crop
Crop
Crop
Crop
Rock Heading
Rock Heading
Rock Heading
Rock Heading
Gurfman's Old Works
MINED OUT
Crossing Roadway
Sidehill Drift
1978 B.O.H. Gal
B
46,47