




DK #16

EL. SUR. 1629.5

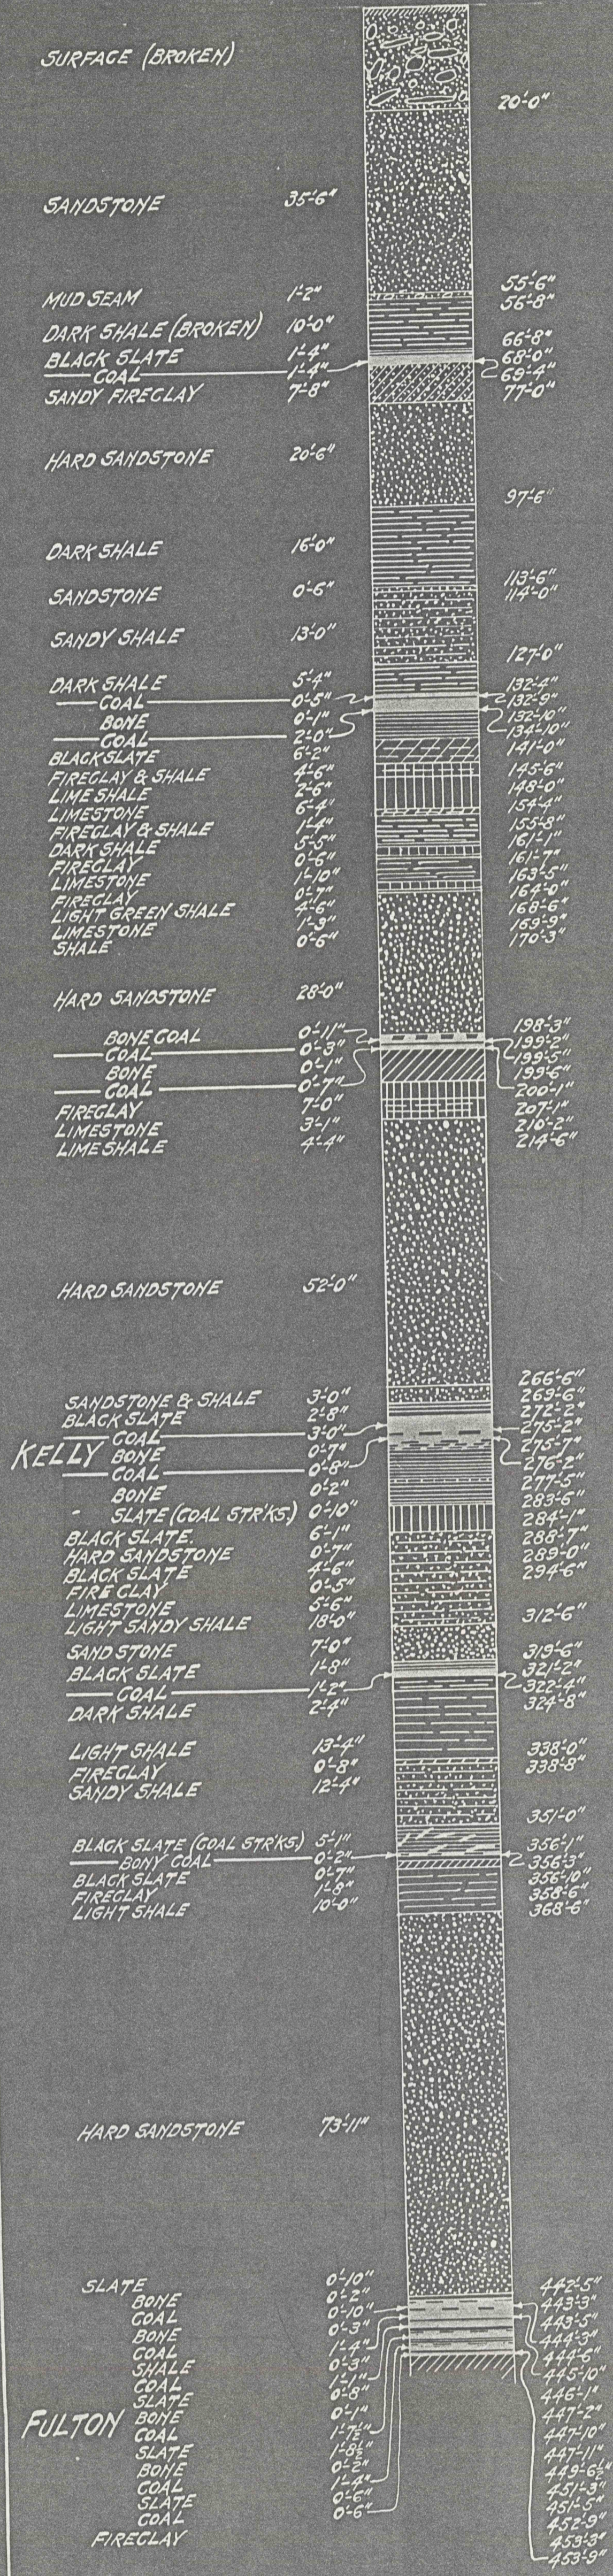

DETAILS OF KELLY SEAM

DETAILS OF FULTON SEAM

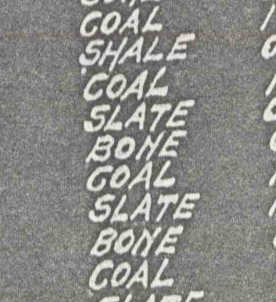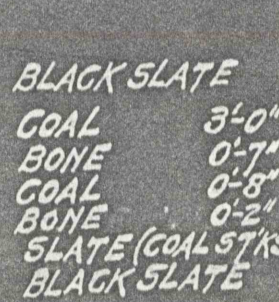

SECTION OF MEASURES IN DIAMOND DRILL HOLE No 16 (ISAAC BARNETT TRACT)

PENN CENTRAL LIGHT & POWER CO. BROAD TOP TWP, BEDFORD CO., PA.

SCALE: 1"=20' DRILLED BY L.J. HUGHES

W.A. SILLIMAN, MINING ENGR. ALTOONA, PA.

DEC. 1930.