


D.D.H. # 20

Elev. 1554.5

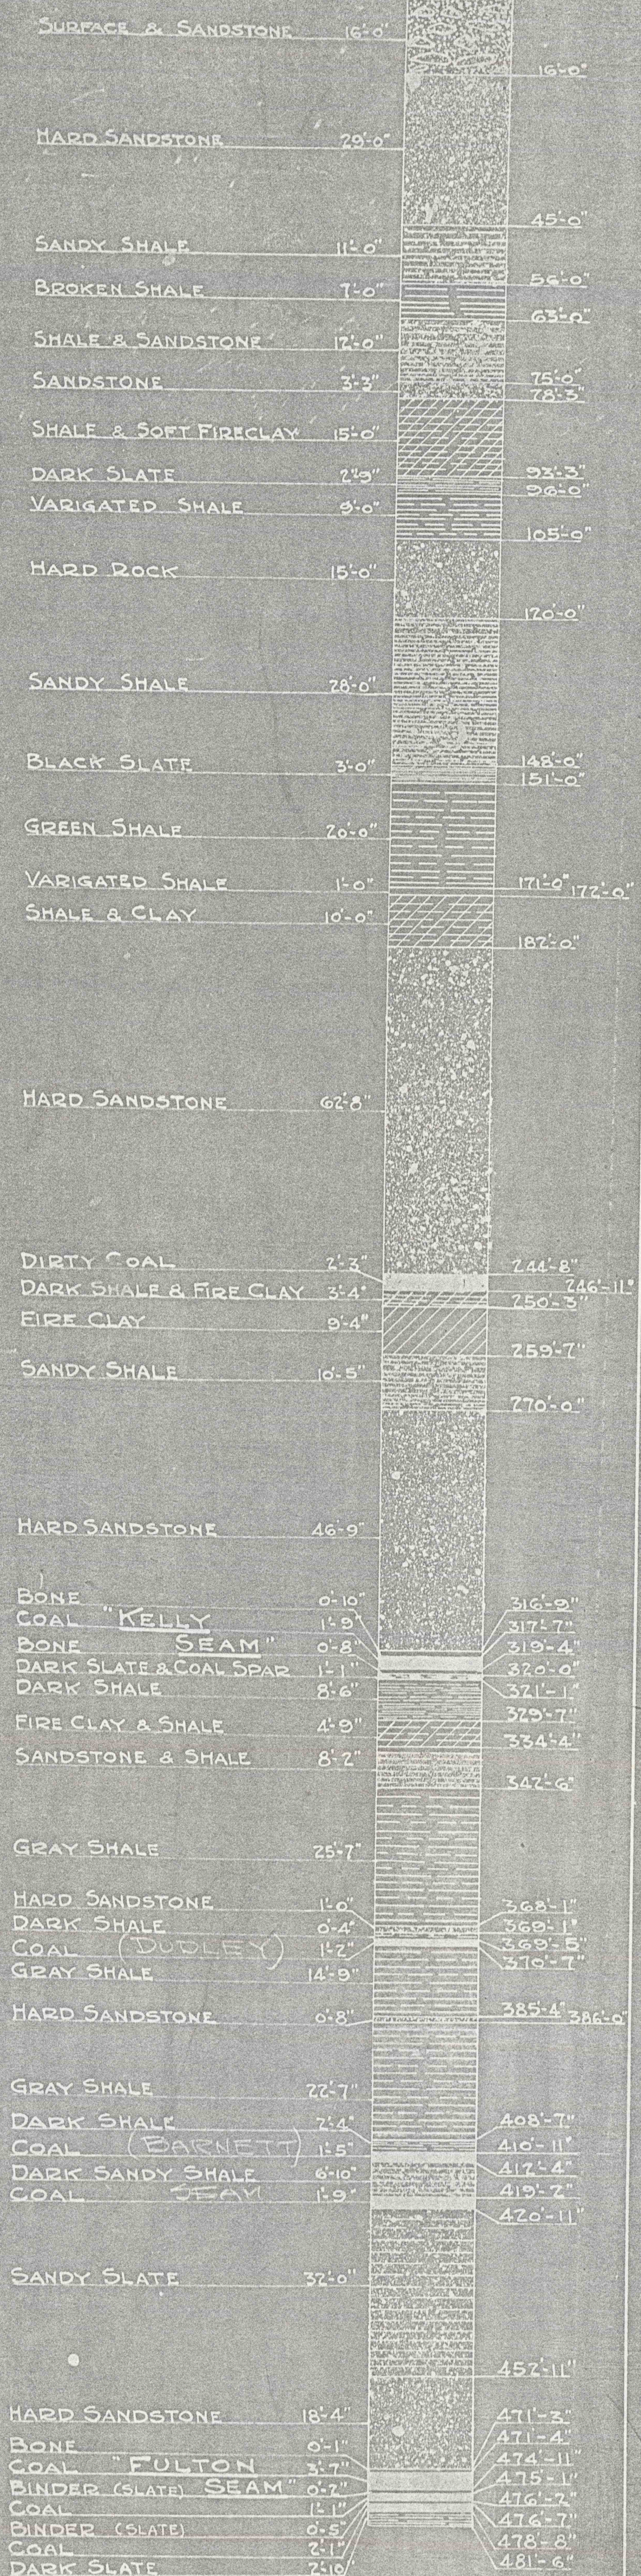

SECTION OF MEASURES
 IN
 DIAMOND DRILL HOLE NO. 20
 ON PROPERTY OF
 PENN CENTRAL LIGHT & POWER CO
 BROAD TOP TWP., BEDFORD CO., PA.
 BLAIR ENGINEERING & SUPPLY CO.
 ALTOONA, PA.

DRILLED BY CARL HETAGER PUNXSUTAWNEY, PA. MARCH 1934