


D. D. H. # 21A

EI. 1469.7

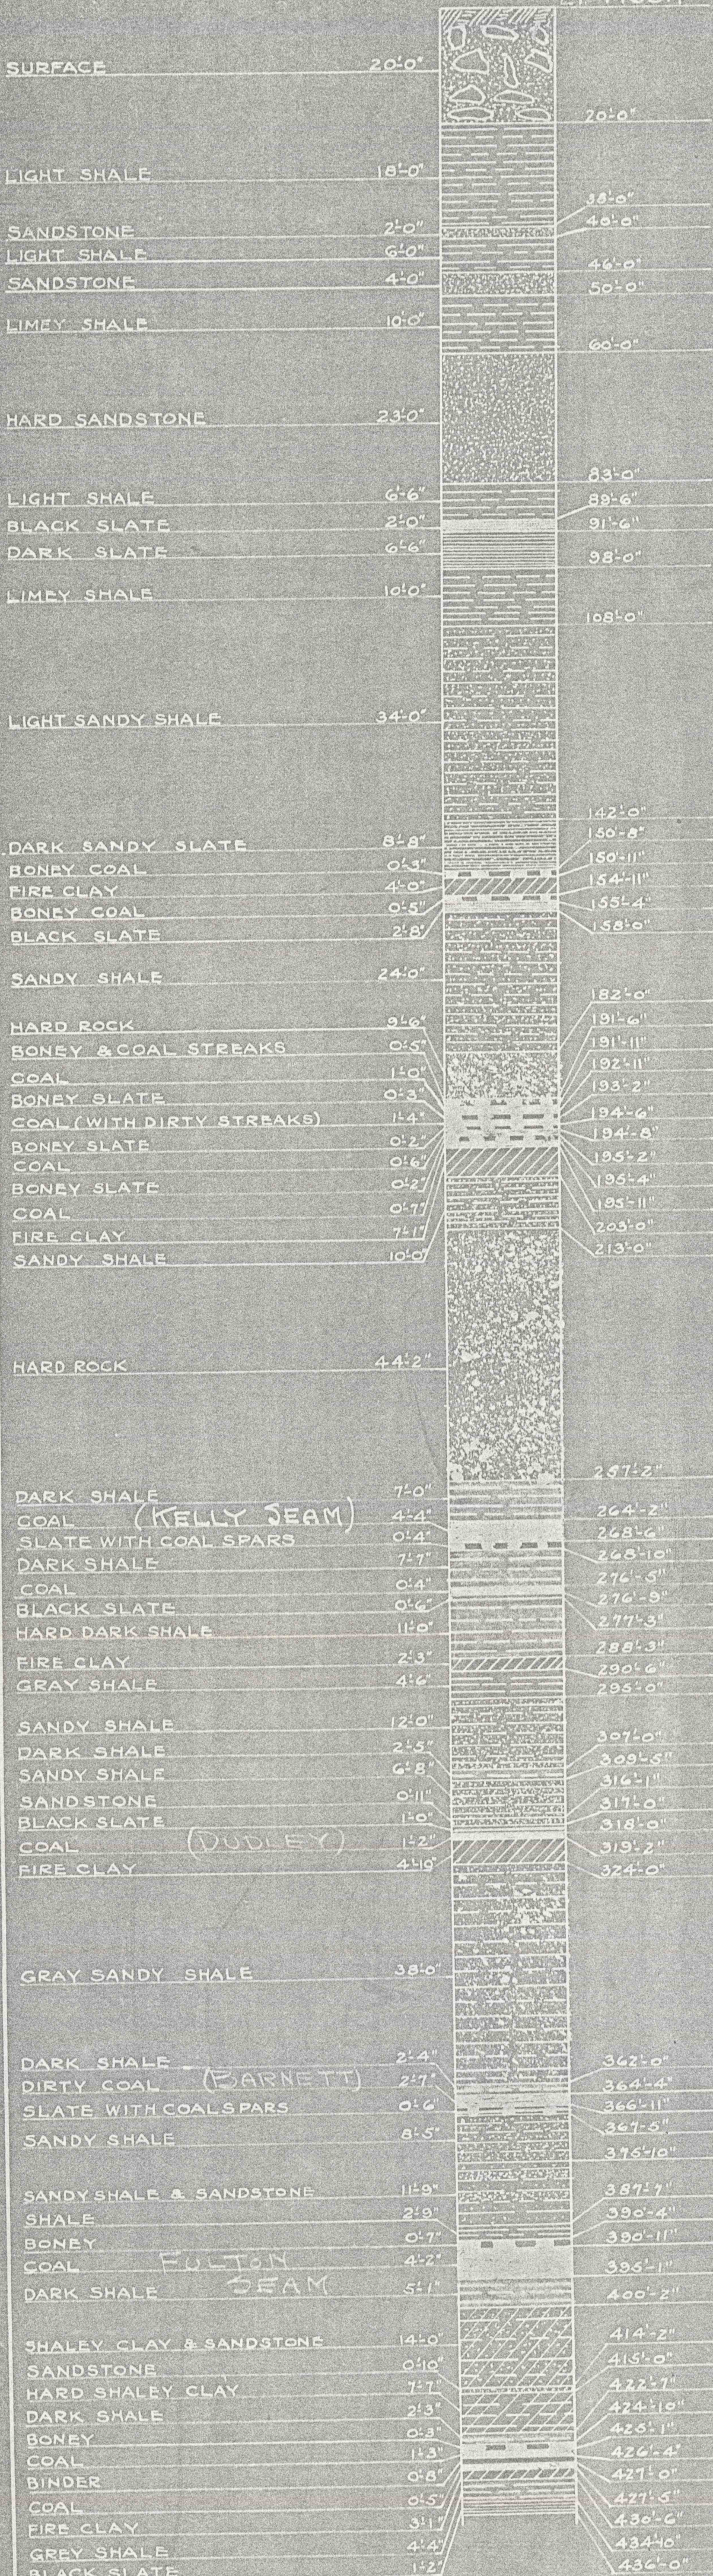

SECTION OF MEASURES
IN
DIAMOND DRILL HOLE NO. 21A
ON PROPERTY OF
PENN CENTRAL LIGHT & POWER CO.
BROAD TOP TWP, BEDFORD CO., PA.
BLAIR ENGINEERING & SUPPLY CO.
ALTOONA, PA.

DRILLED BY CARL HETAGER, PUNXSUTAWNEY, PA. MAR. 1934