


J BLACK

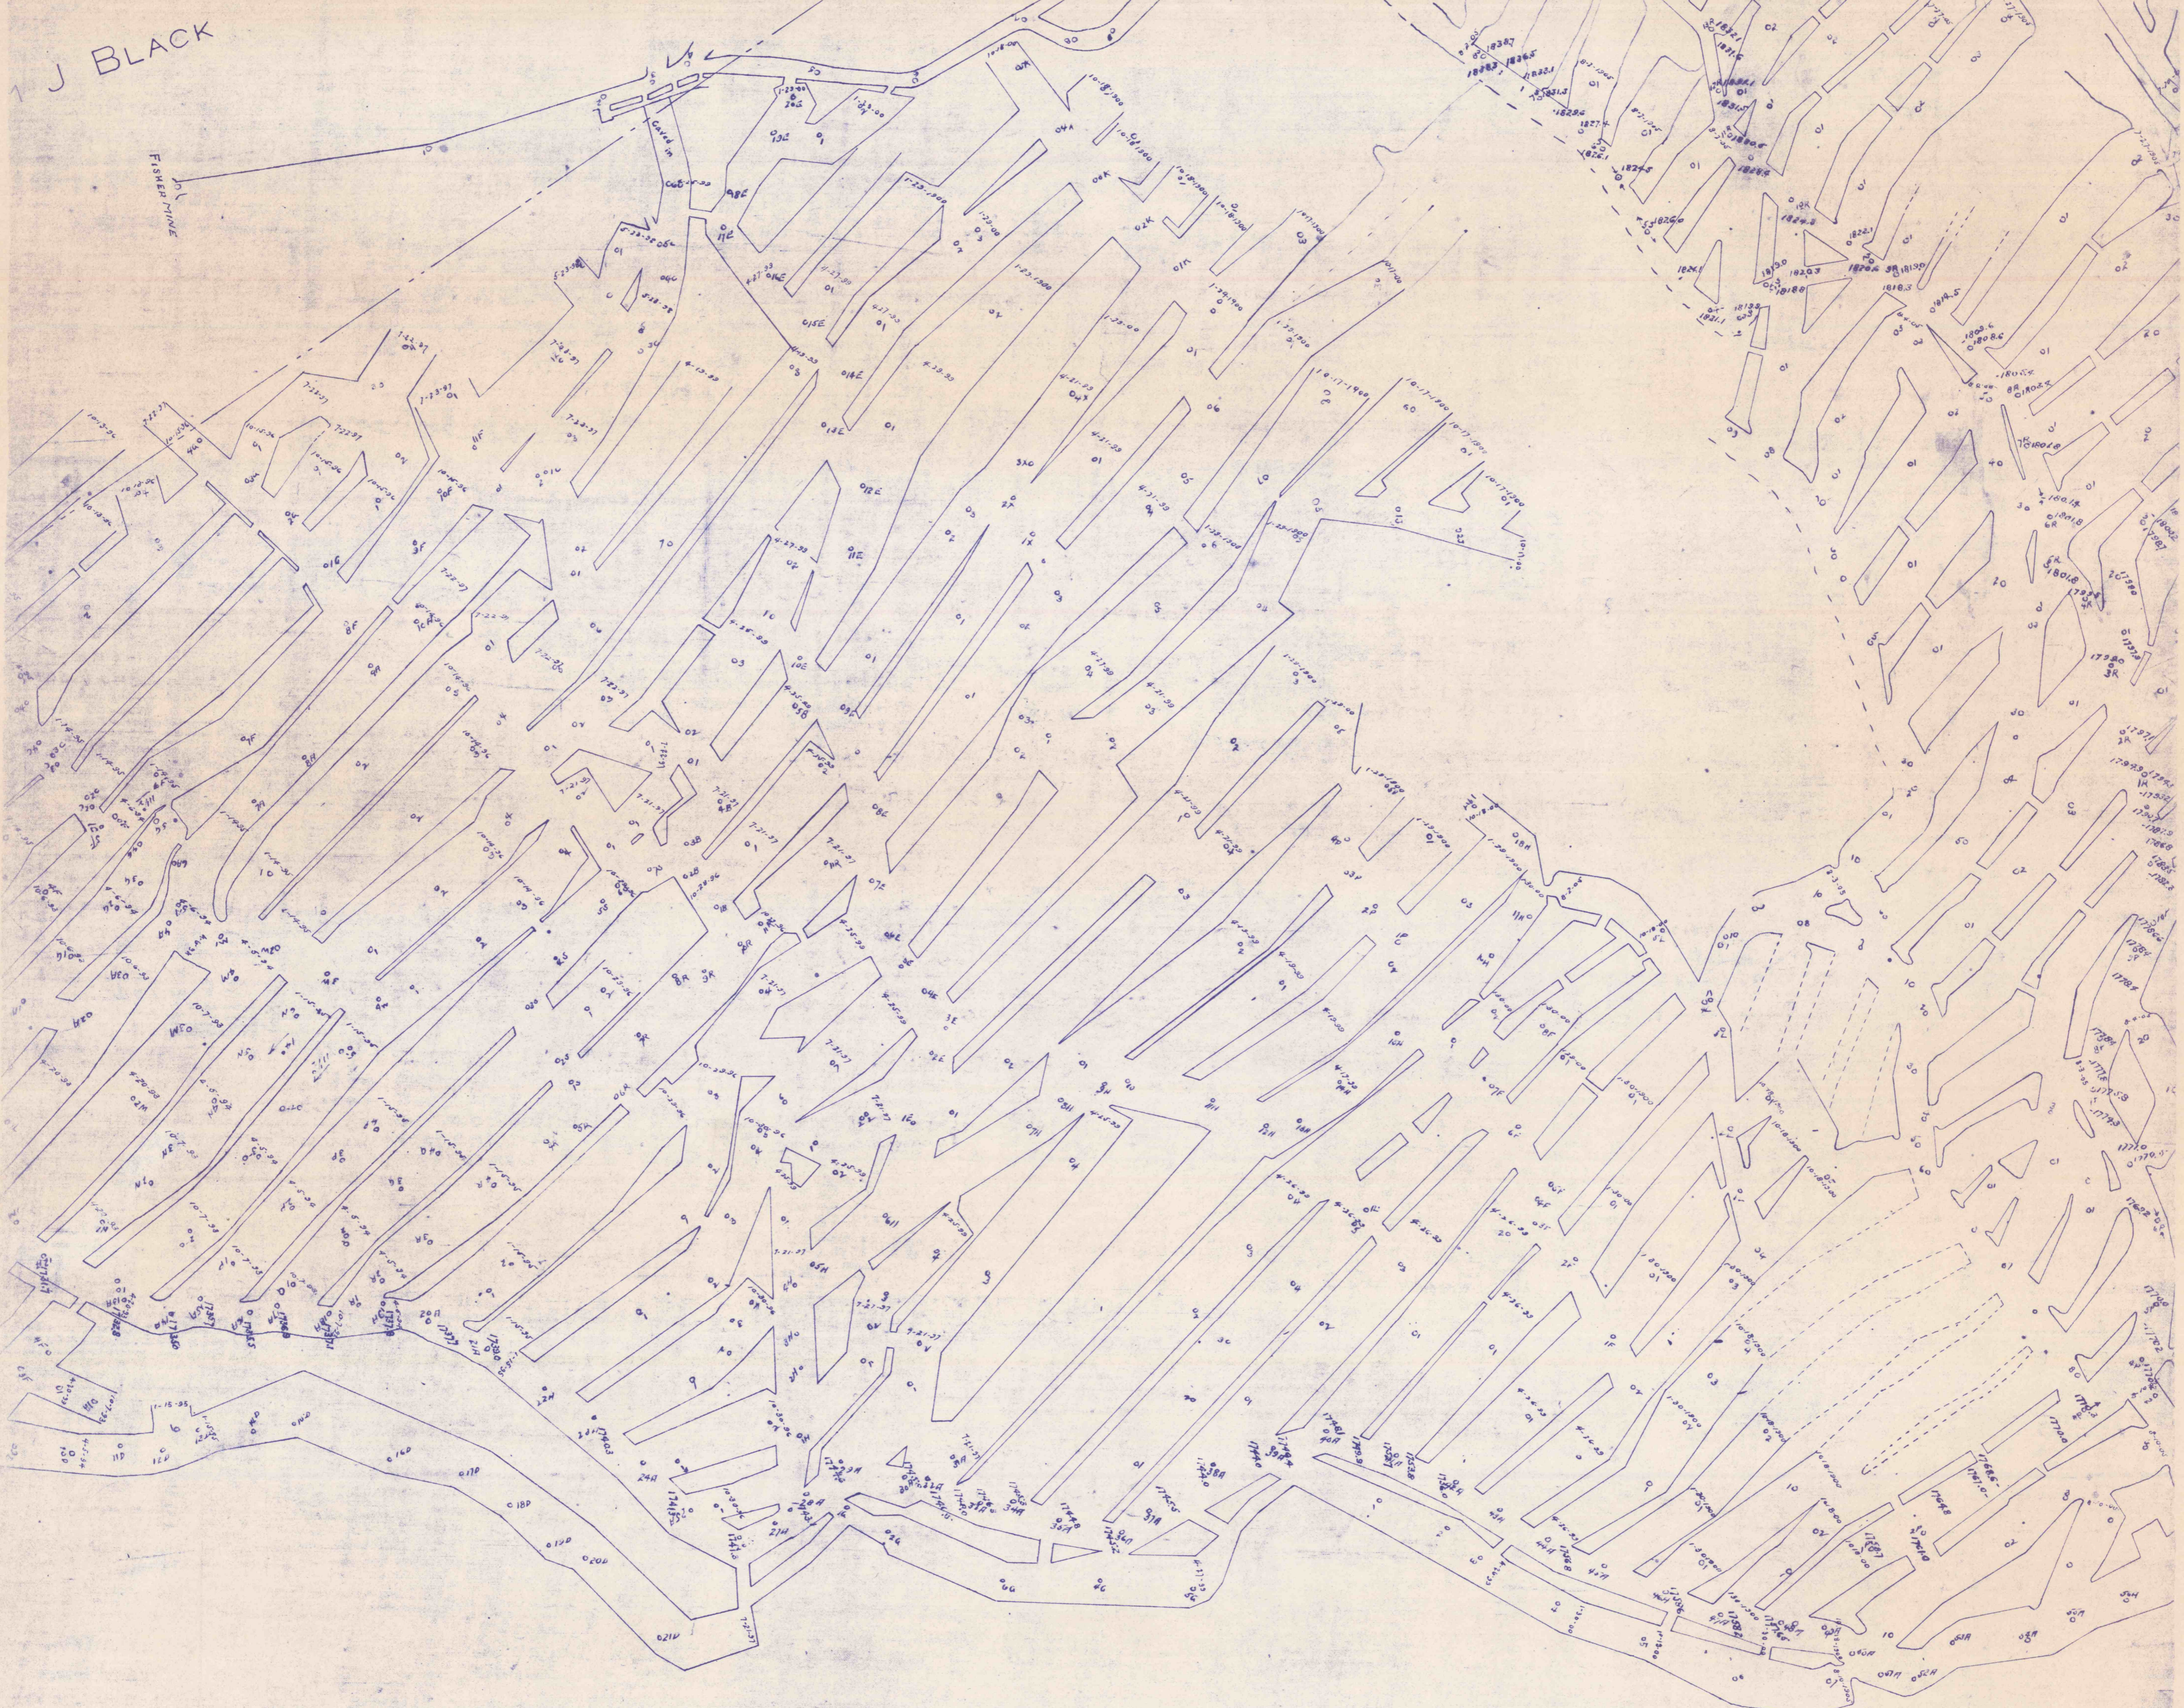

MAP  
OF

MOOREDALE MINE  
—BARNETT SEAM—

BROAD TOP SEMI-ANTHRACITE COAL CO  
1905

SCALE: 100 FT PER INCH

*P. H. Brown*  
ENGR.

B  
17