

MAP OF MINE
ON
BARNET SEAM
SITUATED AT
JACOBS, HUNTINGDON CO. PA.
OPERATED BY
BROAD TOP COAL & MINERAL CO.
May 1919

Scale: 1"=100'

Shaft
Sur. Elev. = 1749.6
Bottom = 1719.1 Fulben Seam

Shaft
Coal = 1639
Sur. = 1728


7-18-14
C=3' 1/2"

1699
C=2' 4"

1682

7-5-12
C=3' 2"
1678

1673

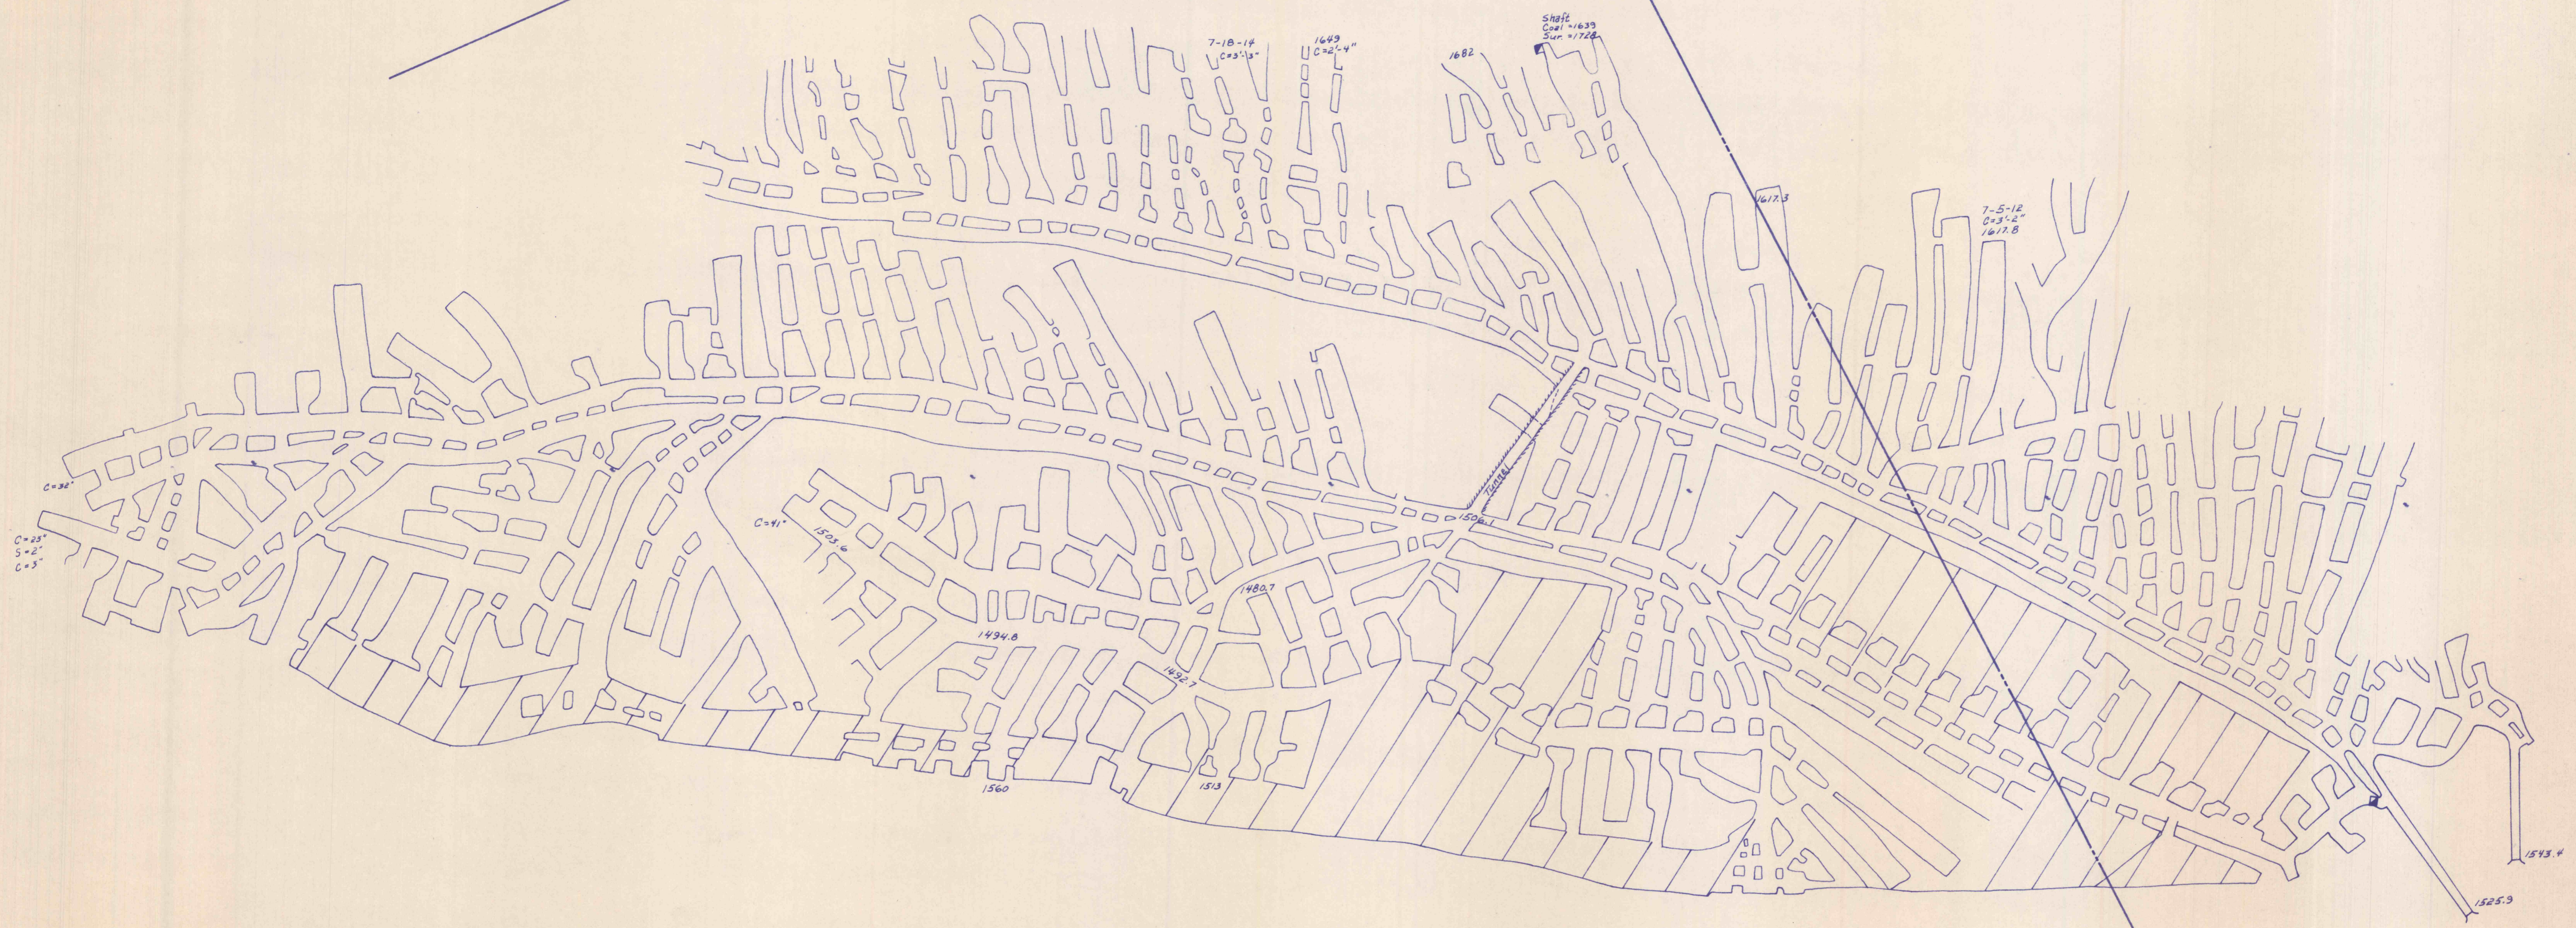

C=32'
C=23'
5=2'
C=3'

C=41'

C=50'

1543.4

1525.3