


OCEAN No 5 MINE  
operated by  
CARBON COAL & COKE CO

SCALE - 1 INCH = 100 FEET

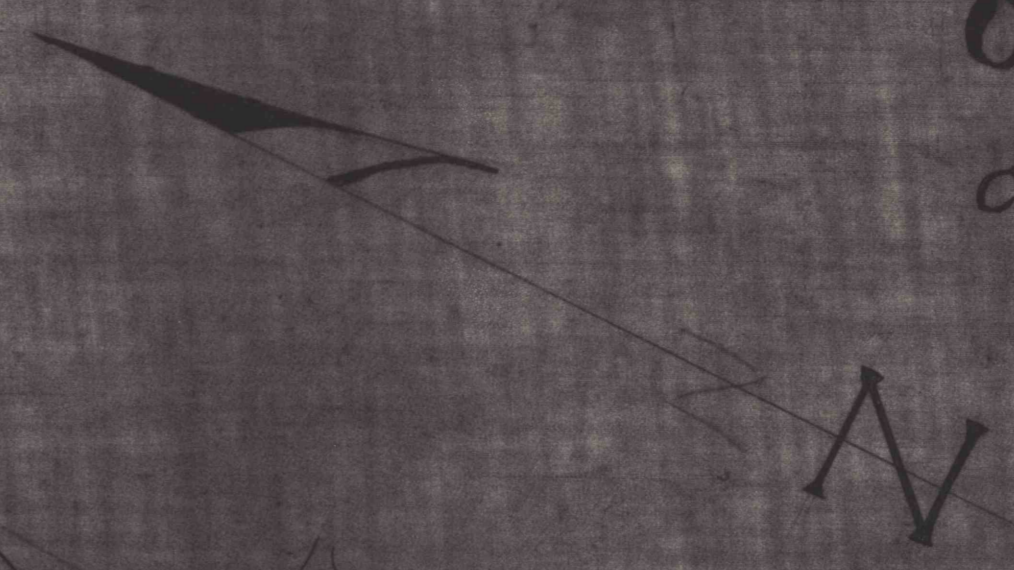

FULTON SEAM



OLD WORKINGS