


OLD MARTIN MINE

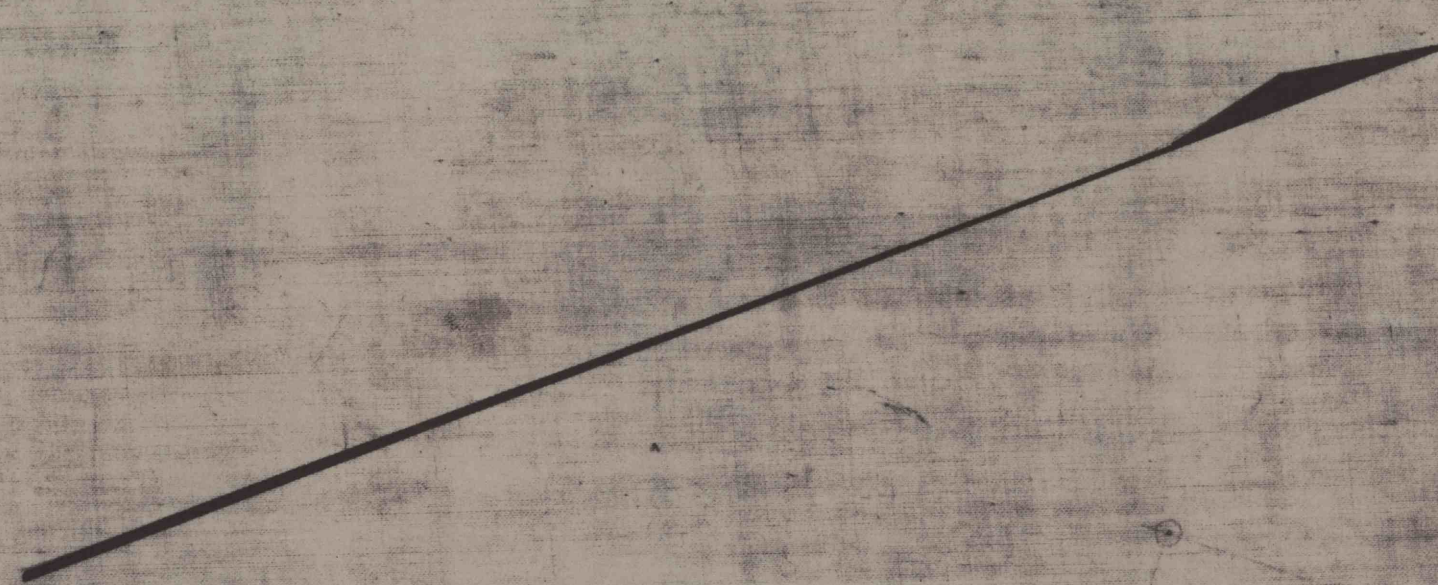


Prospect No. 1
Prospect No. 2

Stambaugh Prospect

J. H. MILLER ESTATE MINE MAP MINE No 1

JOLLER, PENNA
Surveyed March 1878 by T.F. Price
Traced July 1883 by D. Bentzinger
Scale 1"=100'
Revised 8-1-22 D.E.C.

Fulton exam?

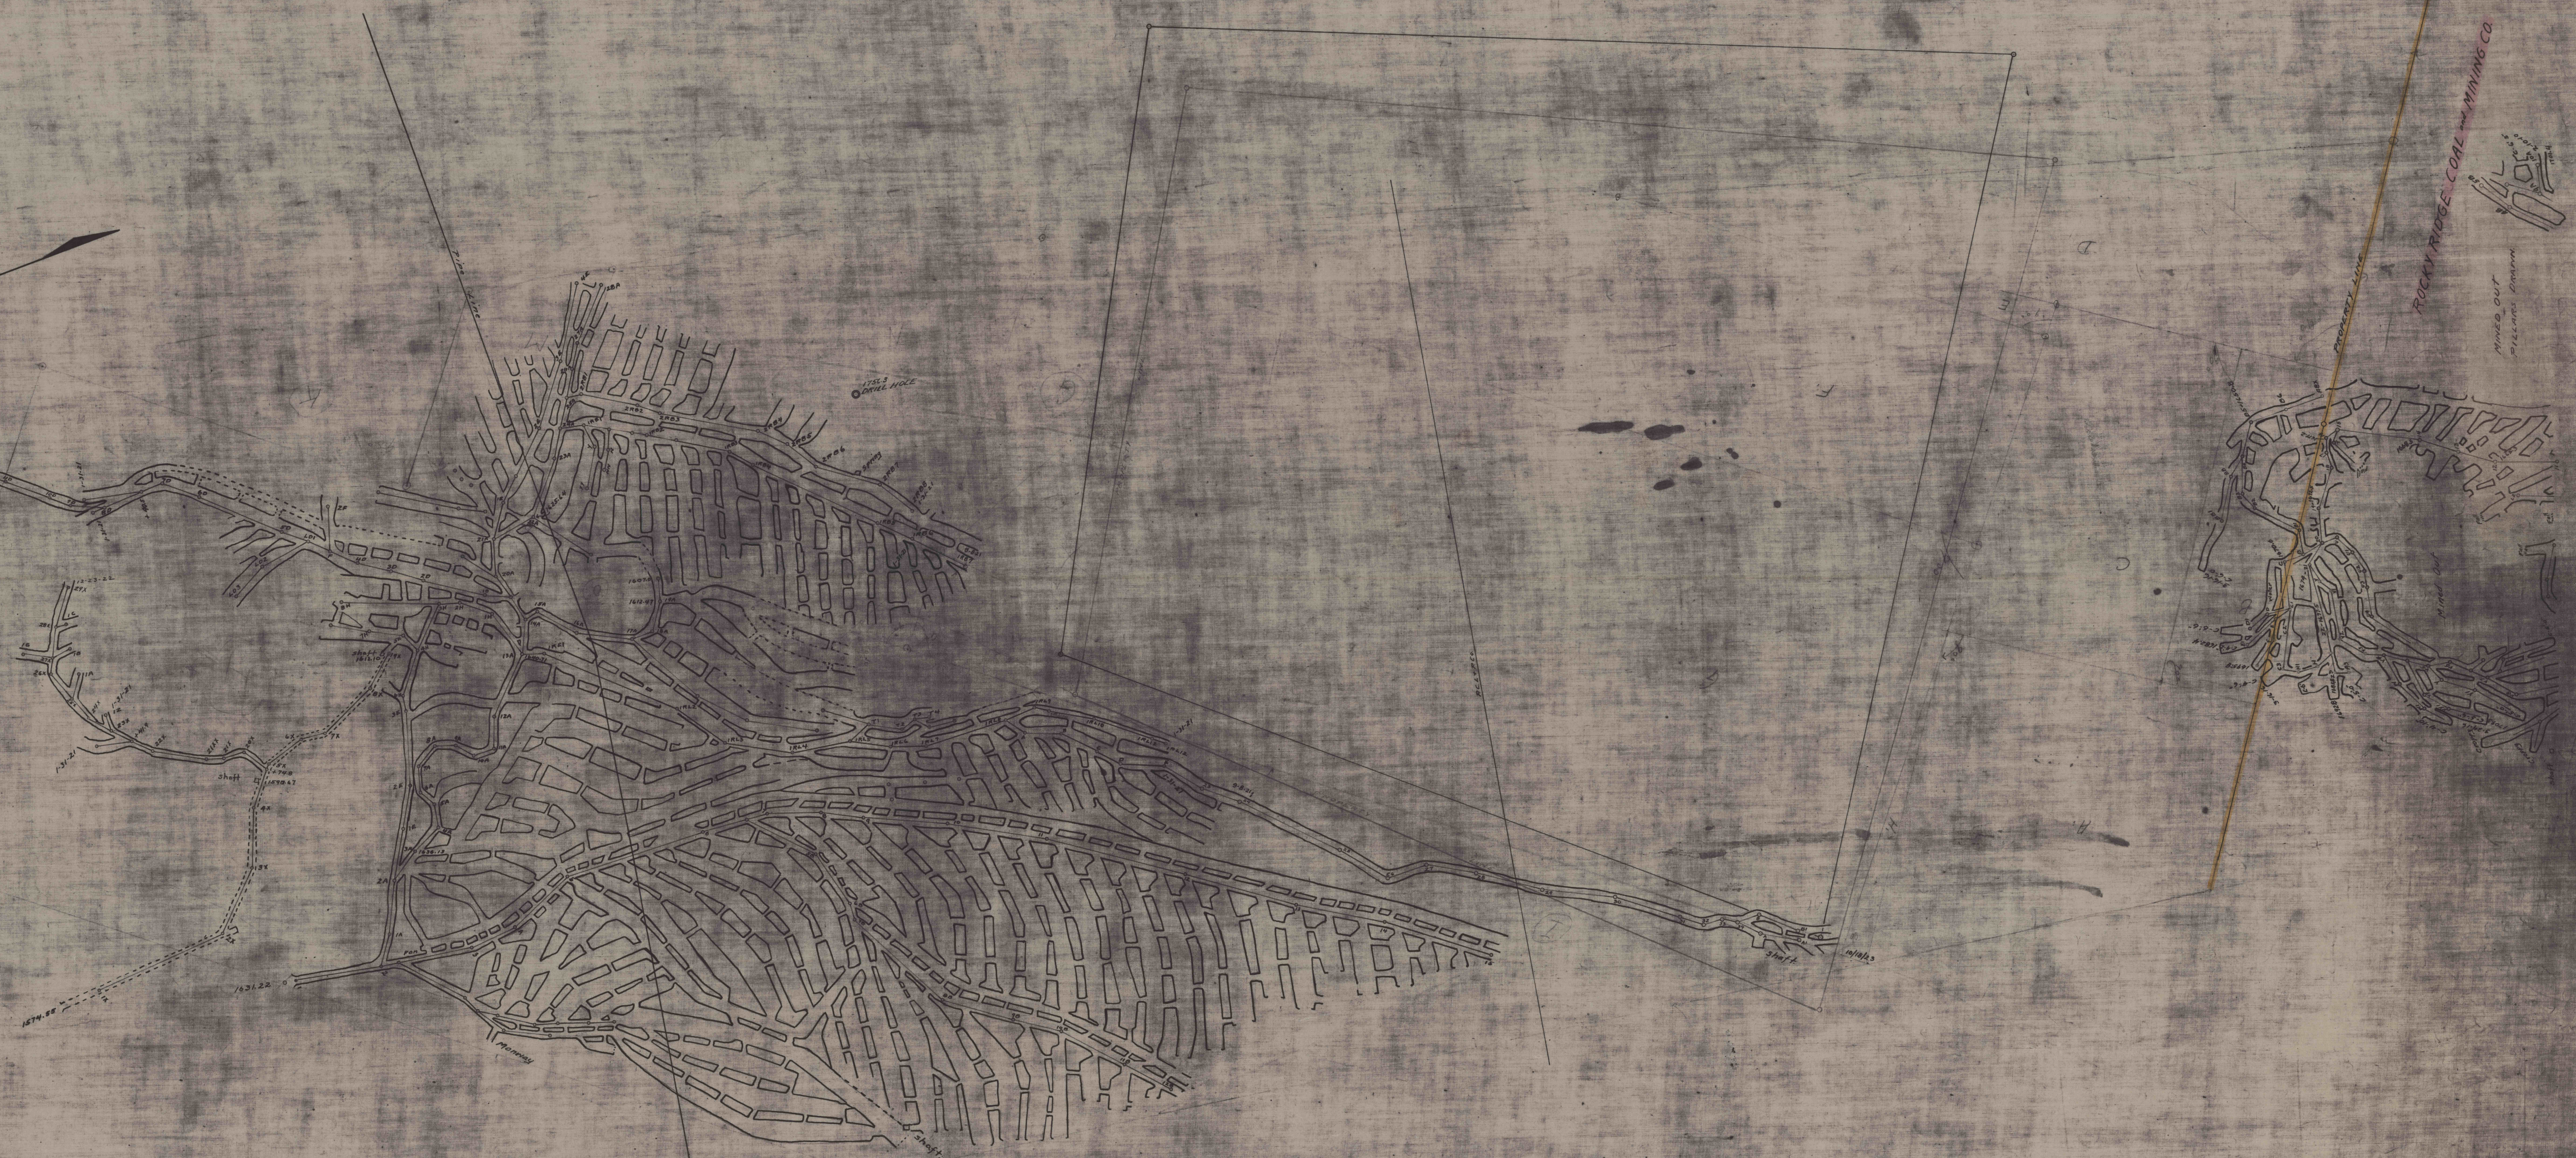

ROCKY RIDGE COAL MINING CO
MINES OUT
PITLAND COMPANY

Some of the shafts are not shown
on this map - some are not shown