

M A P GORDON MINE



OPERATED BY
EVERETT-SAXTON CO.

SITUATED IN
CARBON TOWNSHIP, HUNTINGDON CO.
BROADTOP TOWNSHIP, BEDFORD CO.

SCALE 1" = 100'

FULTON SEAM

REVISED

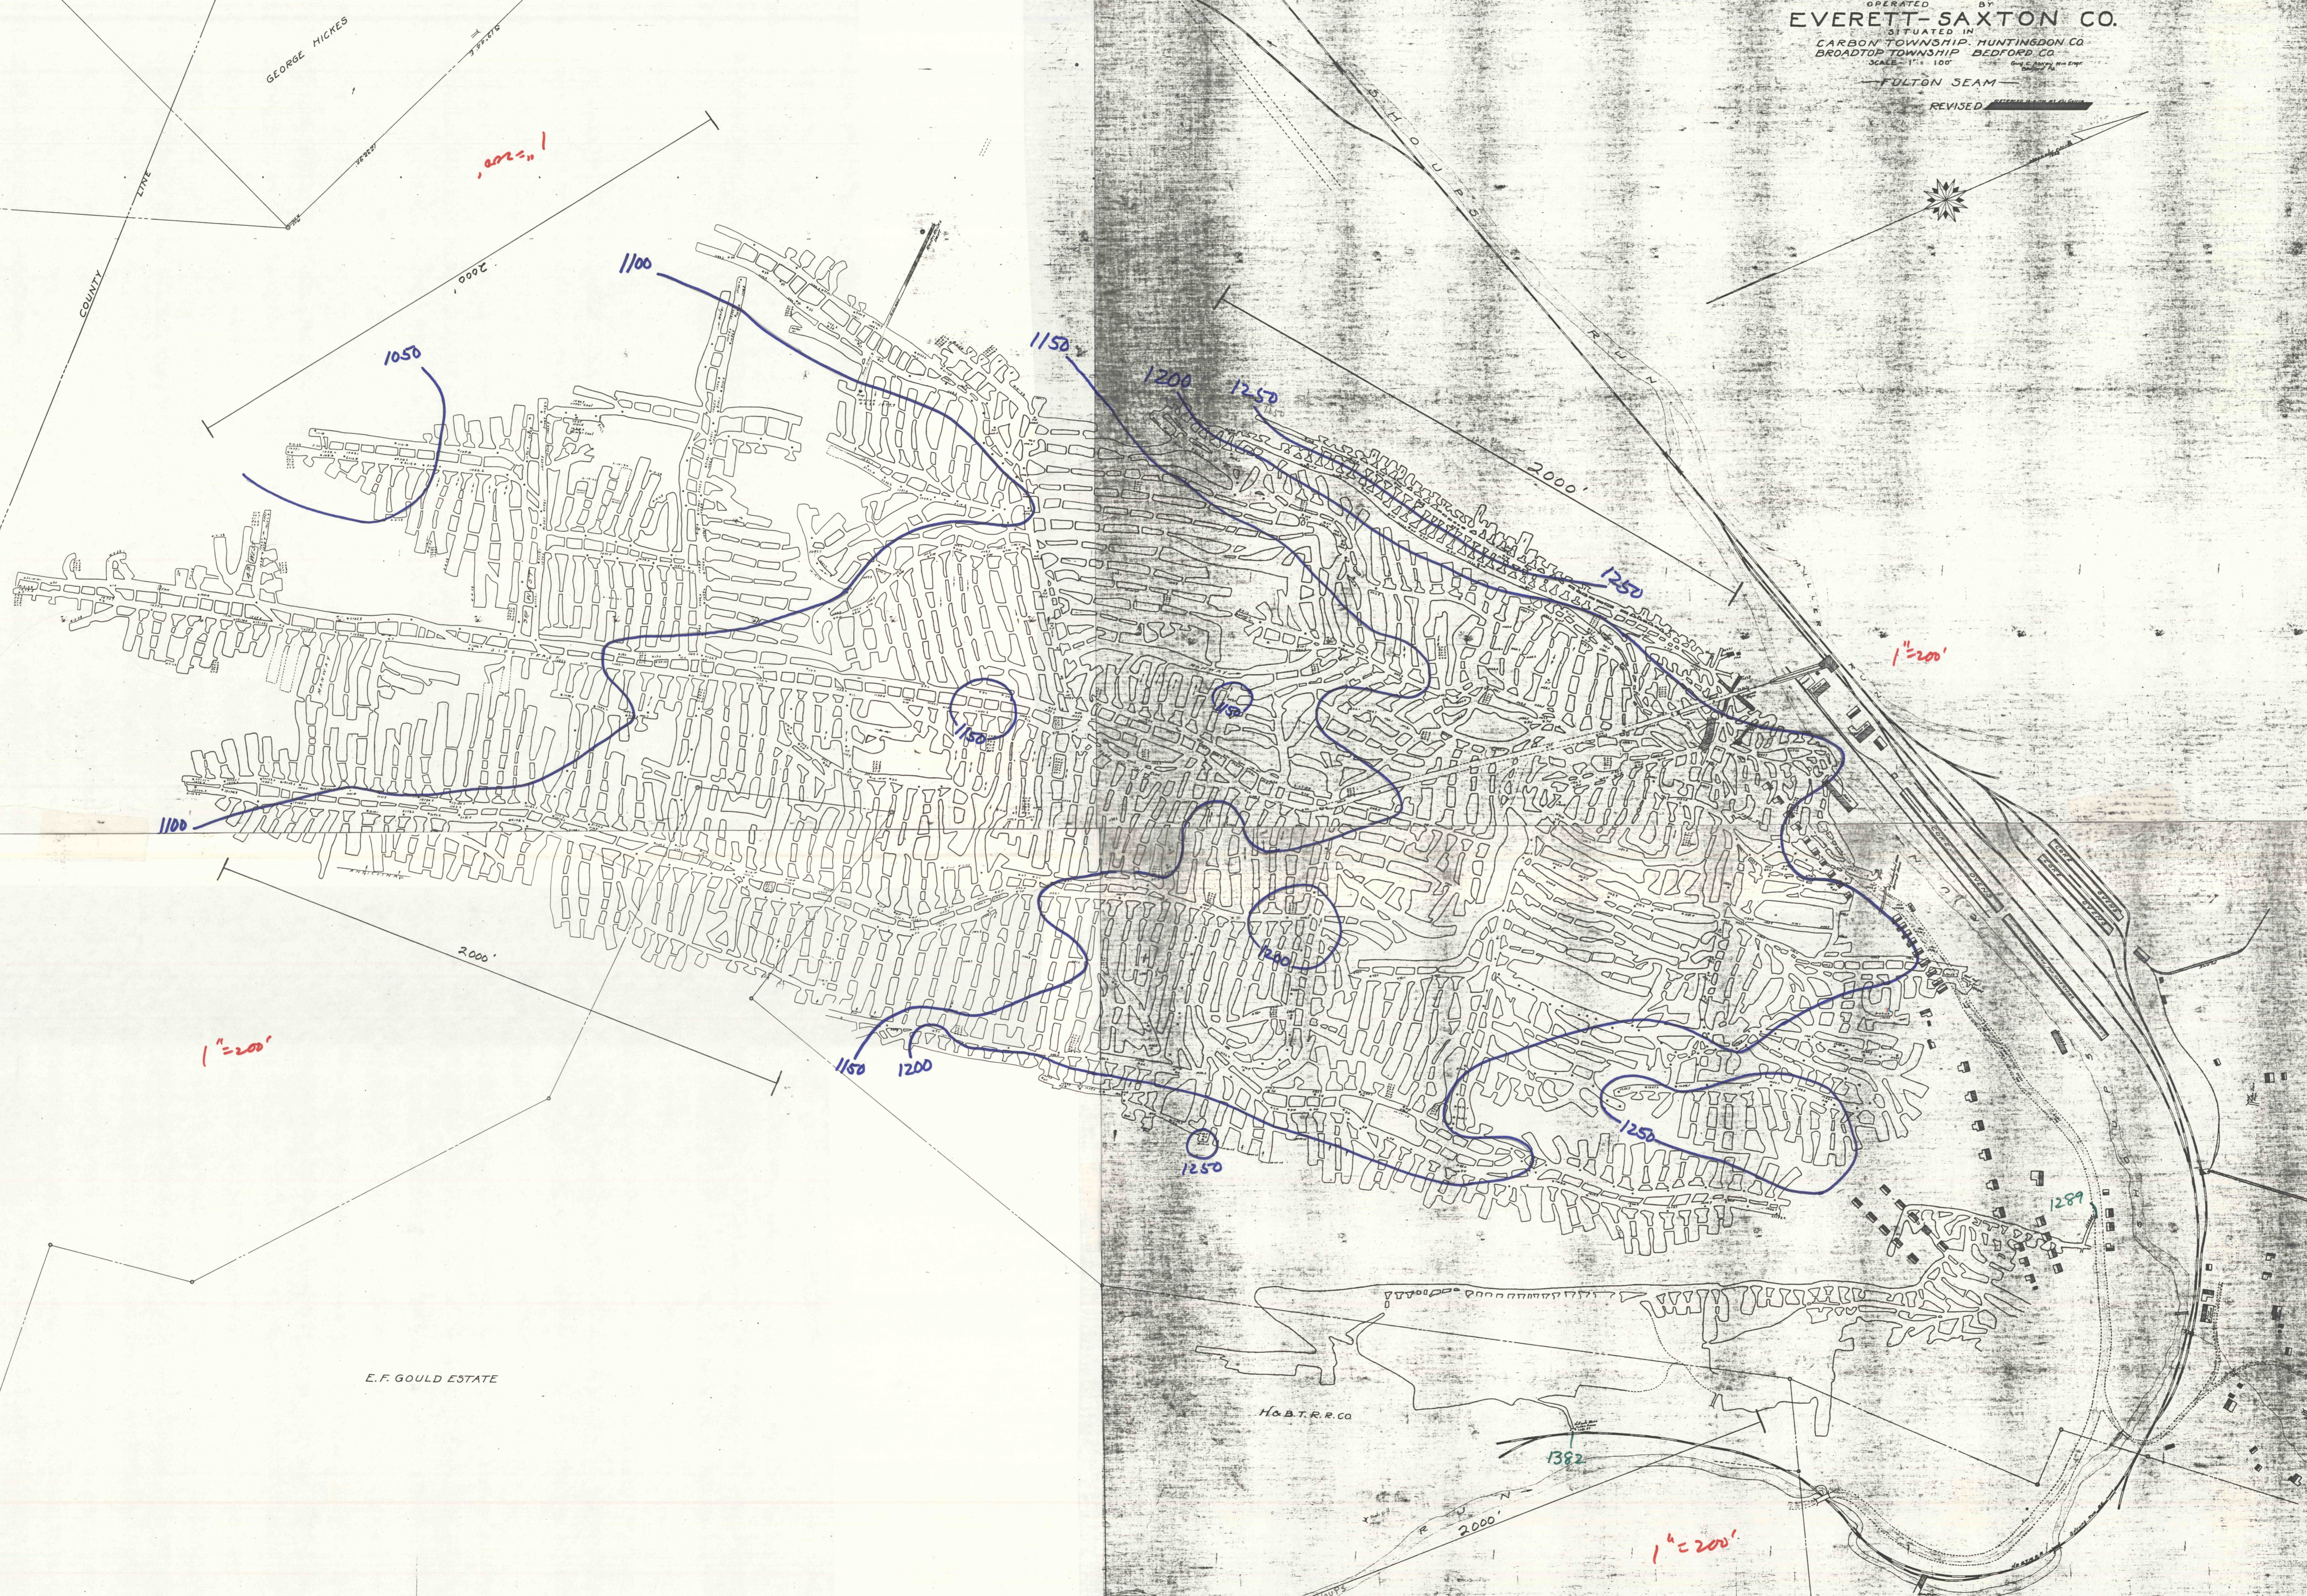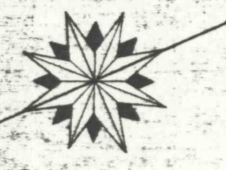

GEORGE HICKES

E. F. GOULD ESTATE

H. B. T. R. CO.

EVERETT-SAXTON CO.