

M A P OF GORDON MINE

OPERATED BY
EVERETT-SAXTON CO.


SITUATED IN
CARBON TOWNSHIP, HUNTINGDON CO.
BROADTOP TOWNSHIP, BEDFORD CO.

SCALE - 1" = 100'

Guy C. Askey Min Engr
Bedford Pa.

FULTON SEAM

REVISED ~~REVISION BY EL GORR~~

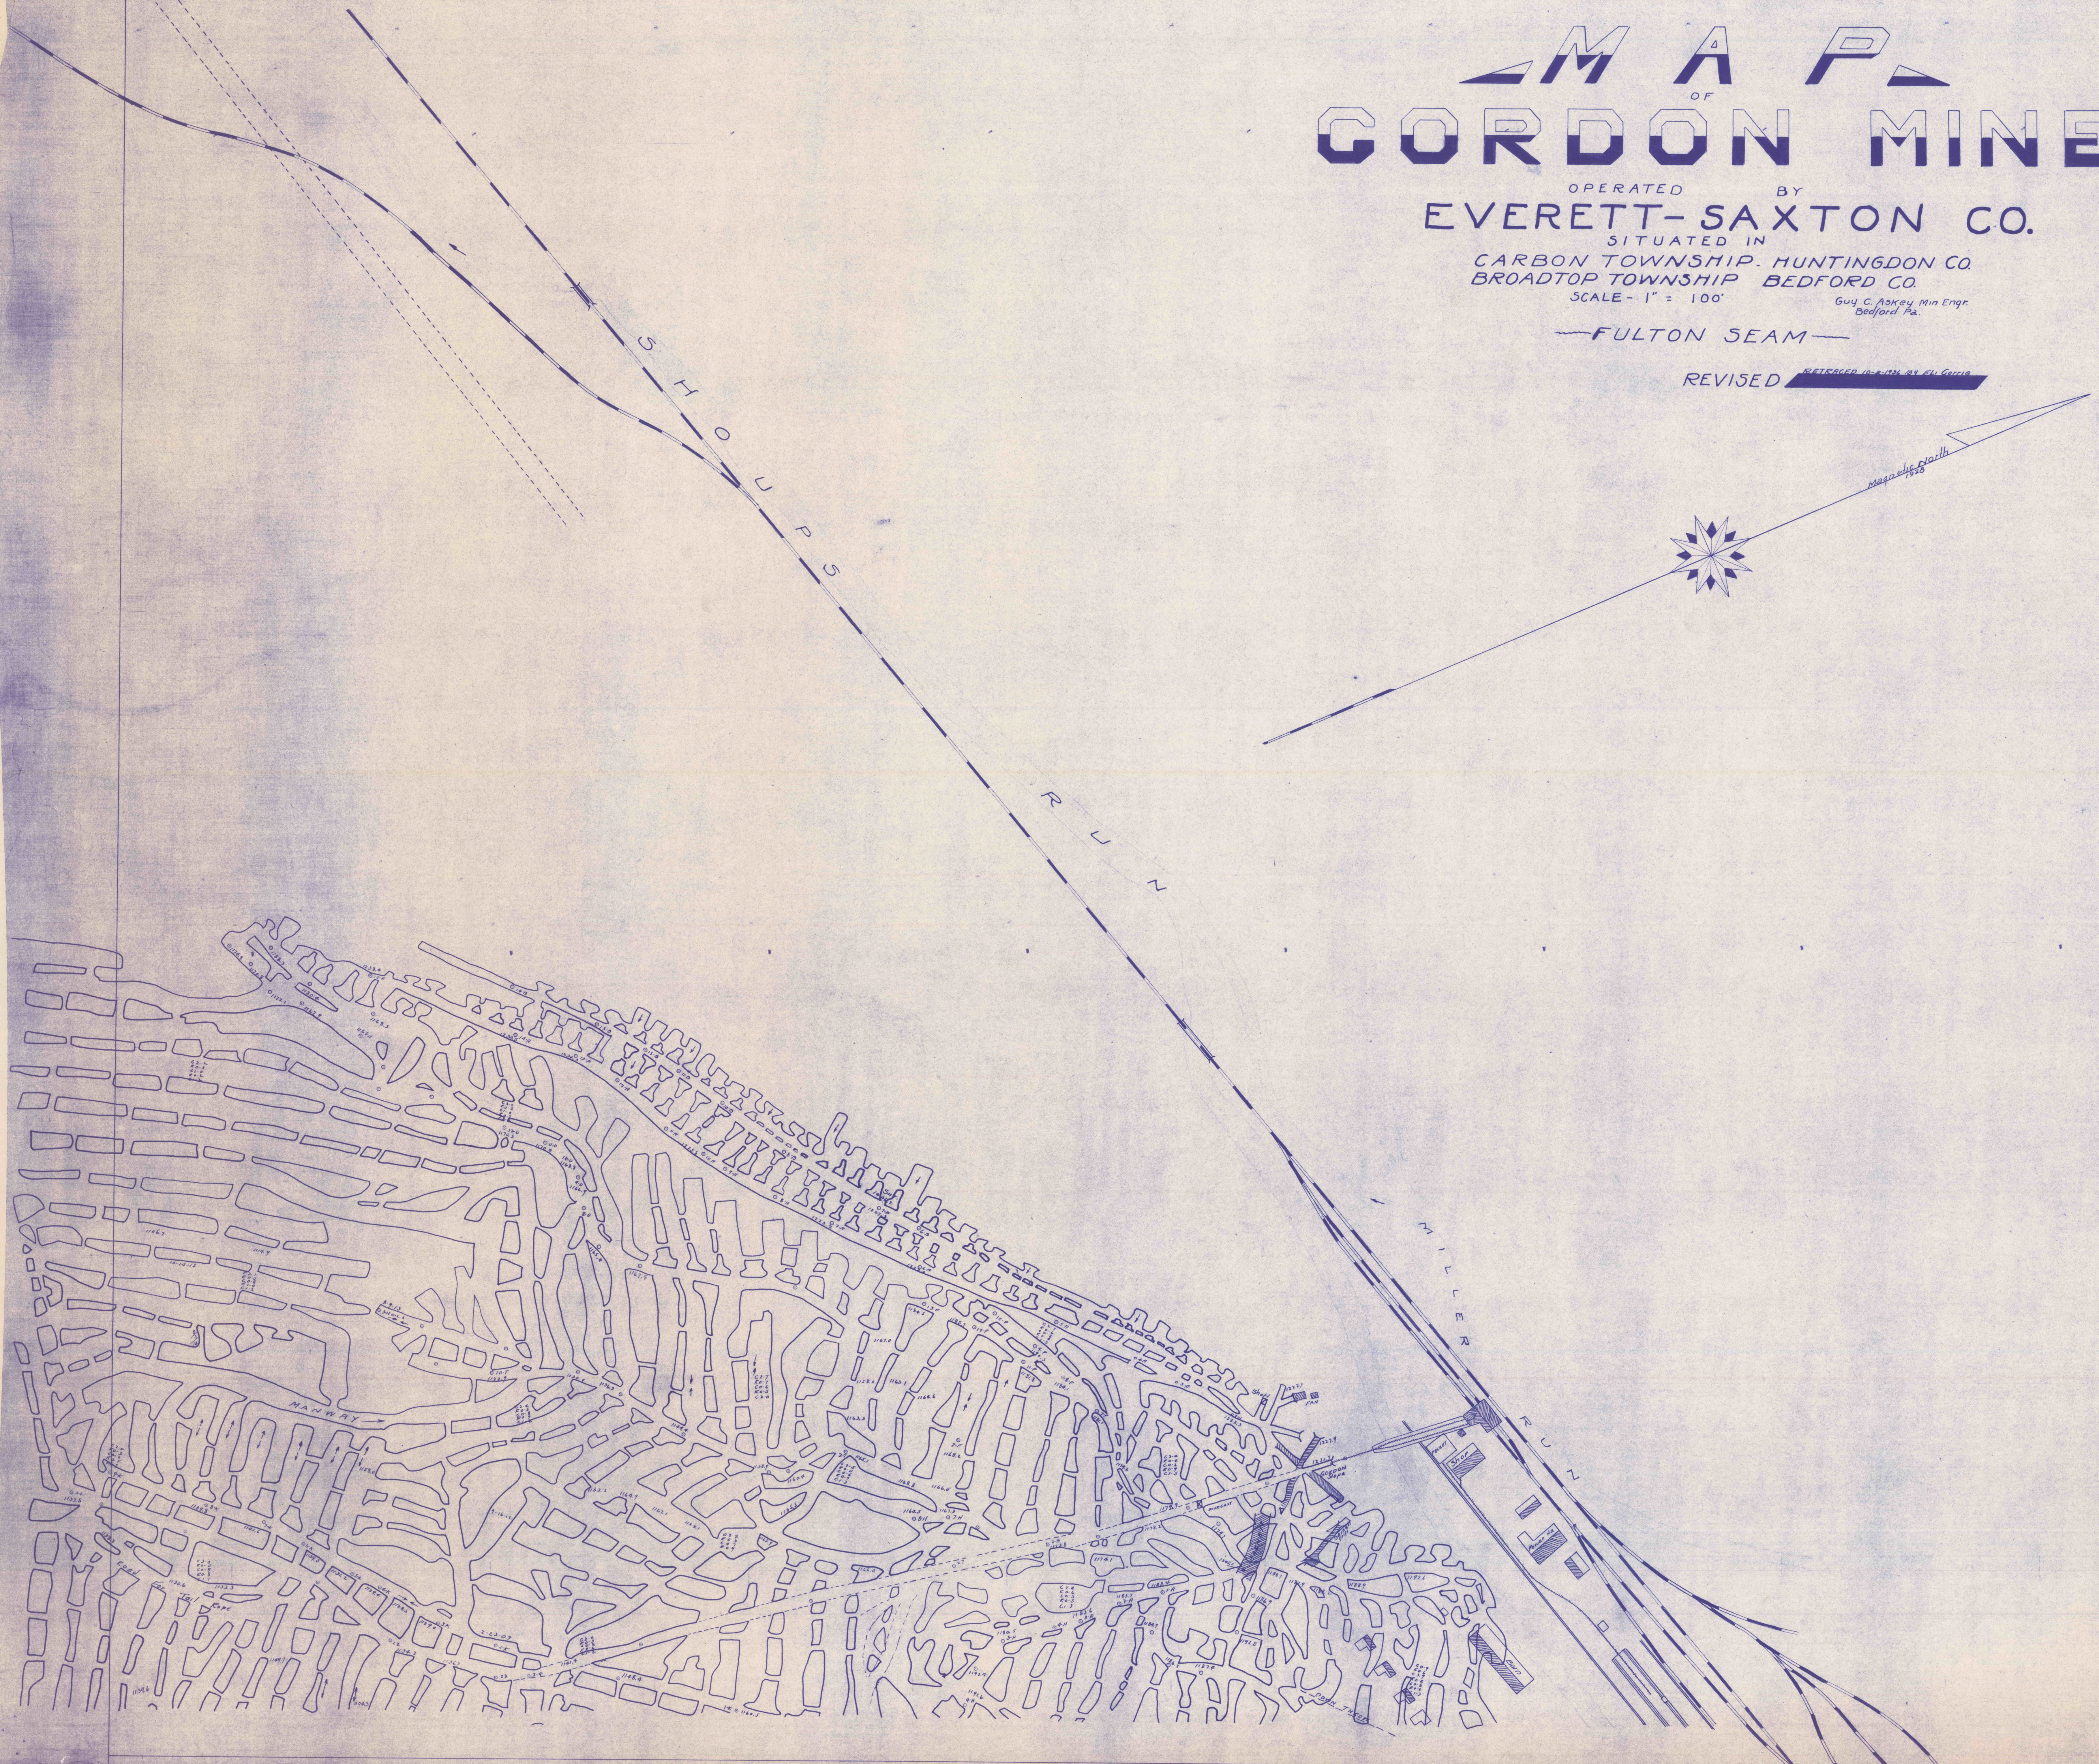

A-20, 21, 22