


JAMES GRAHAM

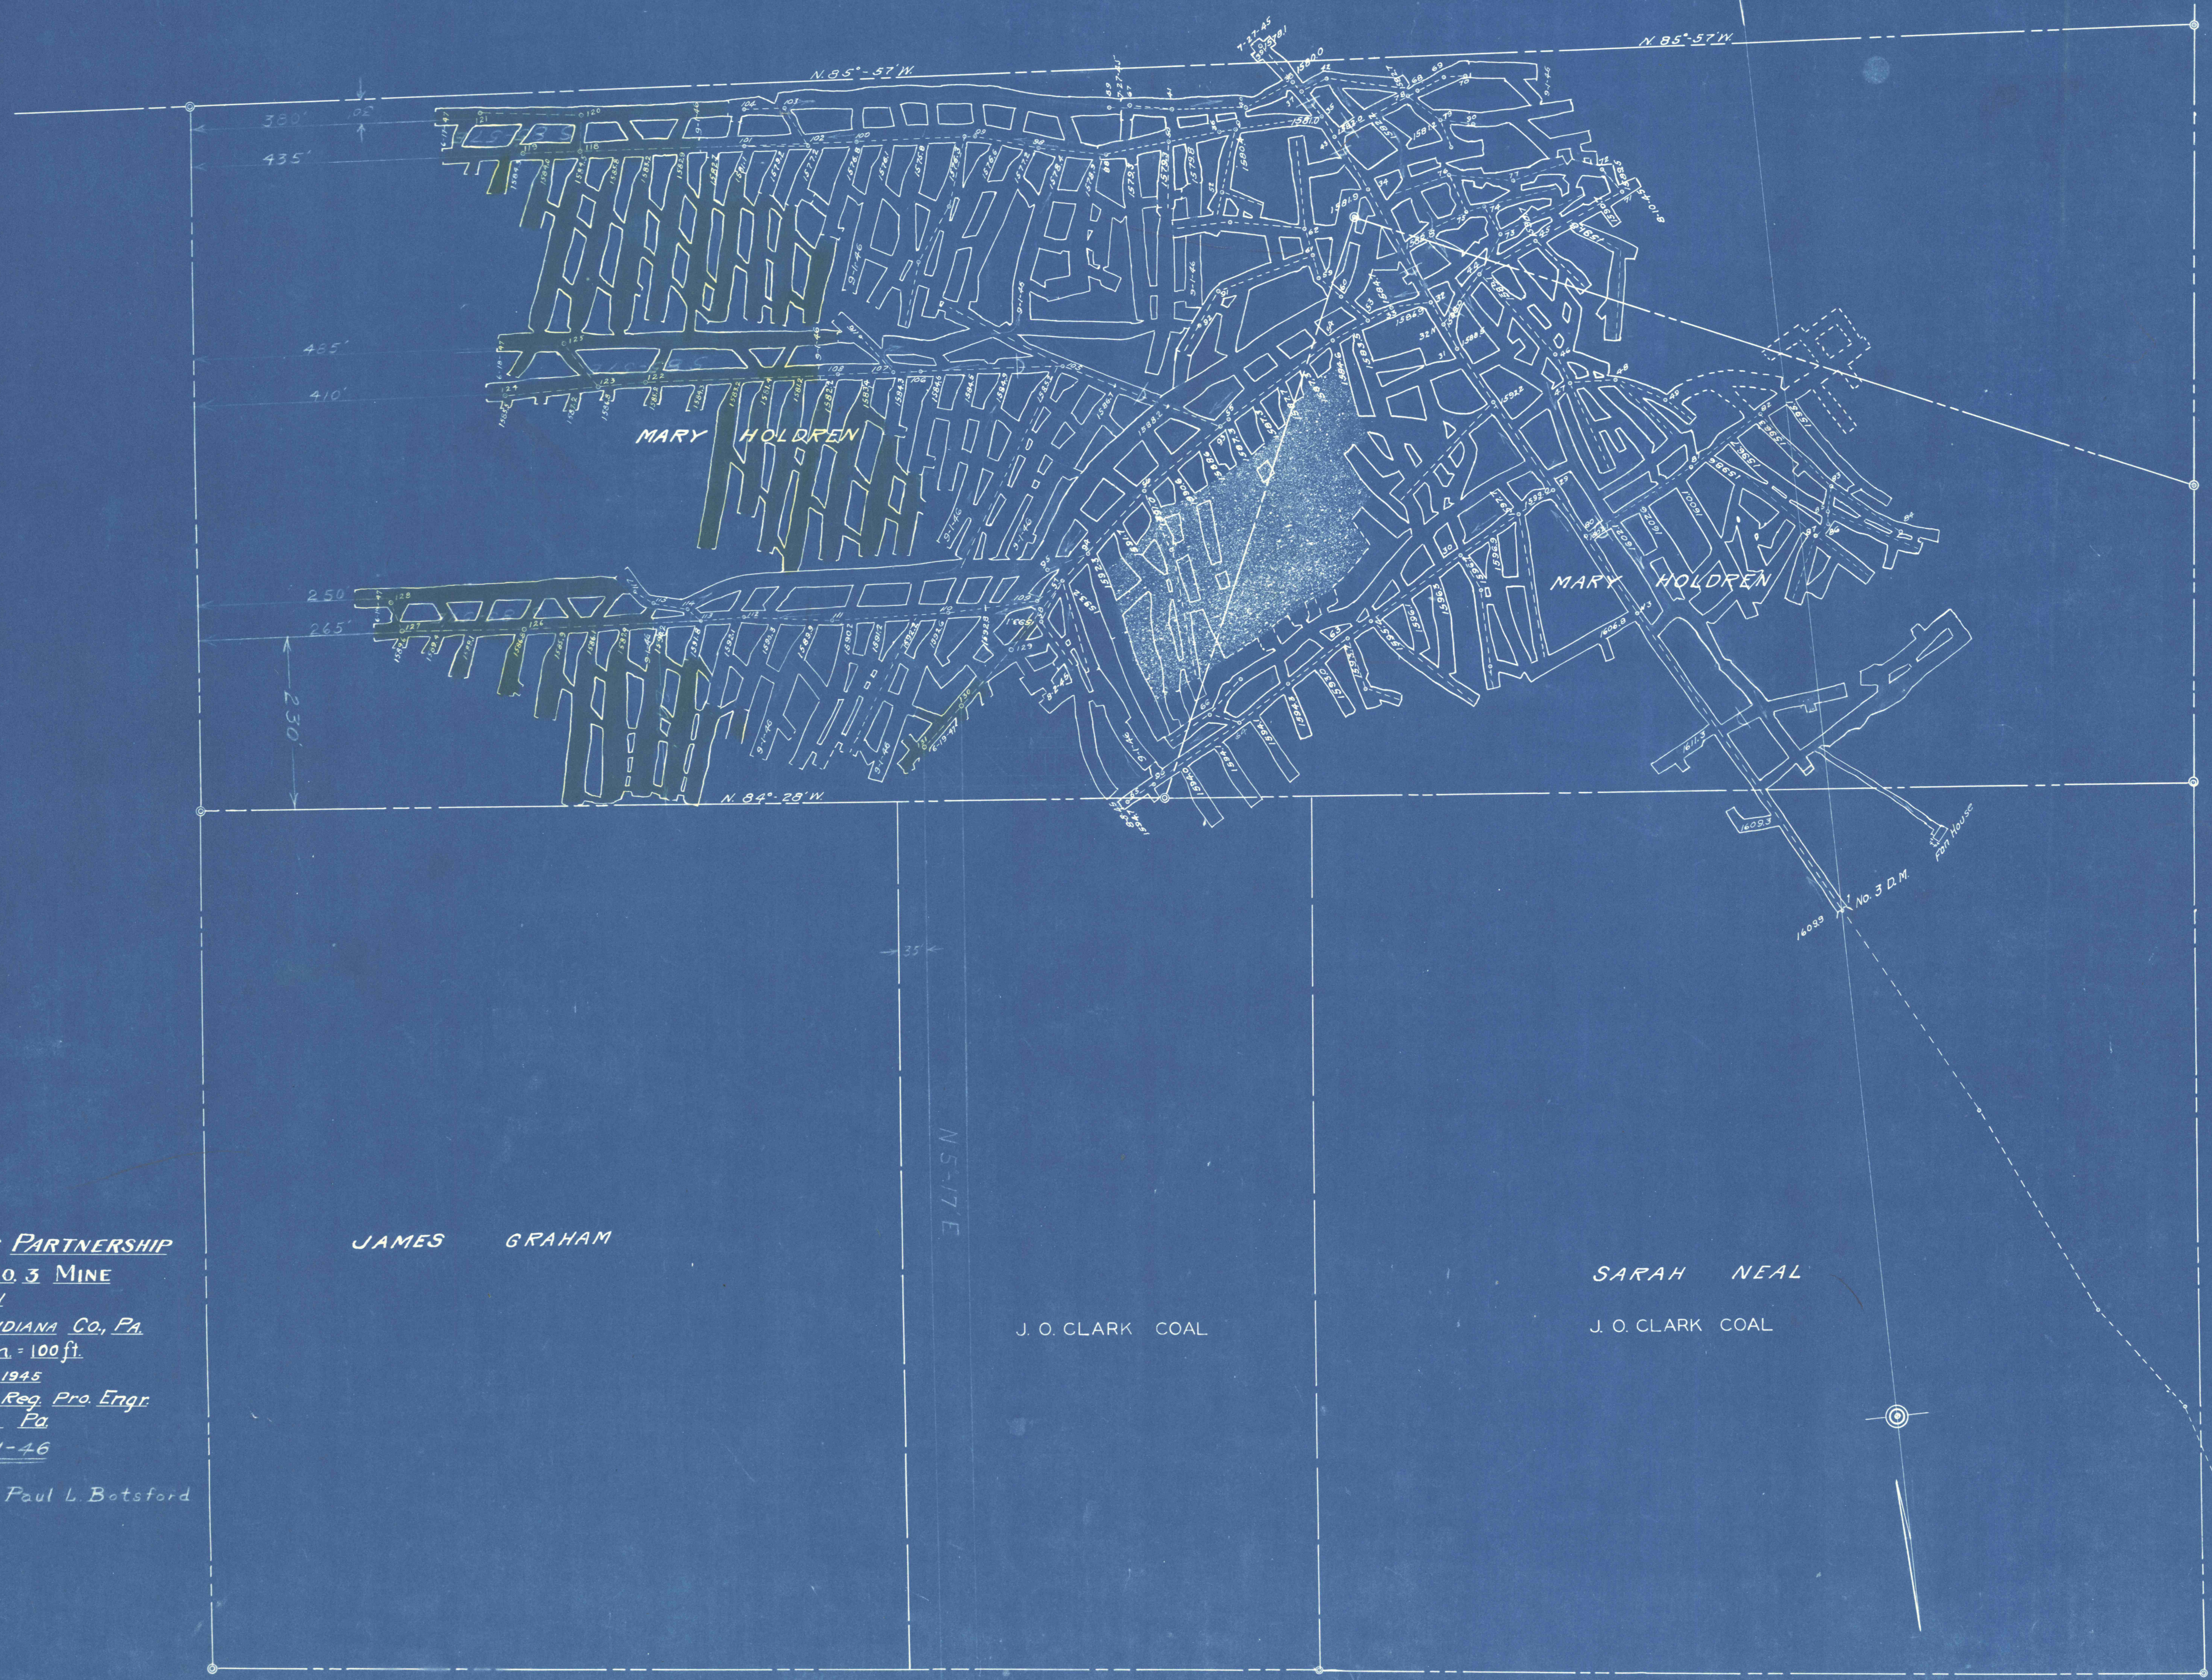

J. O. CLARK HEIRS PARTNERSHIP

MAP OF NO. 3 MINE

IN

BANKS TWP, INDIANA CO., PA.

Scale: 1 in. = 100 ft.

Sept, 1945

Thomas Peeler, Reg. Prof. Engr.
Indiana, Pa.

Posted 9-1-46

Posted 6-19-47 Paul L. Botsford

JAMES GRAHAM

J. O. CLARK COAL

SARAH NEAL

J. O. CLARK COAL