


14-211

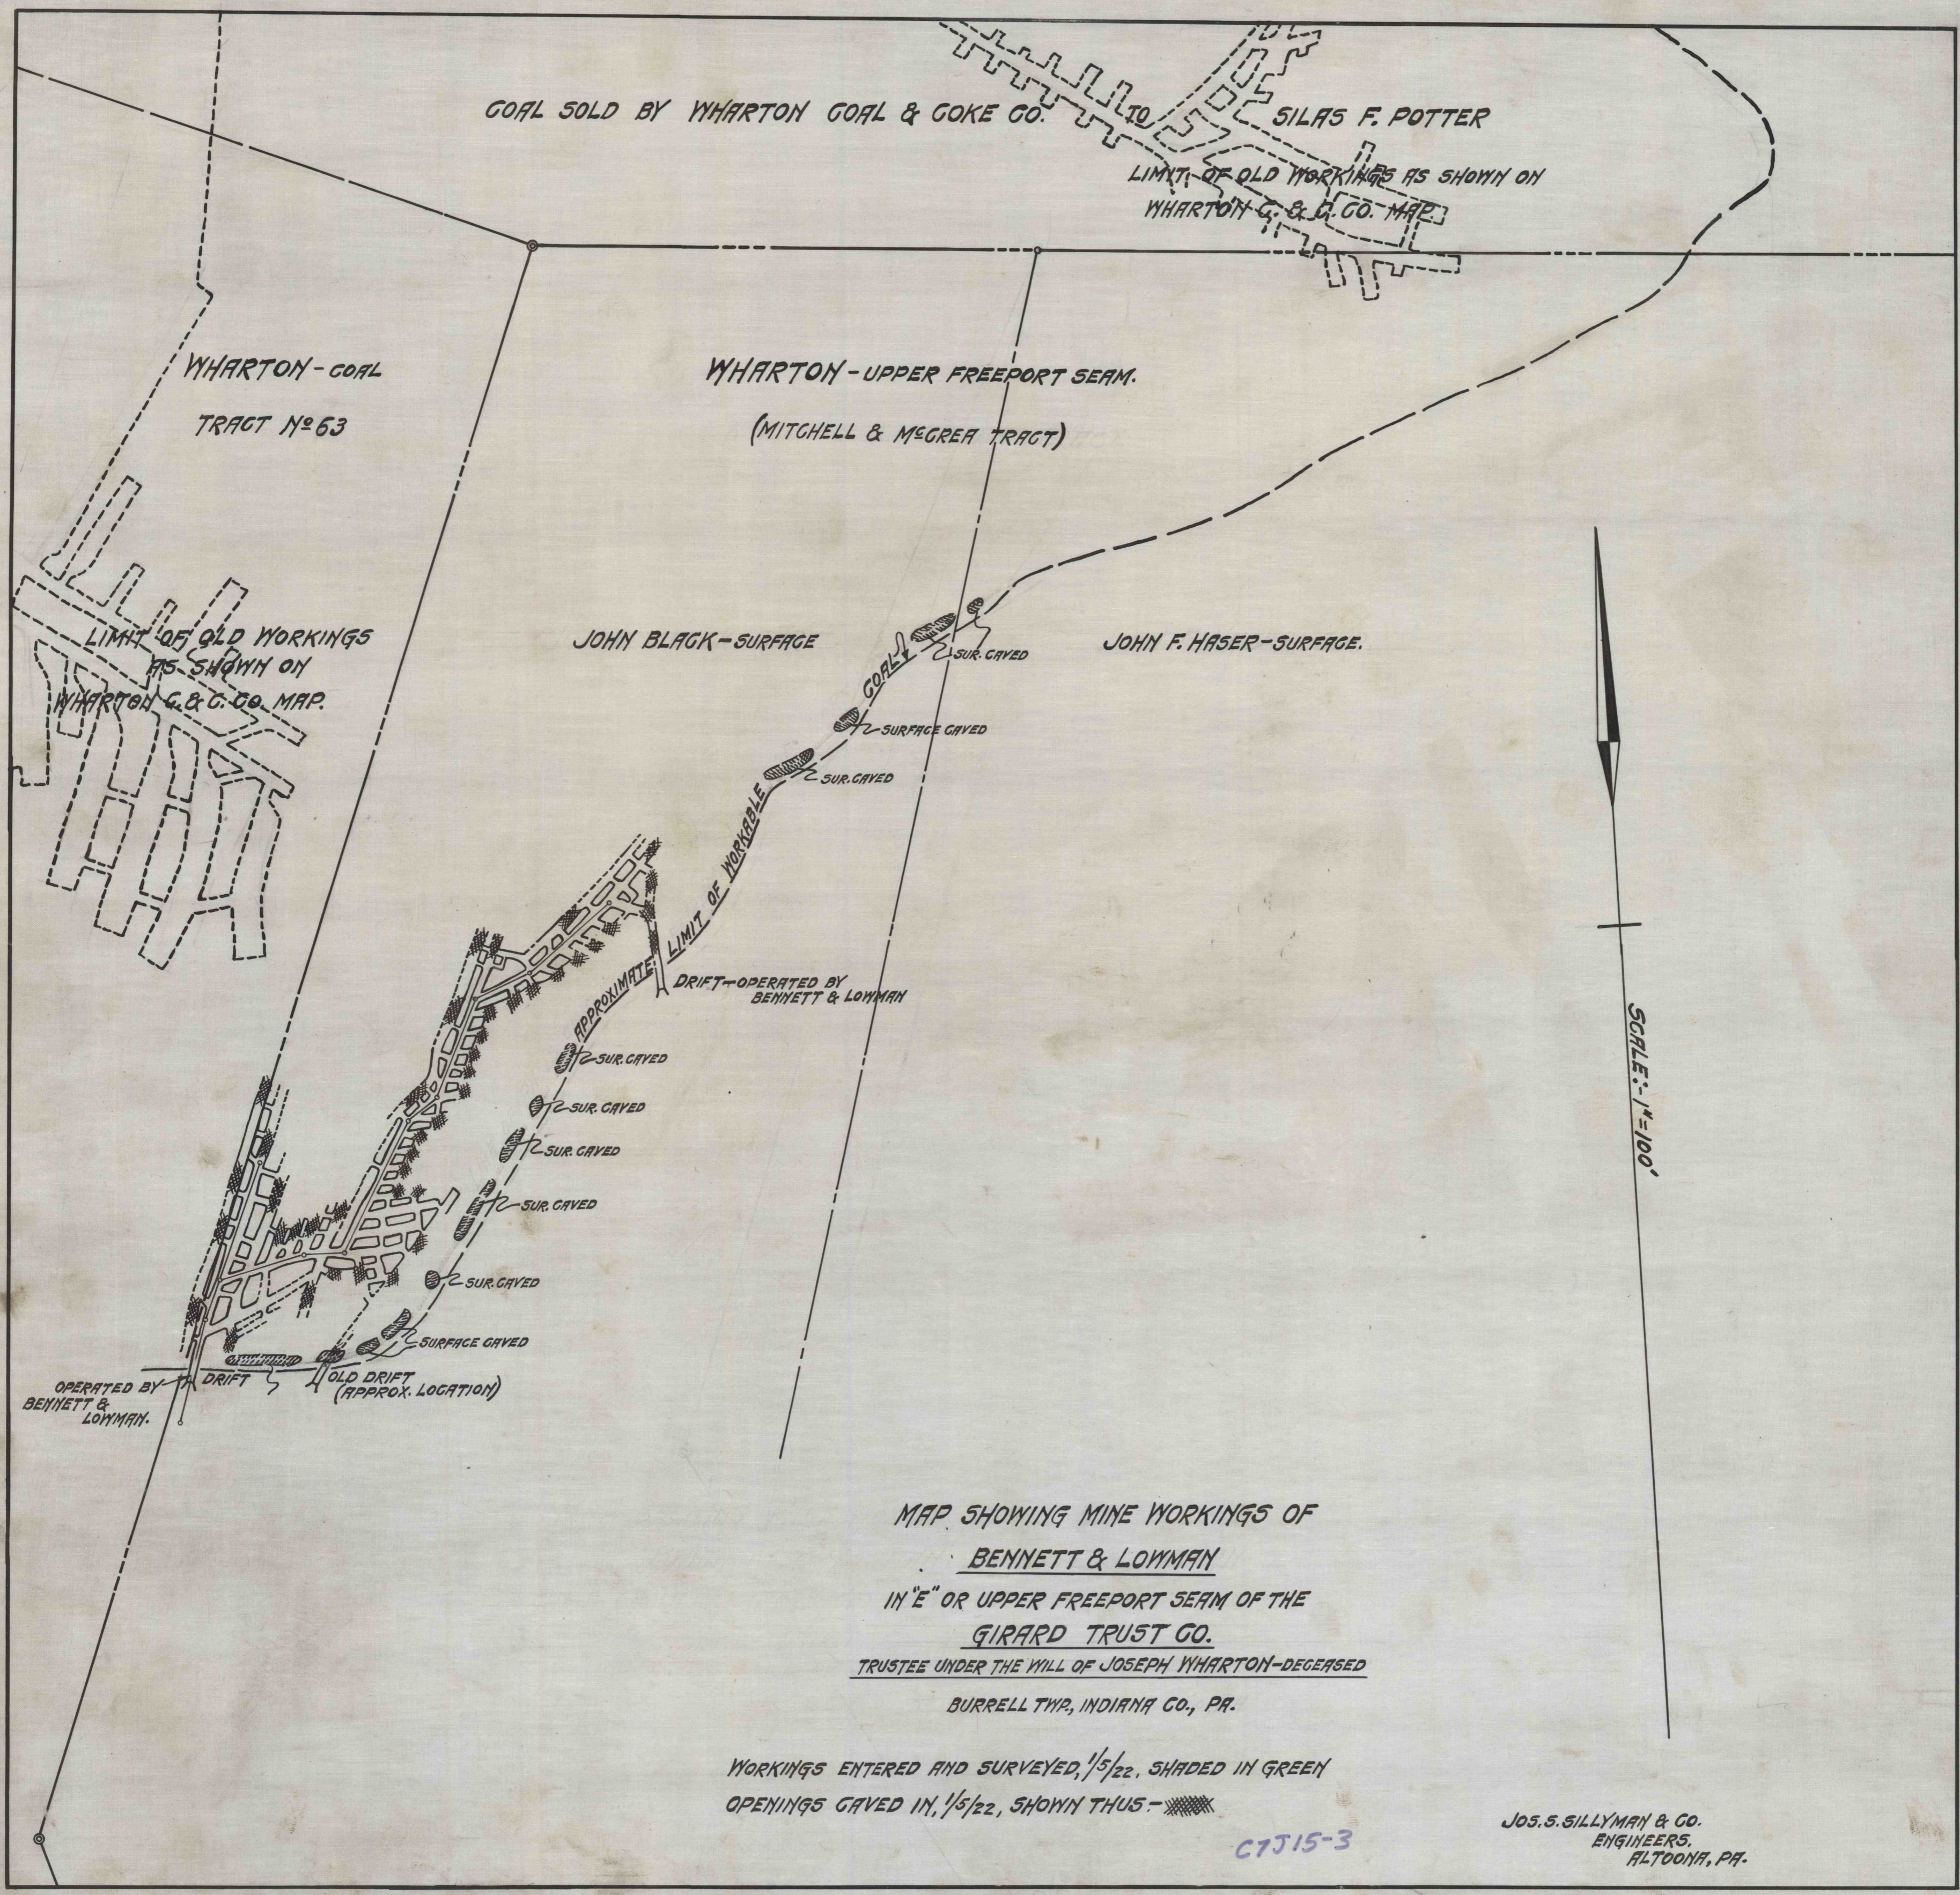

COAL SOLD BY WHARTON COAL & COKE CO. TO SILAS F. POTTER

LIMIT OF OLD WORKINGS AS SHOWN ON WHARTON G. & G. CO. MAP.

WHARTON-COAL TRACT No 63

WHARTON-UPPER FREEPORT SEAM. (MITCHELL & MCGREA TRACT)

LIMIT OF OLD WORKINGS AS SHOWN ON WHARTON G. & G. CO. MAP.

JOHN BLACK-SURFACE

JOHN F. HASER-SURFACE.

DRIFT-OPERATED BY BENNETT & LOWMAN

SCALE: 1"=100'

MAP SHOWING MINE WORKINGS OF
BENNETT & LOWMAN
 IN "E" OR UPPER FREEPORT SEAM OF THE
GIRARD TRUST CO.
 TRUSTEE UNDER THE WILL OF JOSEPH WHARTON-DECEASED
 BURRELL TWP, INDIANA CO., PA.

WORKINGS ENTERED AND SURVEYED, 1/5/22, SHADED IN GREEN
 OPENINGS CAVED IN, 1/5/22, SHOWN THUS: [hatched symbol]

C7J15-3

JOS. S. SILLYMAN & CO.
 ENGINEERS.
 ALTOONA, PA.

Bennett & Lowman
 Engineers
 Altoona, Pa.