



1070
460
610

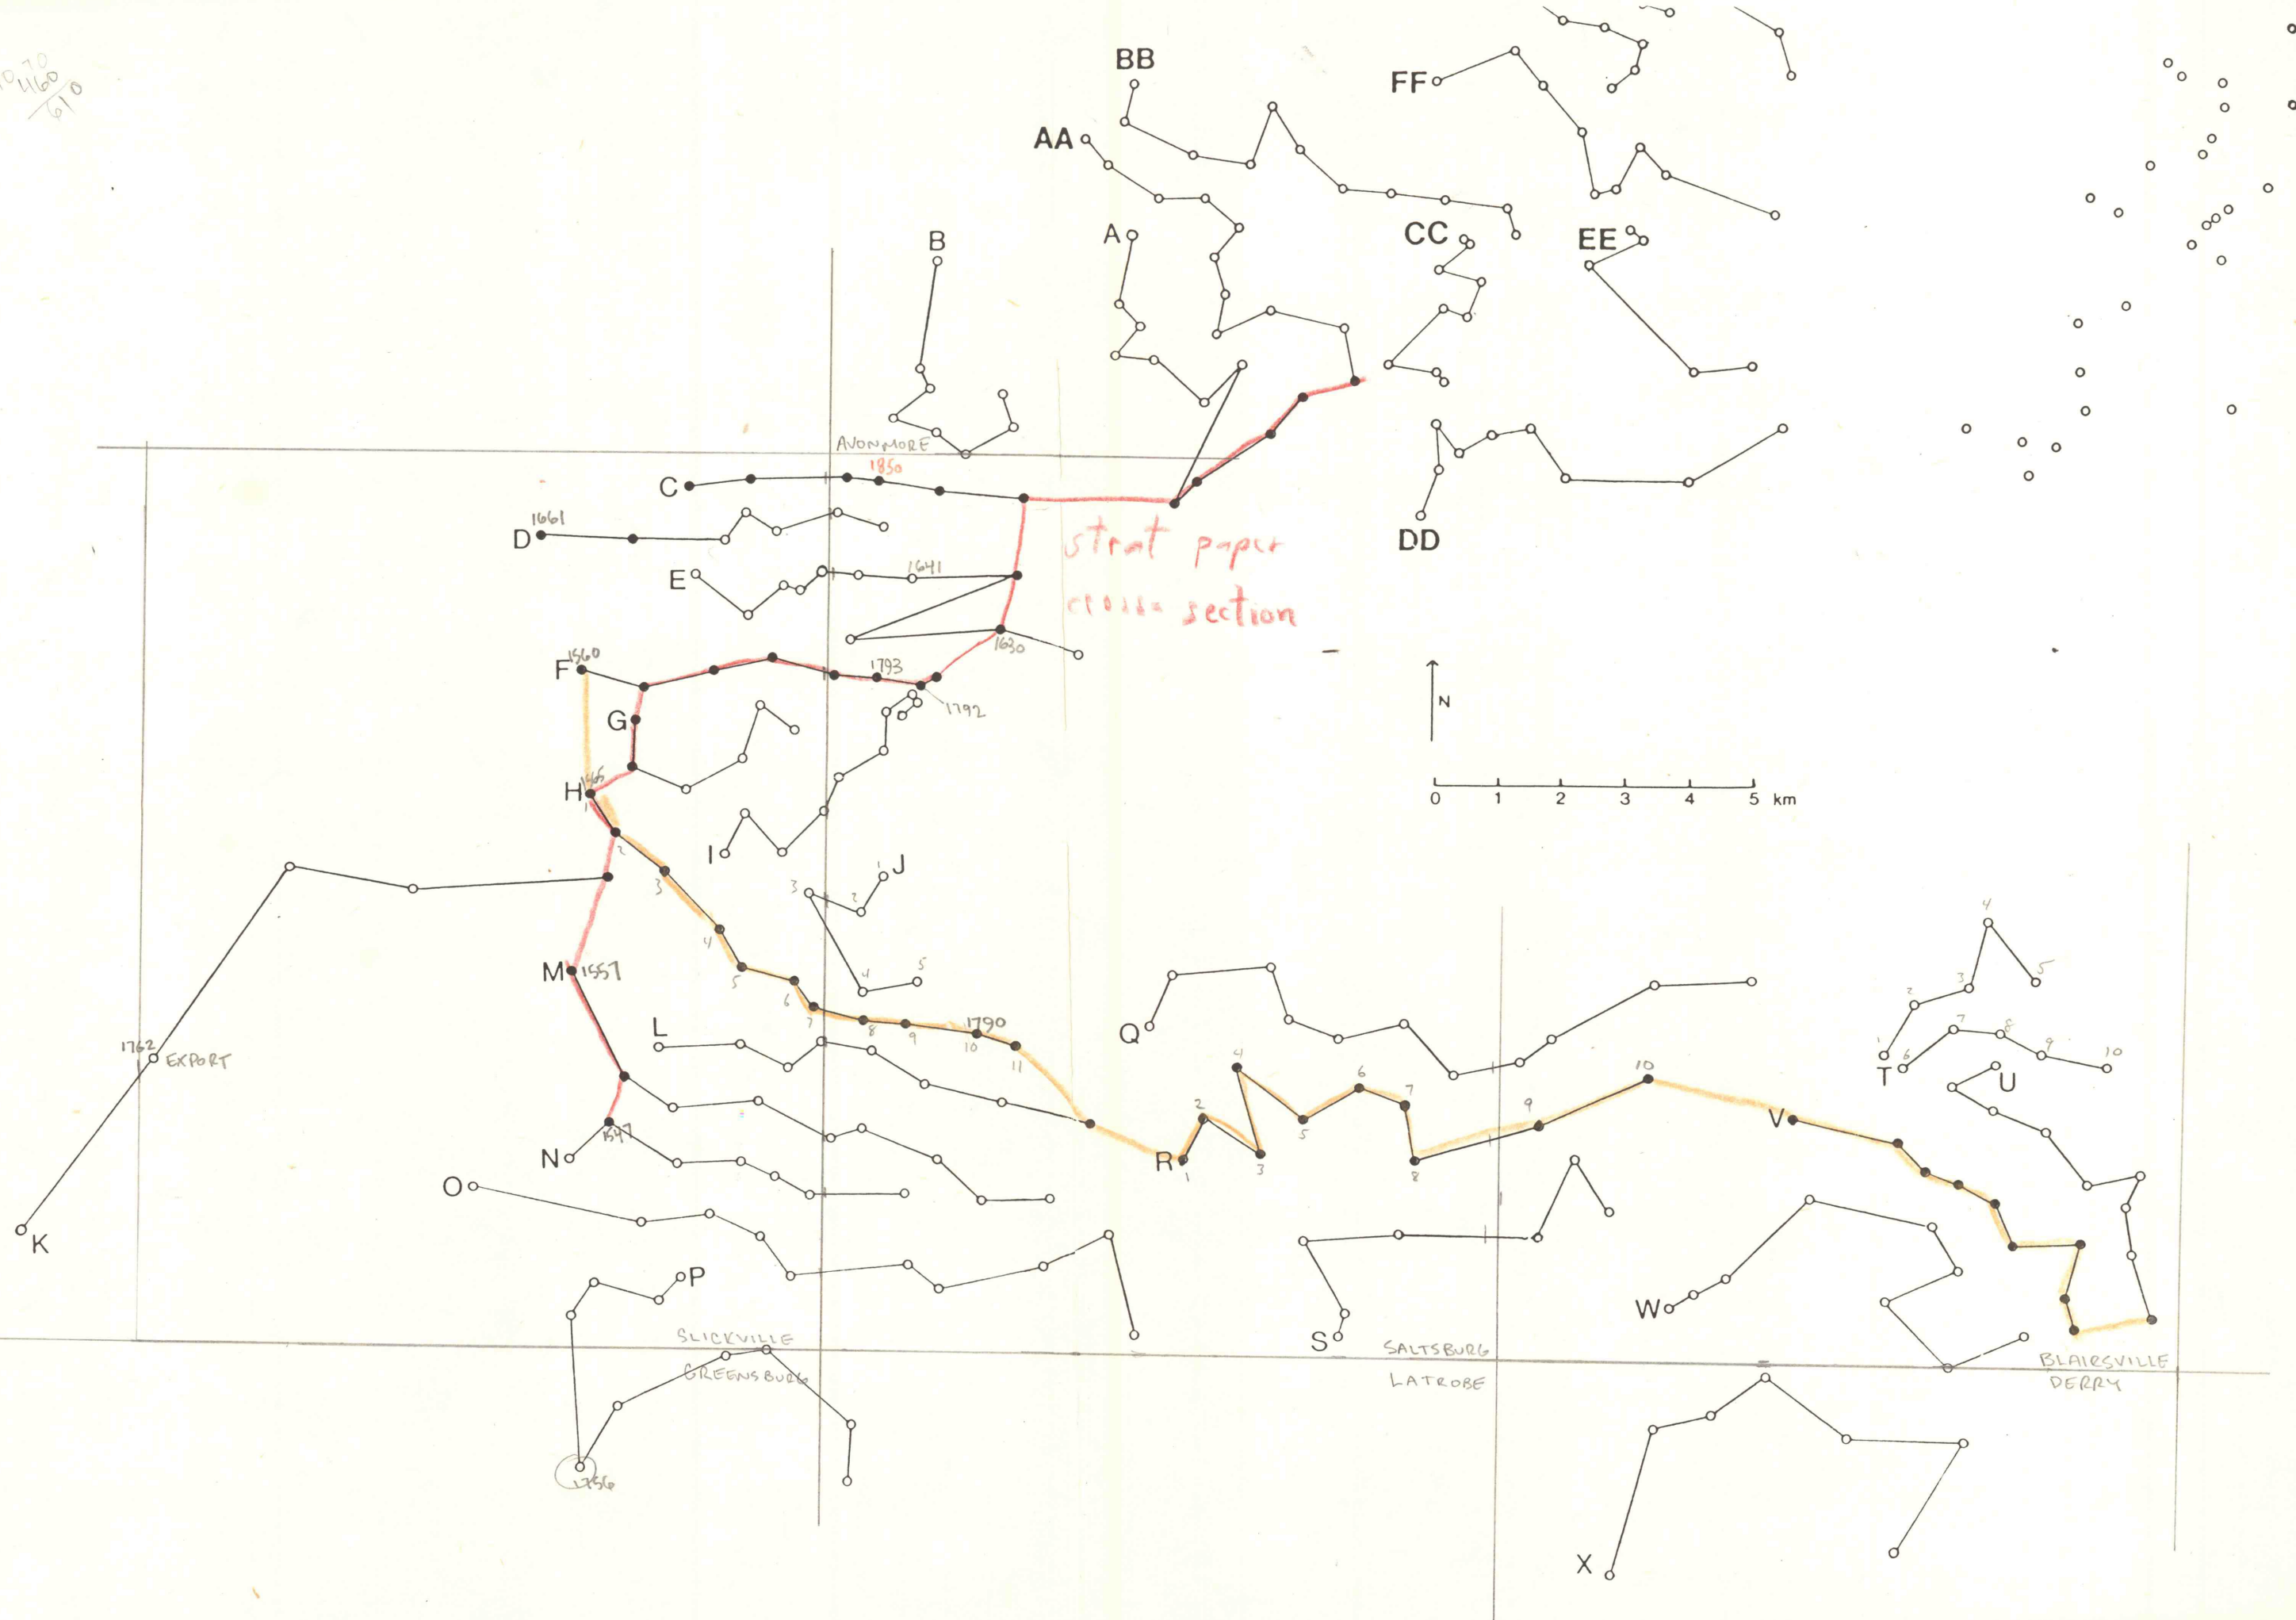

AVONMORE
1850

strat paper
cross section

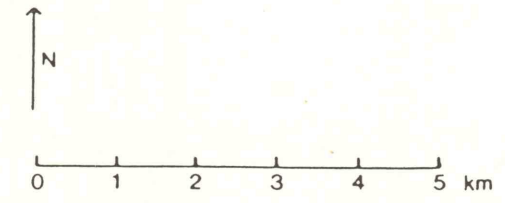

EXPORT
1762

SLICKVILLE
GREENSBURG

SALTSBURG
LATROBE

BLAIRSVILLE
DERRY

M
1551

1790

D
1661

1793

1792

1641

1630

N
1647

1756

K

R
1

2

3

4

5

6

7

8

9

10

11

C

E

F
1660

G

H

L

O

P

AA

A

B

BB

FF

CC

EE

DD

Q

1

2

3

4

5

6

7

8

9

10

11

W

S

T

1

2

3

4

5

6

7

8

9

10

U

1

2

3

4

5

6

7

8

9

10

BLAIRSVILLE
DERRY

X