


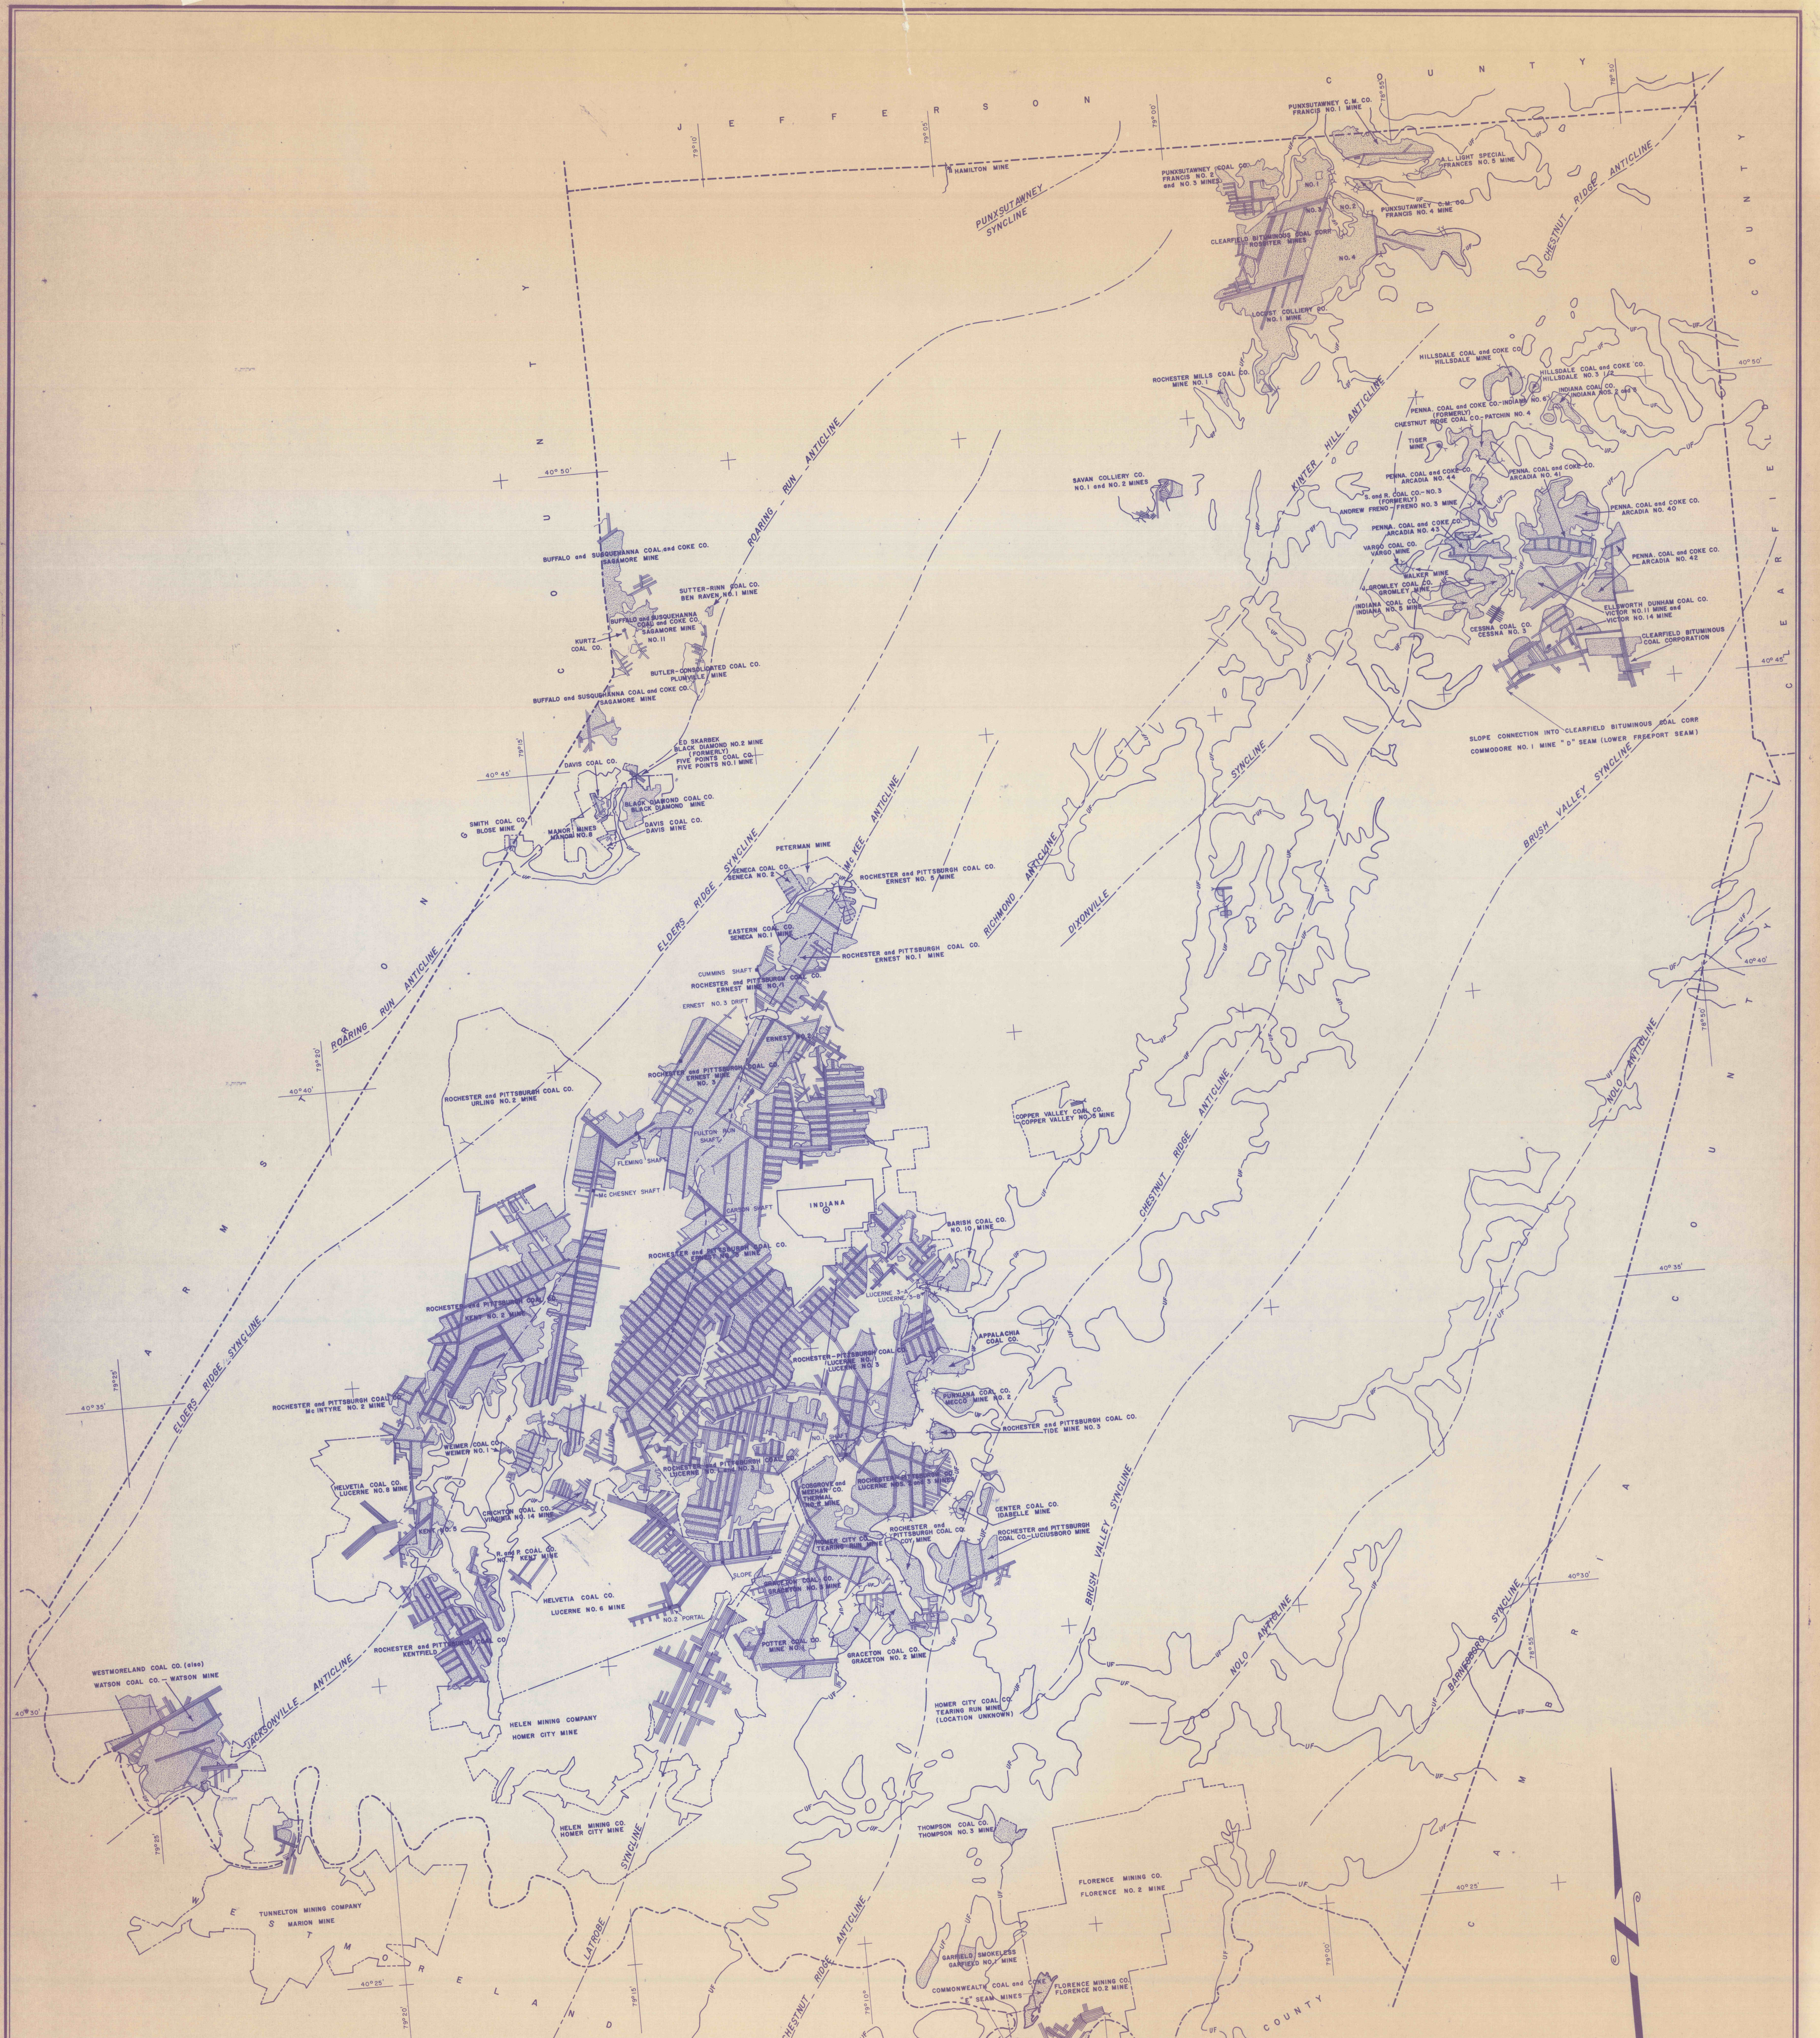

COMMONWEALTH OF PENNSYLVANIA
DEPARTMENT OF ENVIRONMENTAL RESOURCES
BUREAU OF LAND PROTECTION
DIVISION OF MINE SUBSIDENCE REGULATION
MINE MAP
OF
INDIANA COUNTY
MAY-1977 JSO

MINING COMPLETED AREAS
UPPER FREEPORT "D" COAL SEAM

SCALE
0 1 2 Miles