



DAN*283
SURV. 11/22/56
125 DEEP
100' DIA.

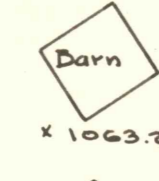

MOBLE WITH
BLISS



DAN*281
SURV. 11/22/56
Coal: 781.55+0.16

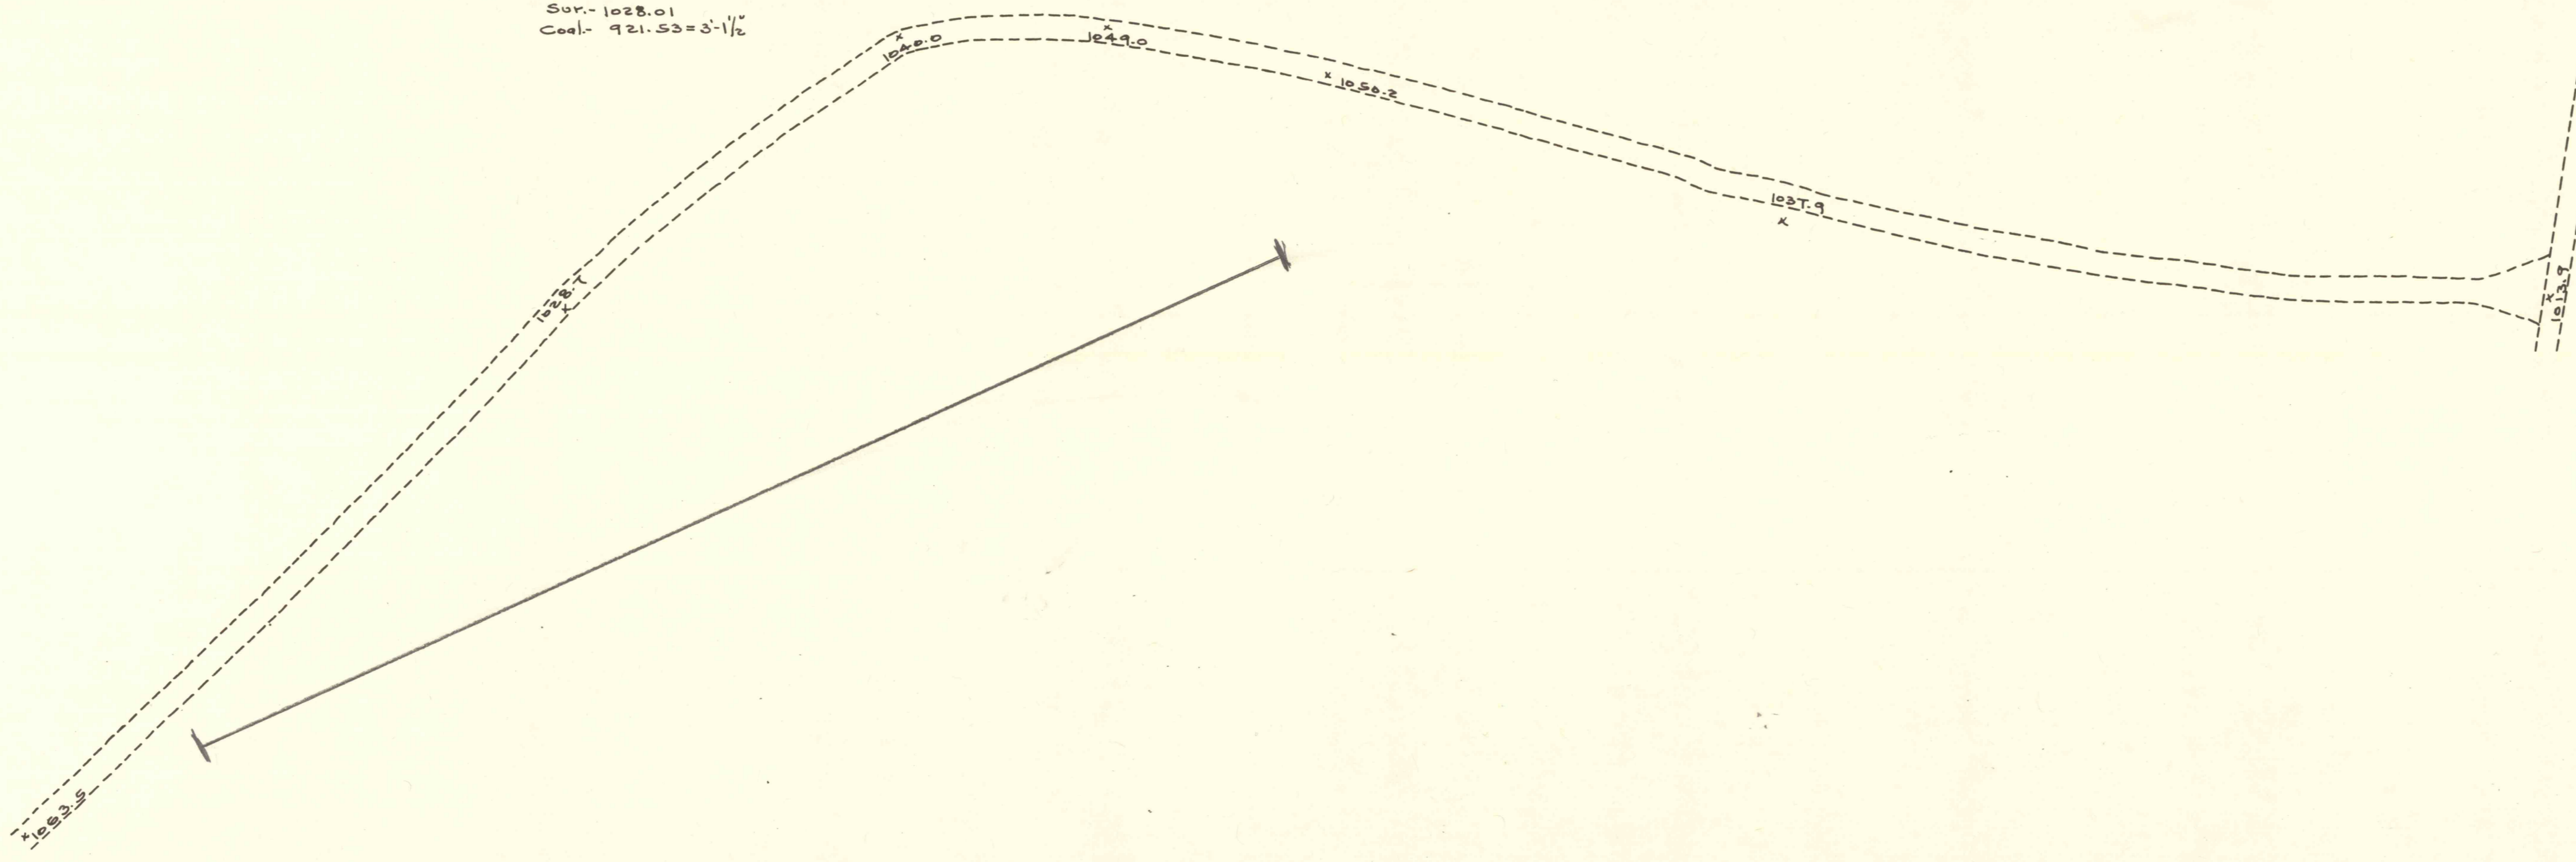

ROCHESTER & PITTSBURGH COAL CO.
KUNDAK & SMITH TRACTS
SHADY PLAIN
MADE BY: M.B.M. SCALE: 1"=100'
DRAWN BY: M.B.M. DATE: 7-27-55
CHECKED BY: M.B.M.