


MAP OF WORKINGS  
OF THE  
**SAVAN COAL CO.**  
GRANT TOWNSHIP, INDIANA COUNTY  
SCALE - 1"=100' JAS. O. GILLYMAN & CO.  
ENGINEERS

11. 1908.  
C. O. Gilman & Co.  
Eng'rs.

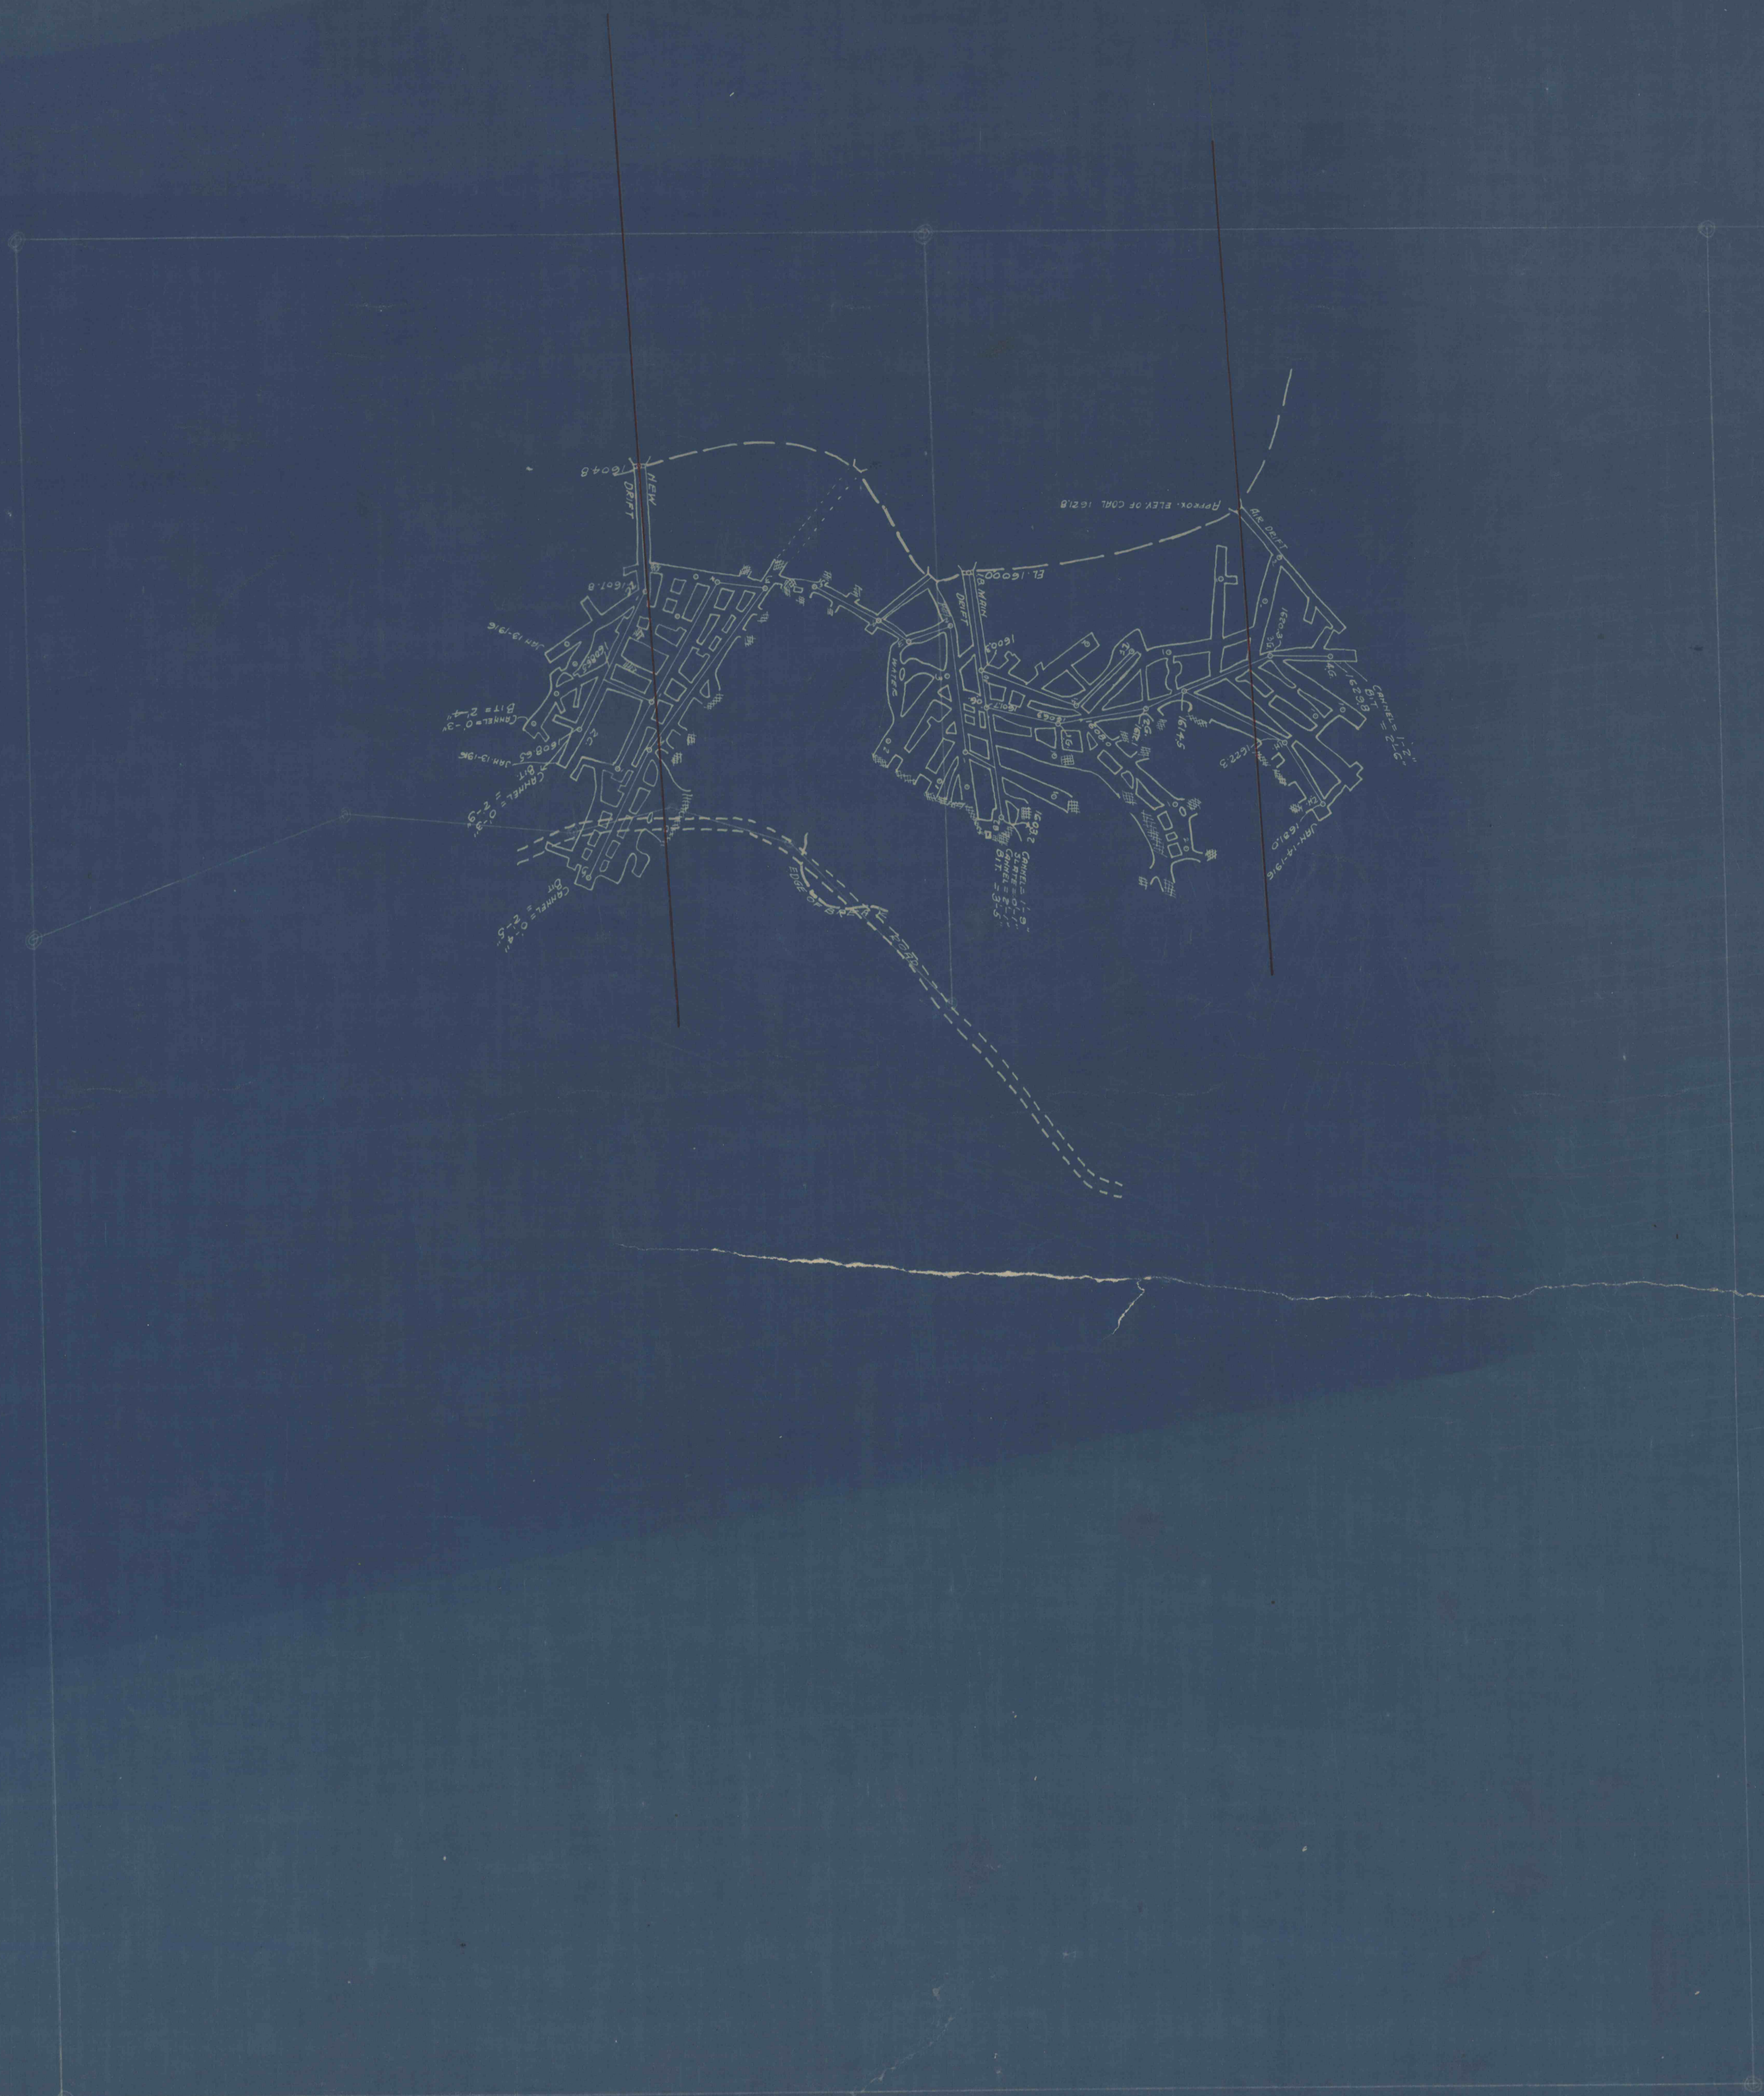

765  
766  
DO NOT WRITE IN THESE SPACES  
W(1) - W(11) / SURM