

6000 N.

5000 N.

4000 N.

MINE MAP

NORTH POINT COAL MNG. Co.

WEST MAHONING TOWNSHIP - INDIANA Co. PA.

SCALE 1" = 100' FEB. 1938

Harry M. Walker
Engineer
Pittsburgh Pa.

3000 E.

3-A-15

LANTZ

WHEATLEY

o Drill Hole

Old Drift
Elev. 1299.8

Old Drift
Elev. 1291.2

NEAL

BARRET

McBLELLEN

INDIAN COAL MINE




OUTCROP

LOWER FREEPORT COAL

OUTCROP

Spring
Cemetery

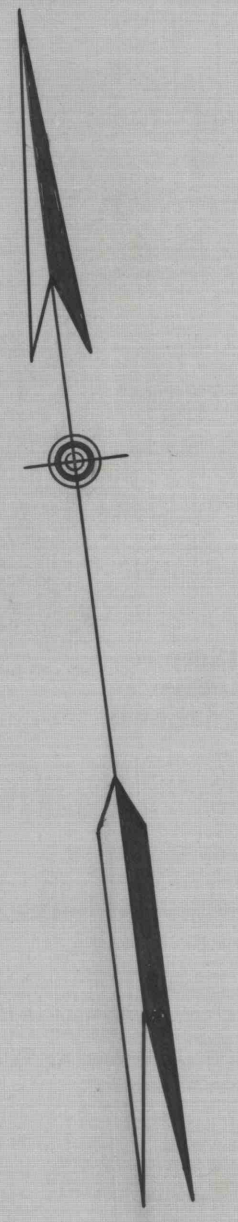

Right of Way Line