

DUKE

WM. AND ALICE LUNGER

NORTH HEIRS (COAL)


PHILLIP R. BOWERS

APPROXIMATE OUTCROP

WM. AND ALICE LUNGER

YOHE

D. T. NEIL

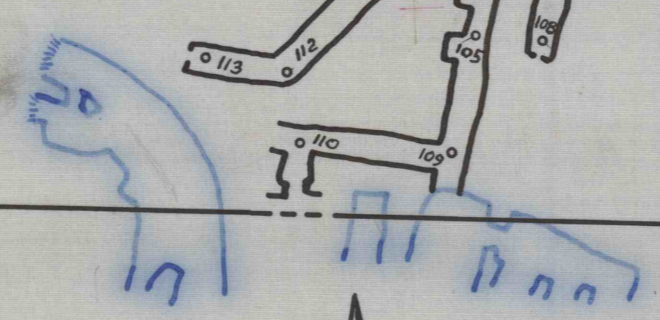

JAMES A. WHITE COAL CO. MINES

BANKS TOWNSHIP, INDIANA COUNTY, PENN'A.
SCALE 1 IN. = 100 FT. SEPTEMBER, 1946
WALTER J. ZIMMERMAN SURVEYOR, PUNXSUTAWNEY, PA.

Stone

Stone

Stone