

MINE MAP
 GEORGE SOLTIS & SONS COAL CO.
 COAL MINE
 Banks Township, Indiana County, Pa.
 Scale 1"=200' August 28, 1957
 Walter J. Zimmerman Surveyor Engineer Punxsutawney, Pa.

SARAH JOHNSTON


JAMES RADCLIFFE

GILBERT MERRLING
 (Surface)
 GEORGE SOLTIS
 (Coal)

GEORGE SOLTIS
 (Coal and Surface)

J.O. CLARK Heirs.

AUGUST SAULSTROM

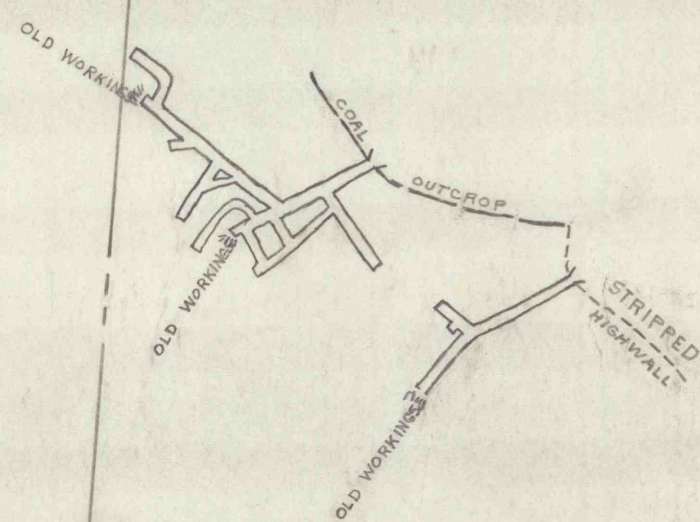

TOWNSHIP ROAD 972

To ROSSITER

State Route L.R. 573
 Concrete Pavement

Traffic Route 336

To GLEN CAMPBELL