


MAP OF
GEO. FERGUSON MINE
BANKS TWP., IND. CO., PA.
Nov-1922 - Scale - 1"=100'
Ned M. Cartney, Engr.,
Punxsutawney, Pa.

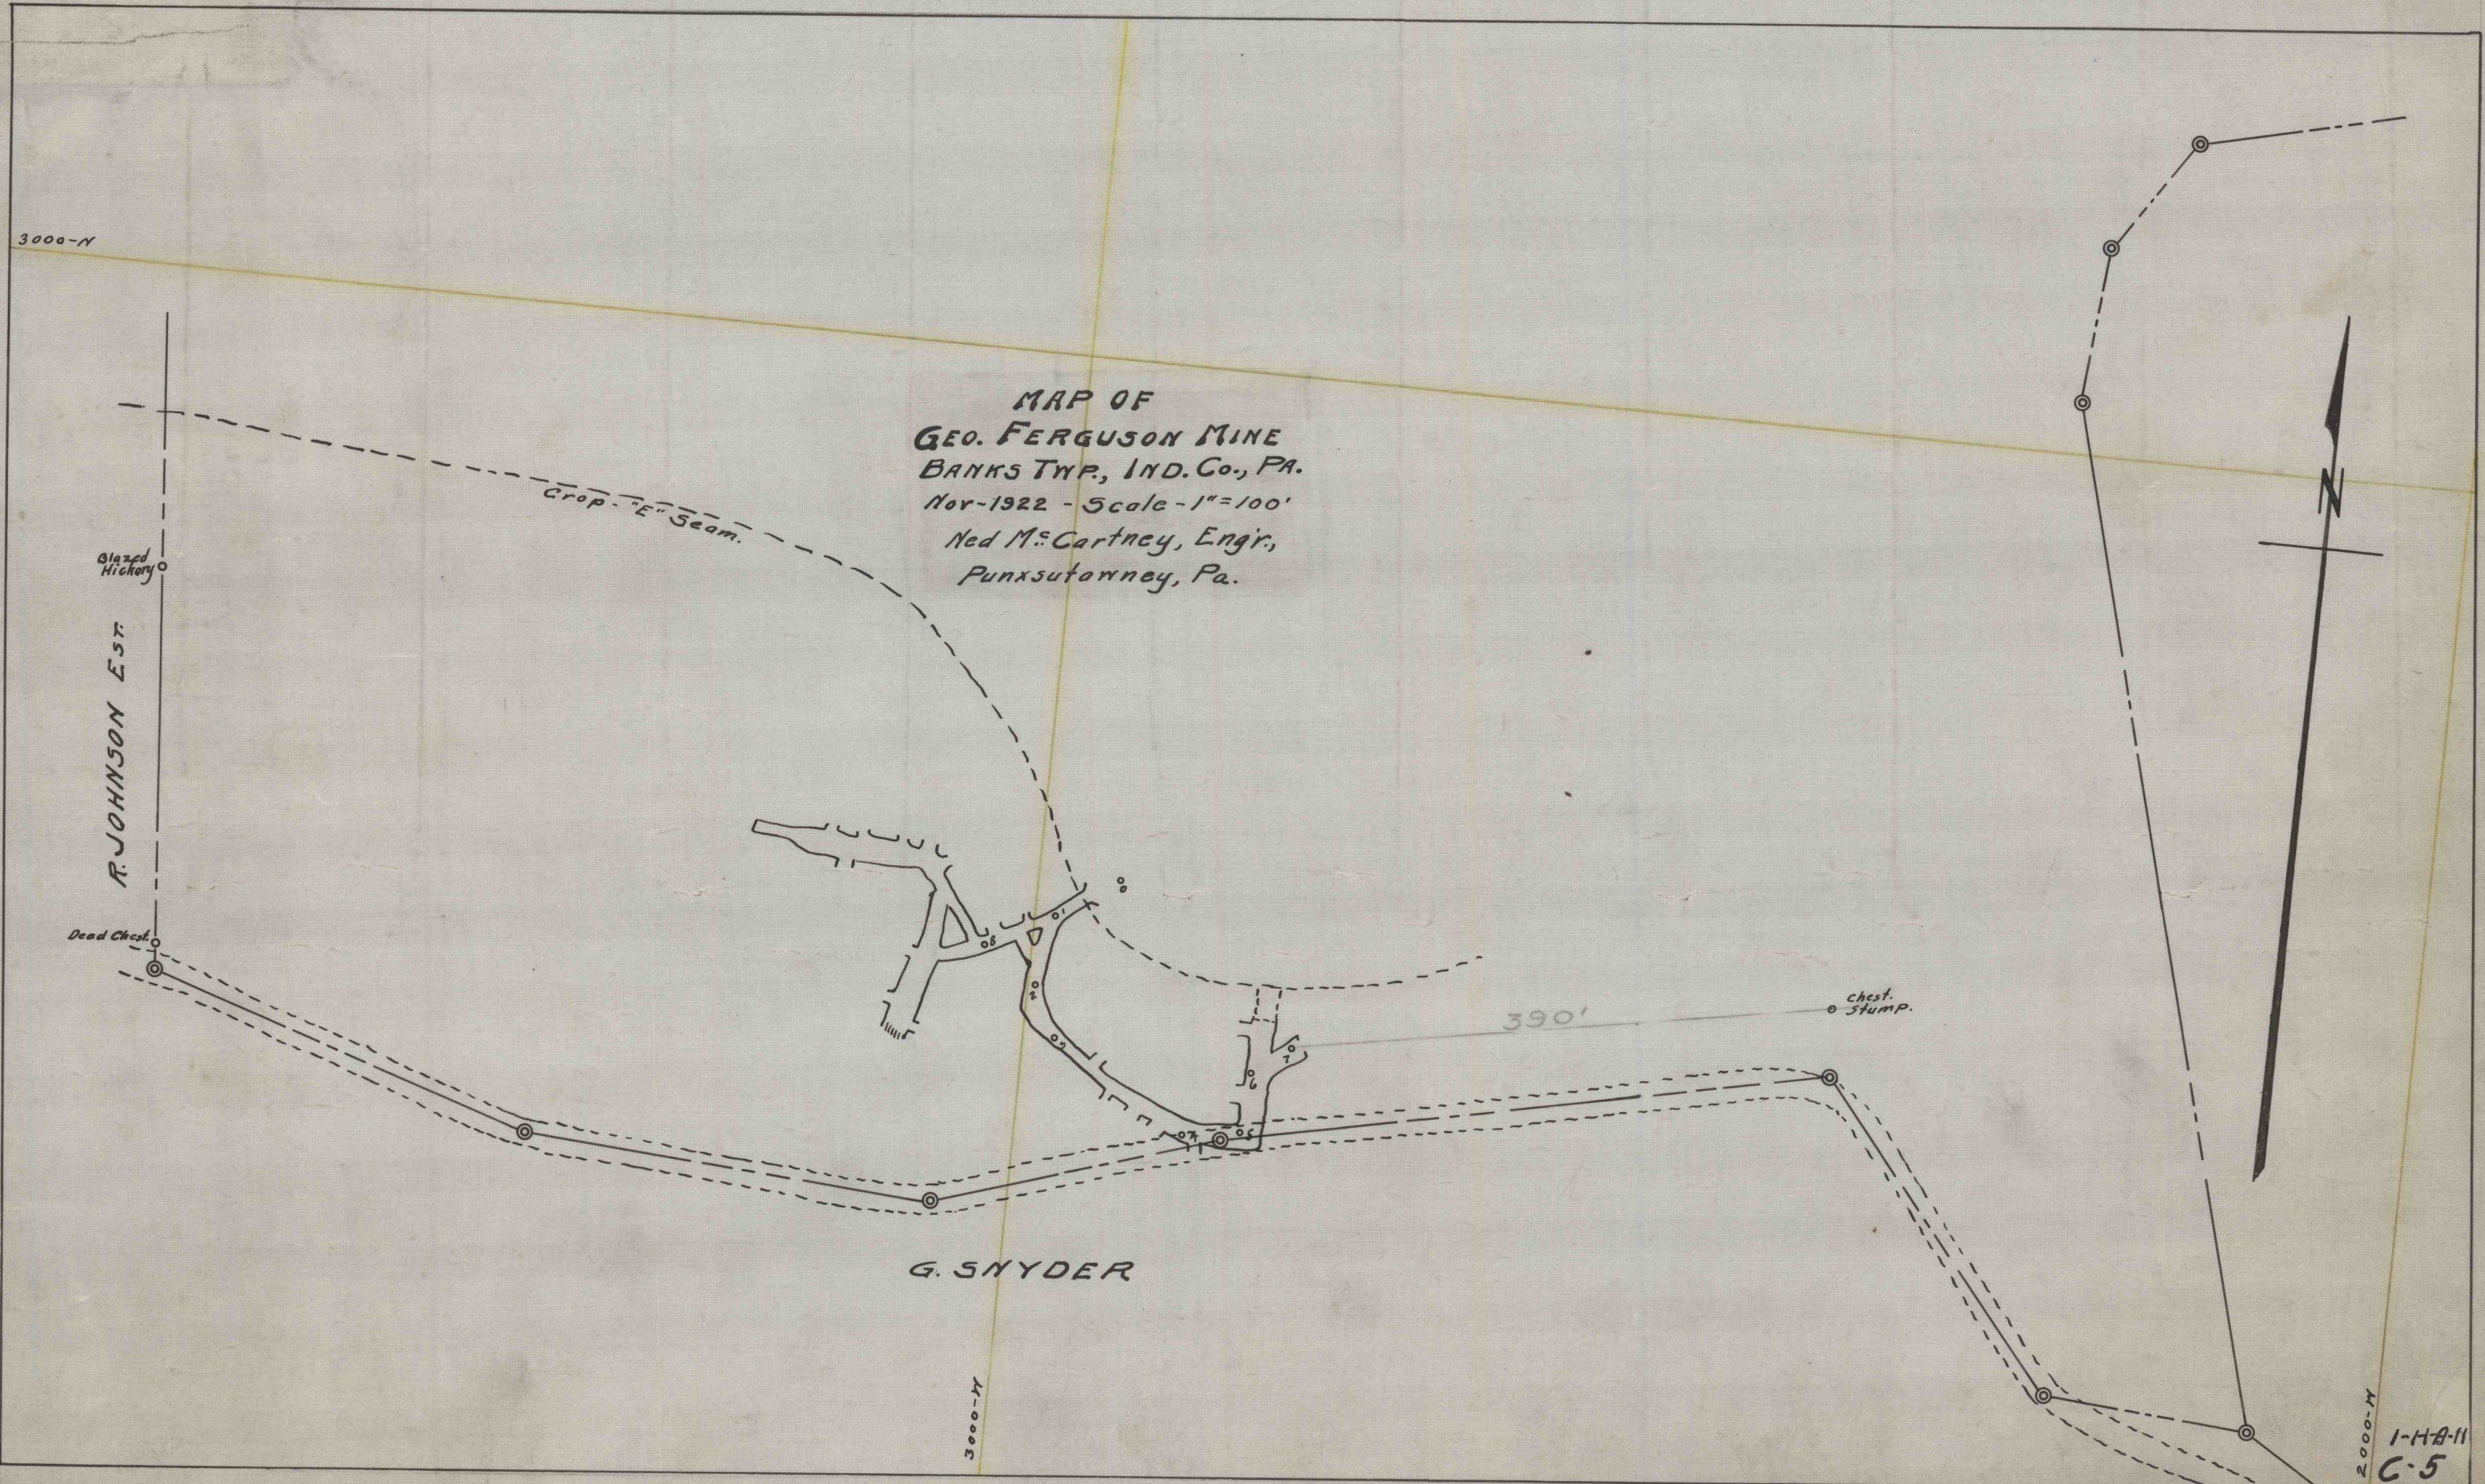

3000-N

Glazed Hickory

R. JOHNSON EST

Dead Chest

Crop - "E" Seam.

390'

chest.
stump.

G. SNYDER

3000-N



2000-N
1-11-22
C-5