
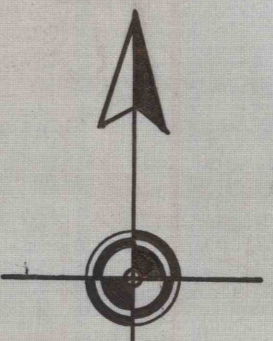


1-B-82
Handwritten notes and symbols along the left margin.

1-B-82
Handwritten note along the right margin.

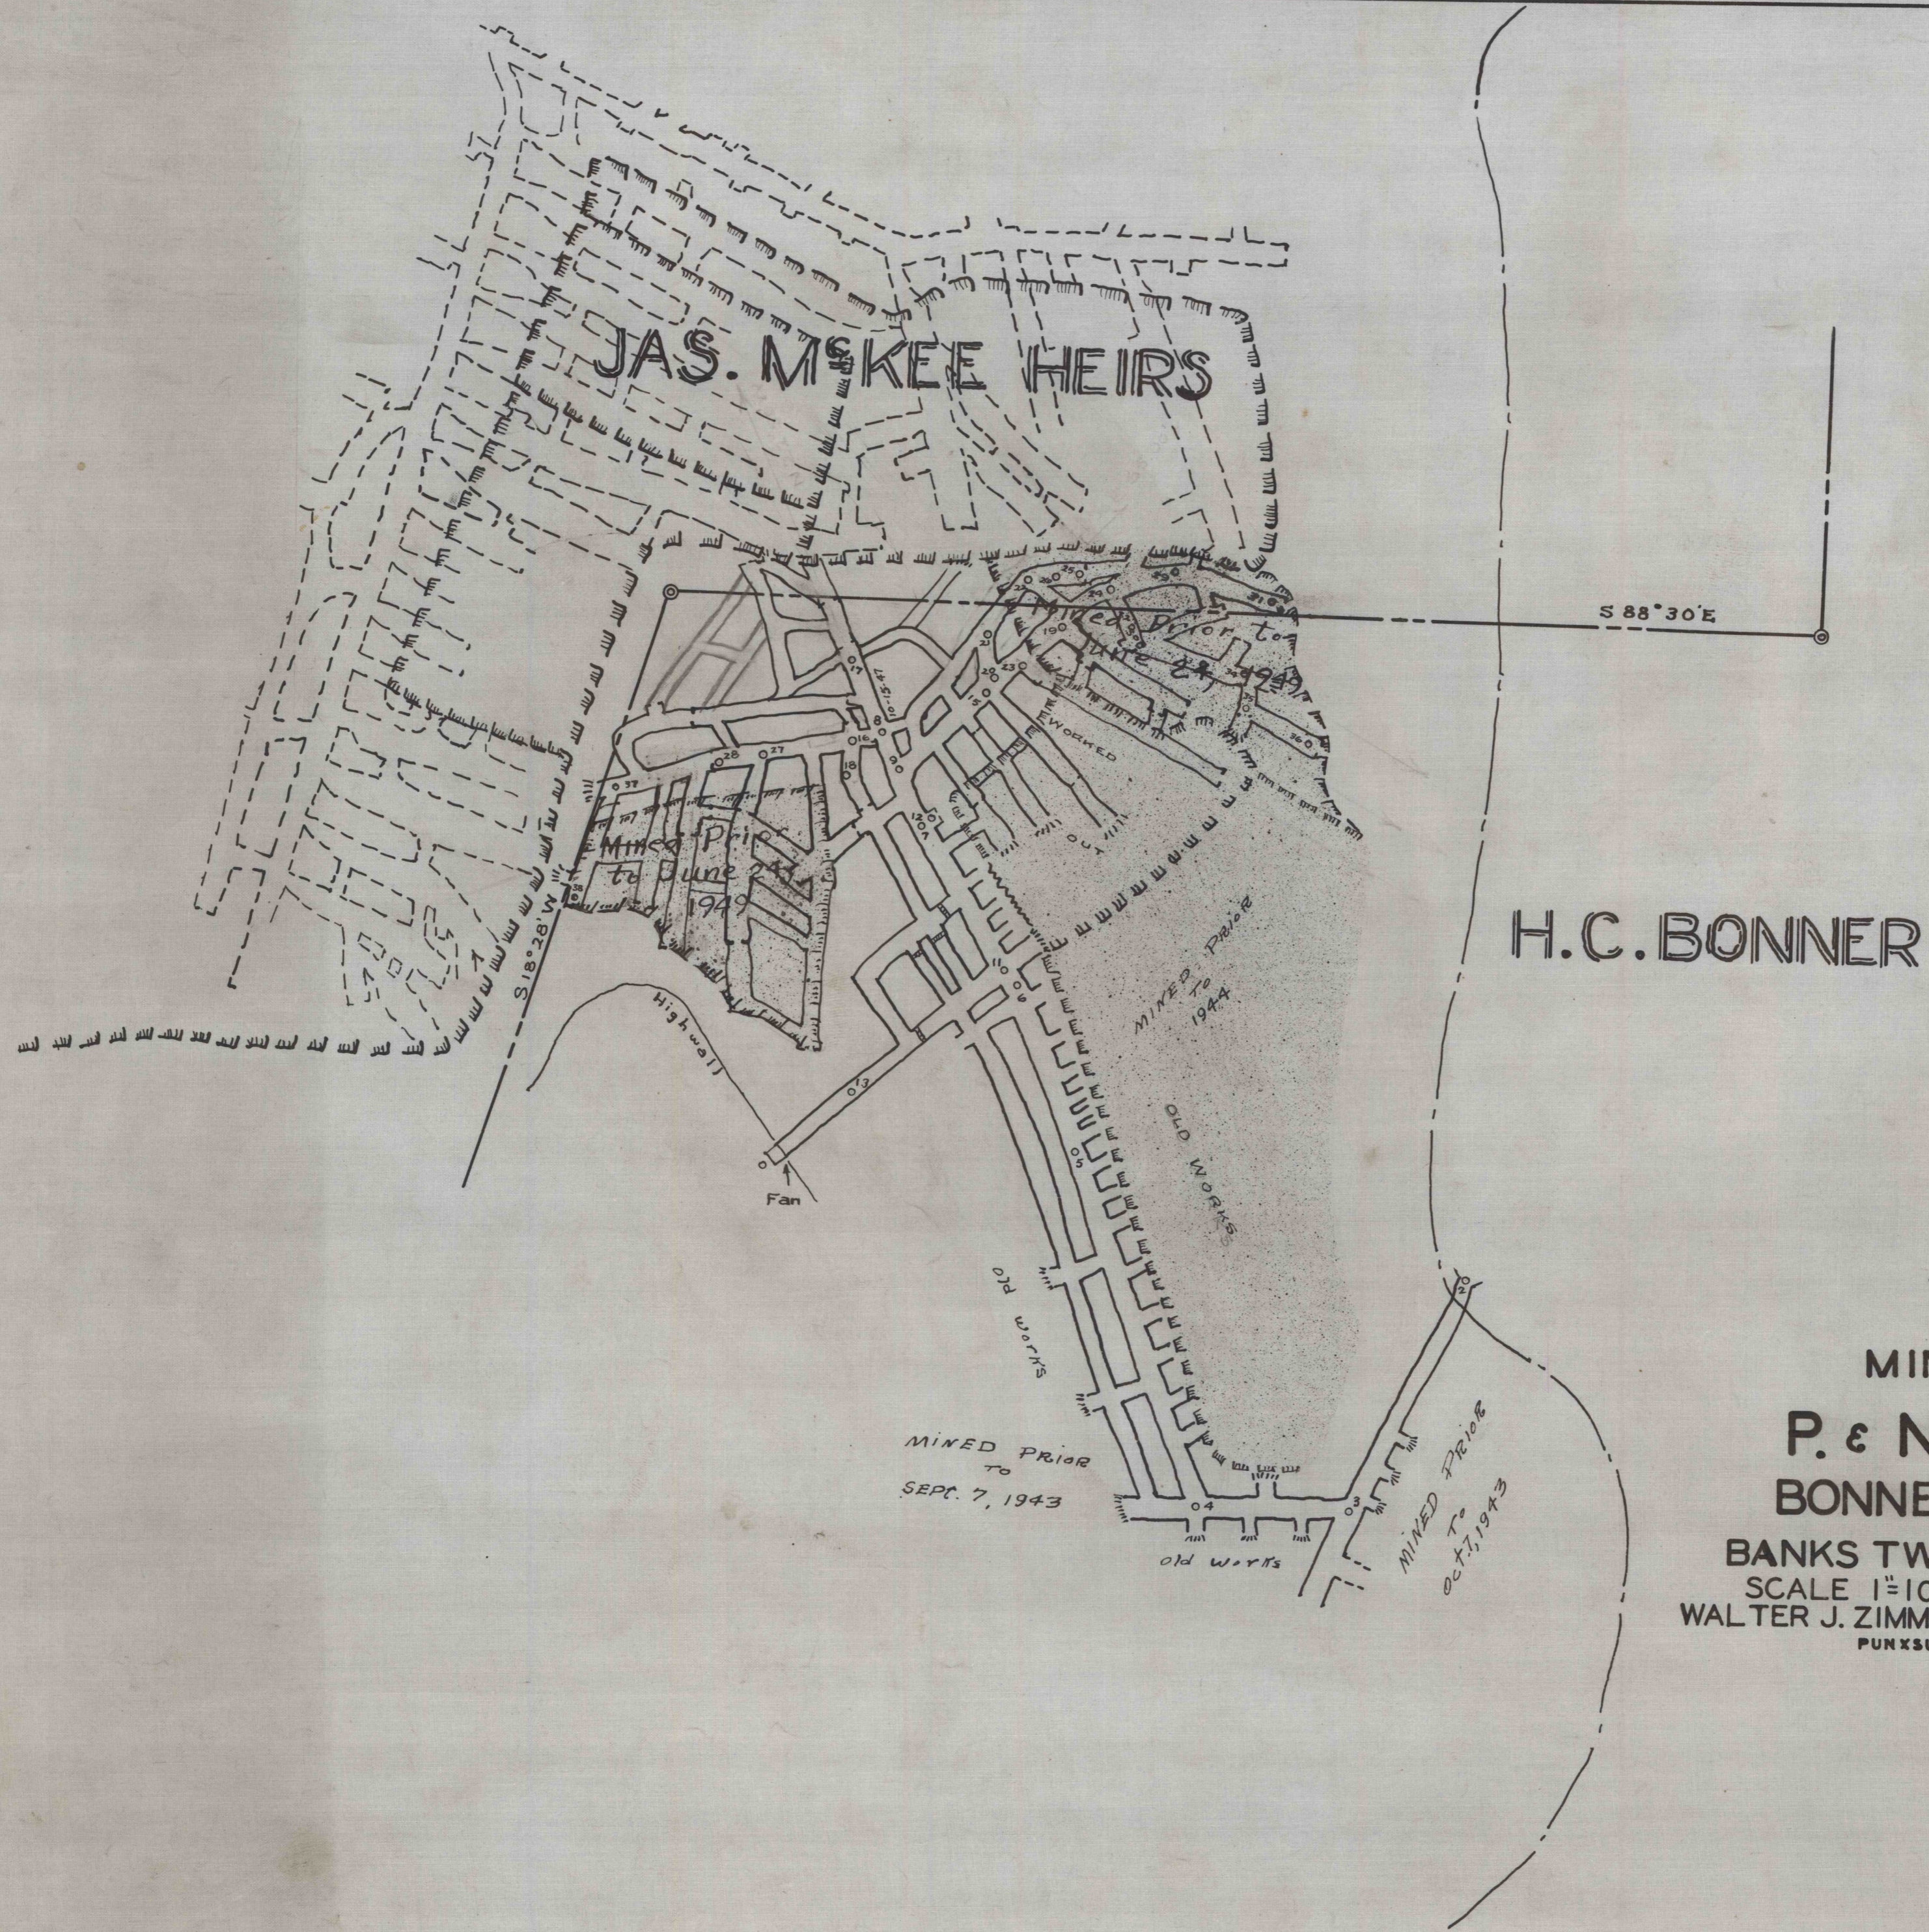

MINE MAP
P. & N. COAL CO.
BONNER MINE NO. 1
 BANKS TWP. INDIANA COUNTY
 SCALE 1"=100' | FEB. 1948
 WALTER J. ZIMMERMAN | SURVEYOR
 PUNXSUTAWNEY, PA.

Jas. MSKee Heirs H.C. BONNER

1-B-82