


728701
N 147° 25'
340 00
107 25
287 25
188 00

14-30

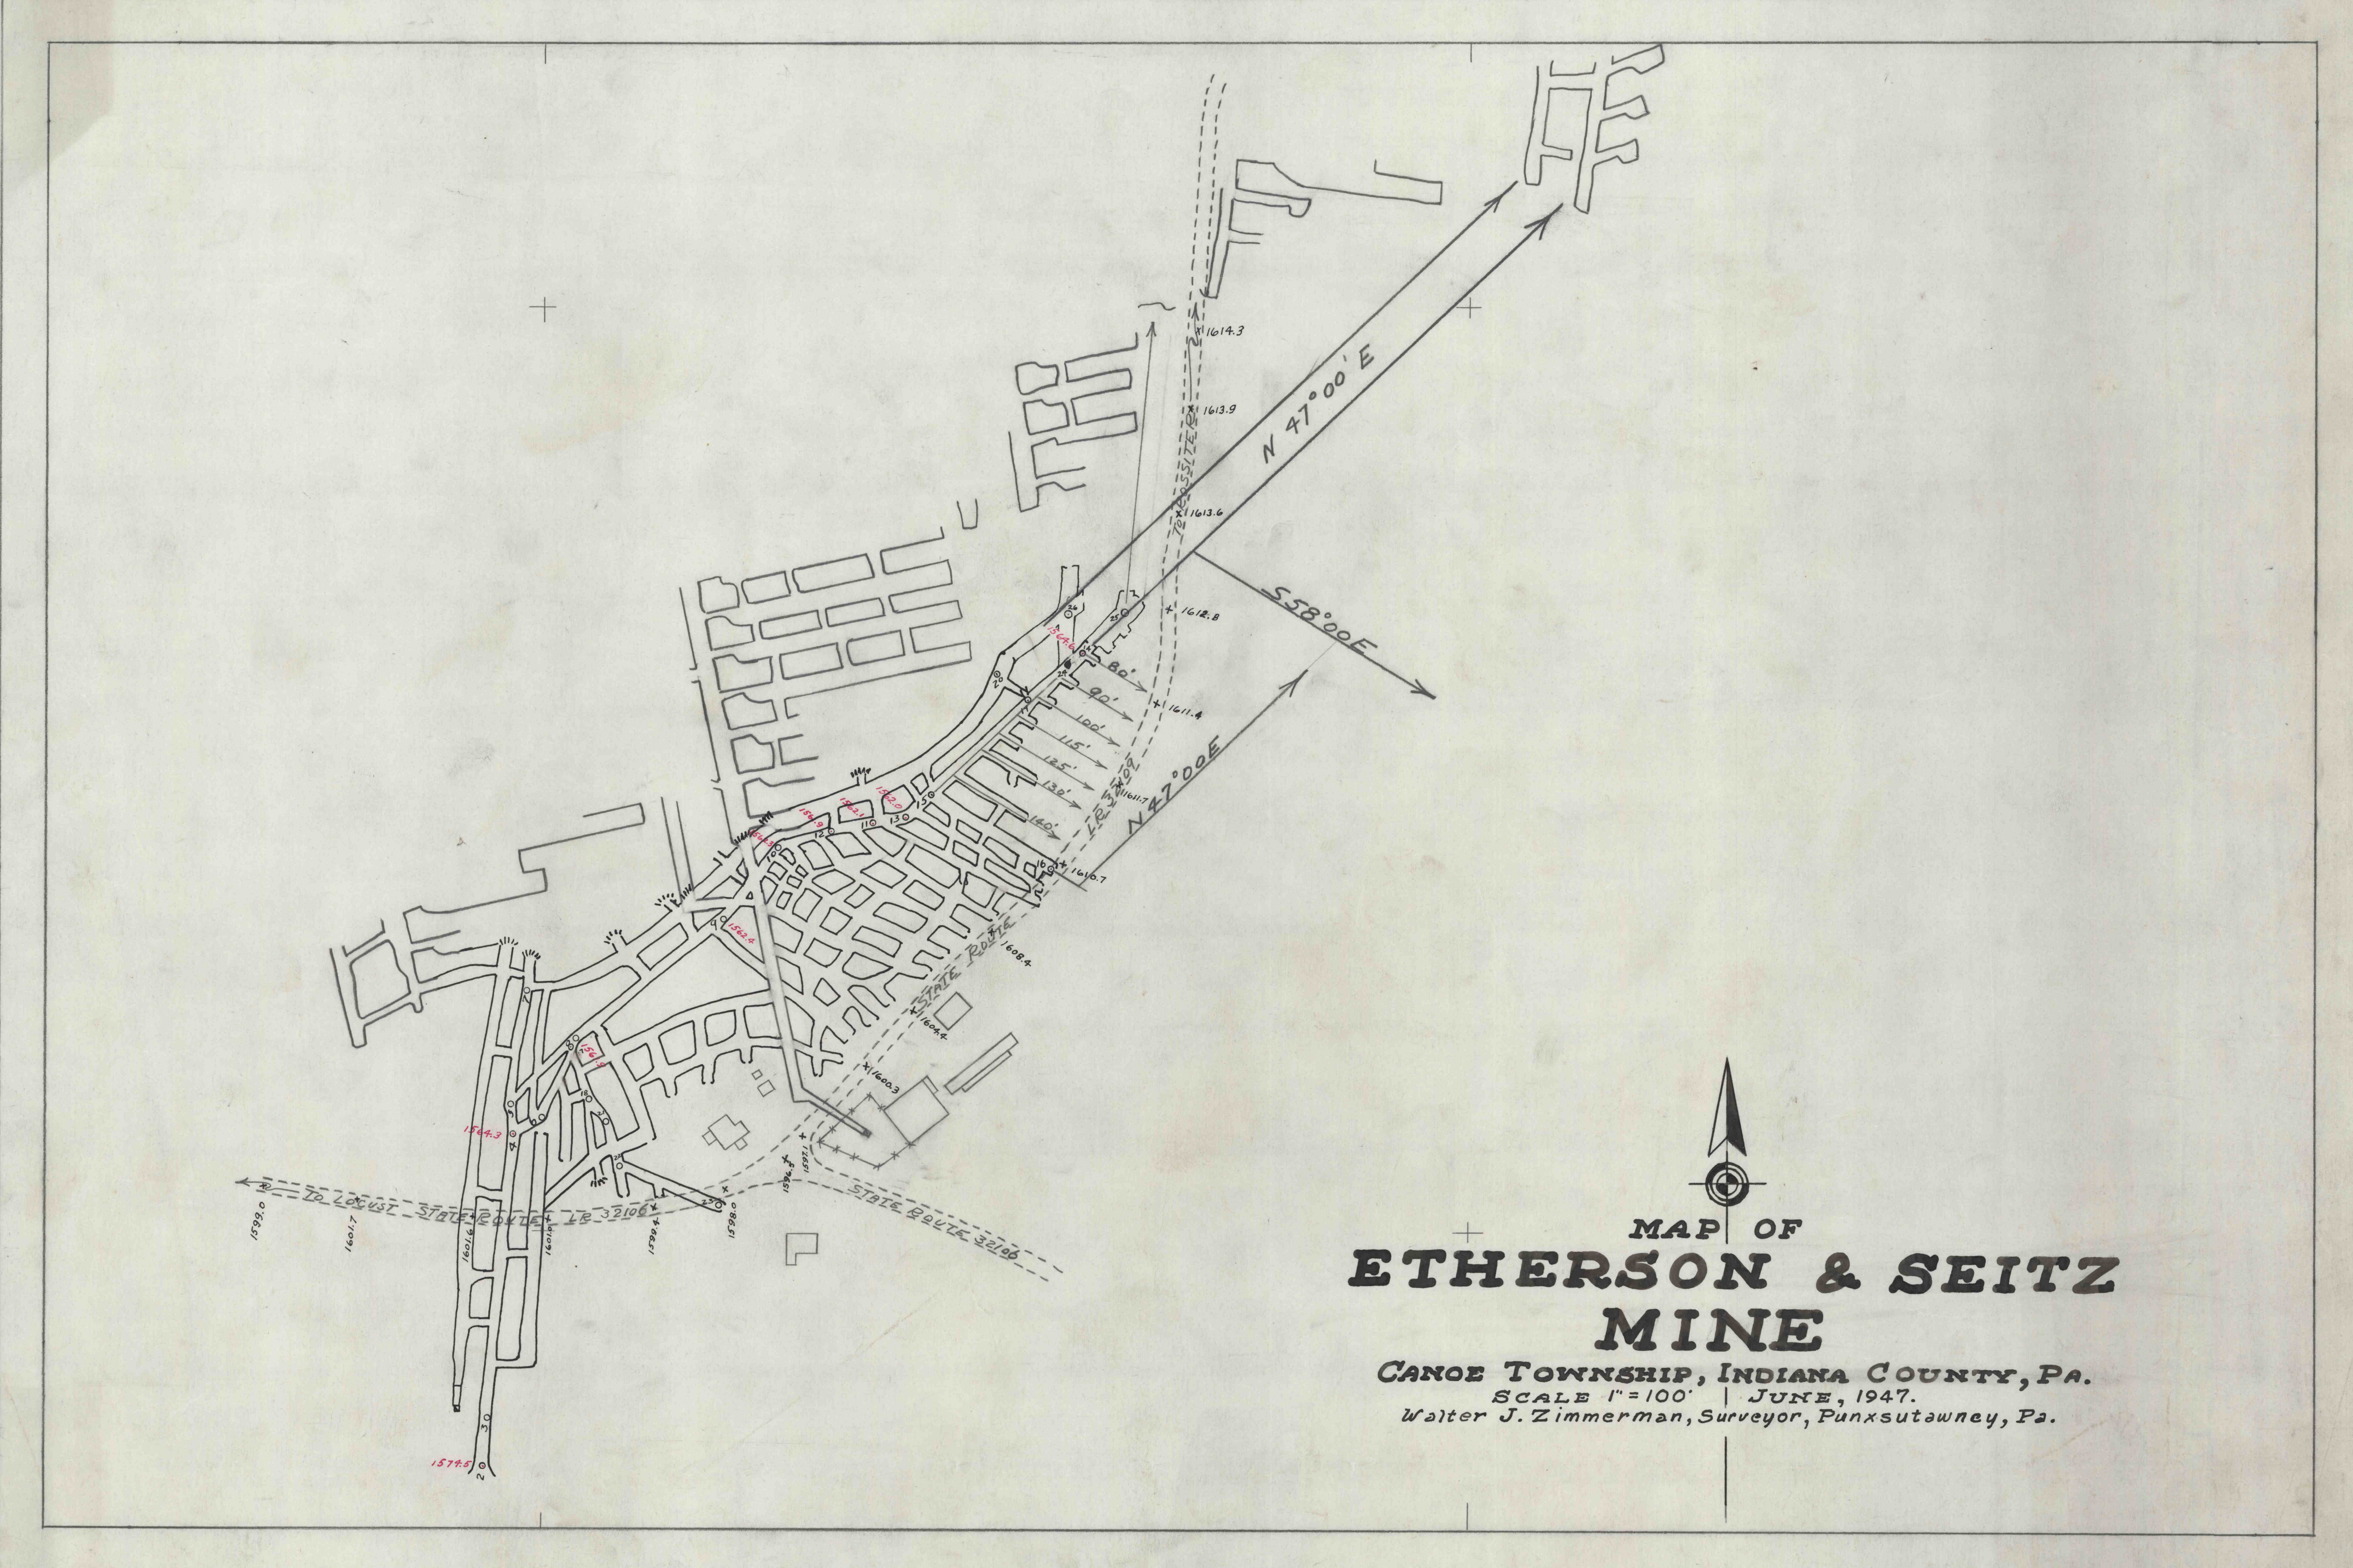

+
MAP OF
ETHERSON & SEITZ
MINE
CANOE TOWNSHIP, INDIANA COUNTY, PA.
SCALE 1" = 100' | JUNE, 1947.
Walter J. Zimmerman, Surveyor, Punxsutawney, Pa.

ELI

Etherson & Seitz