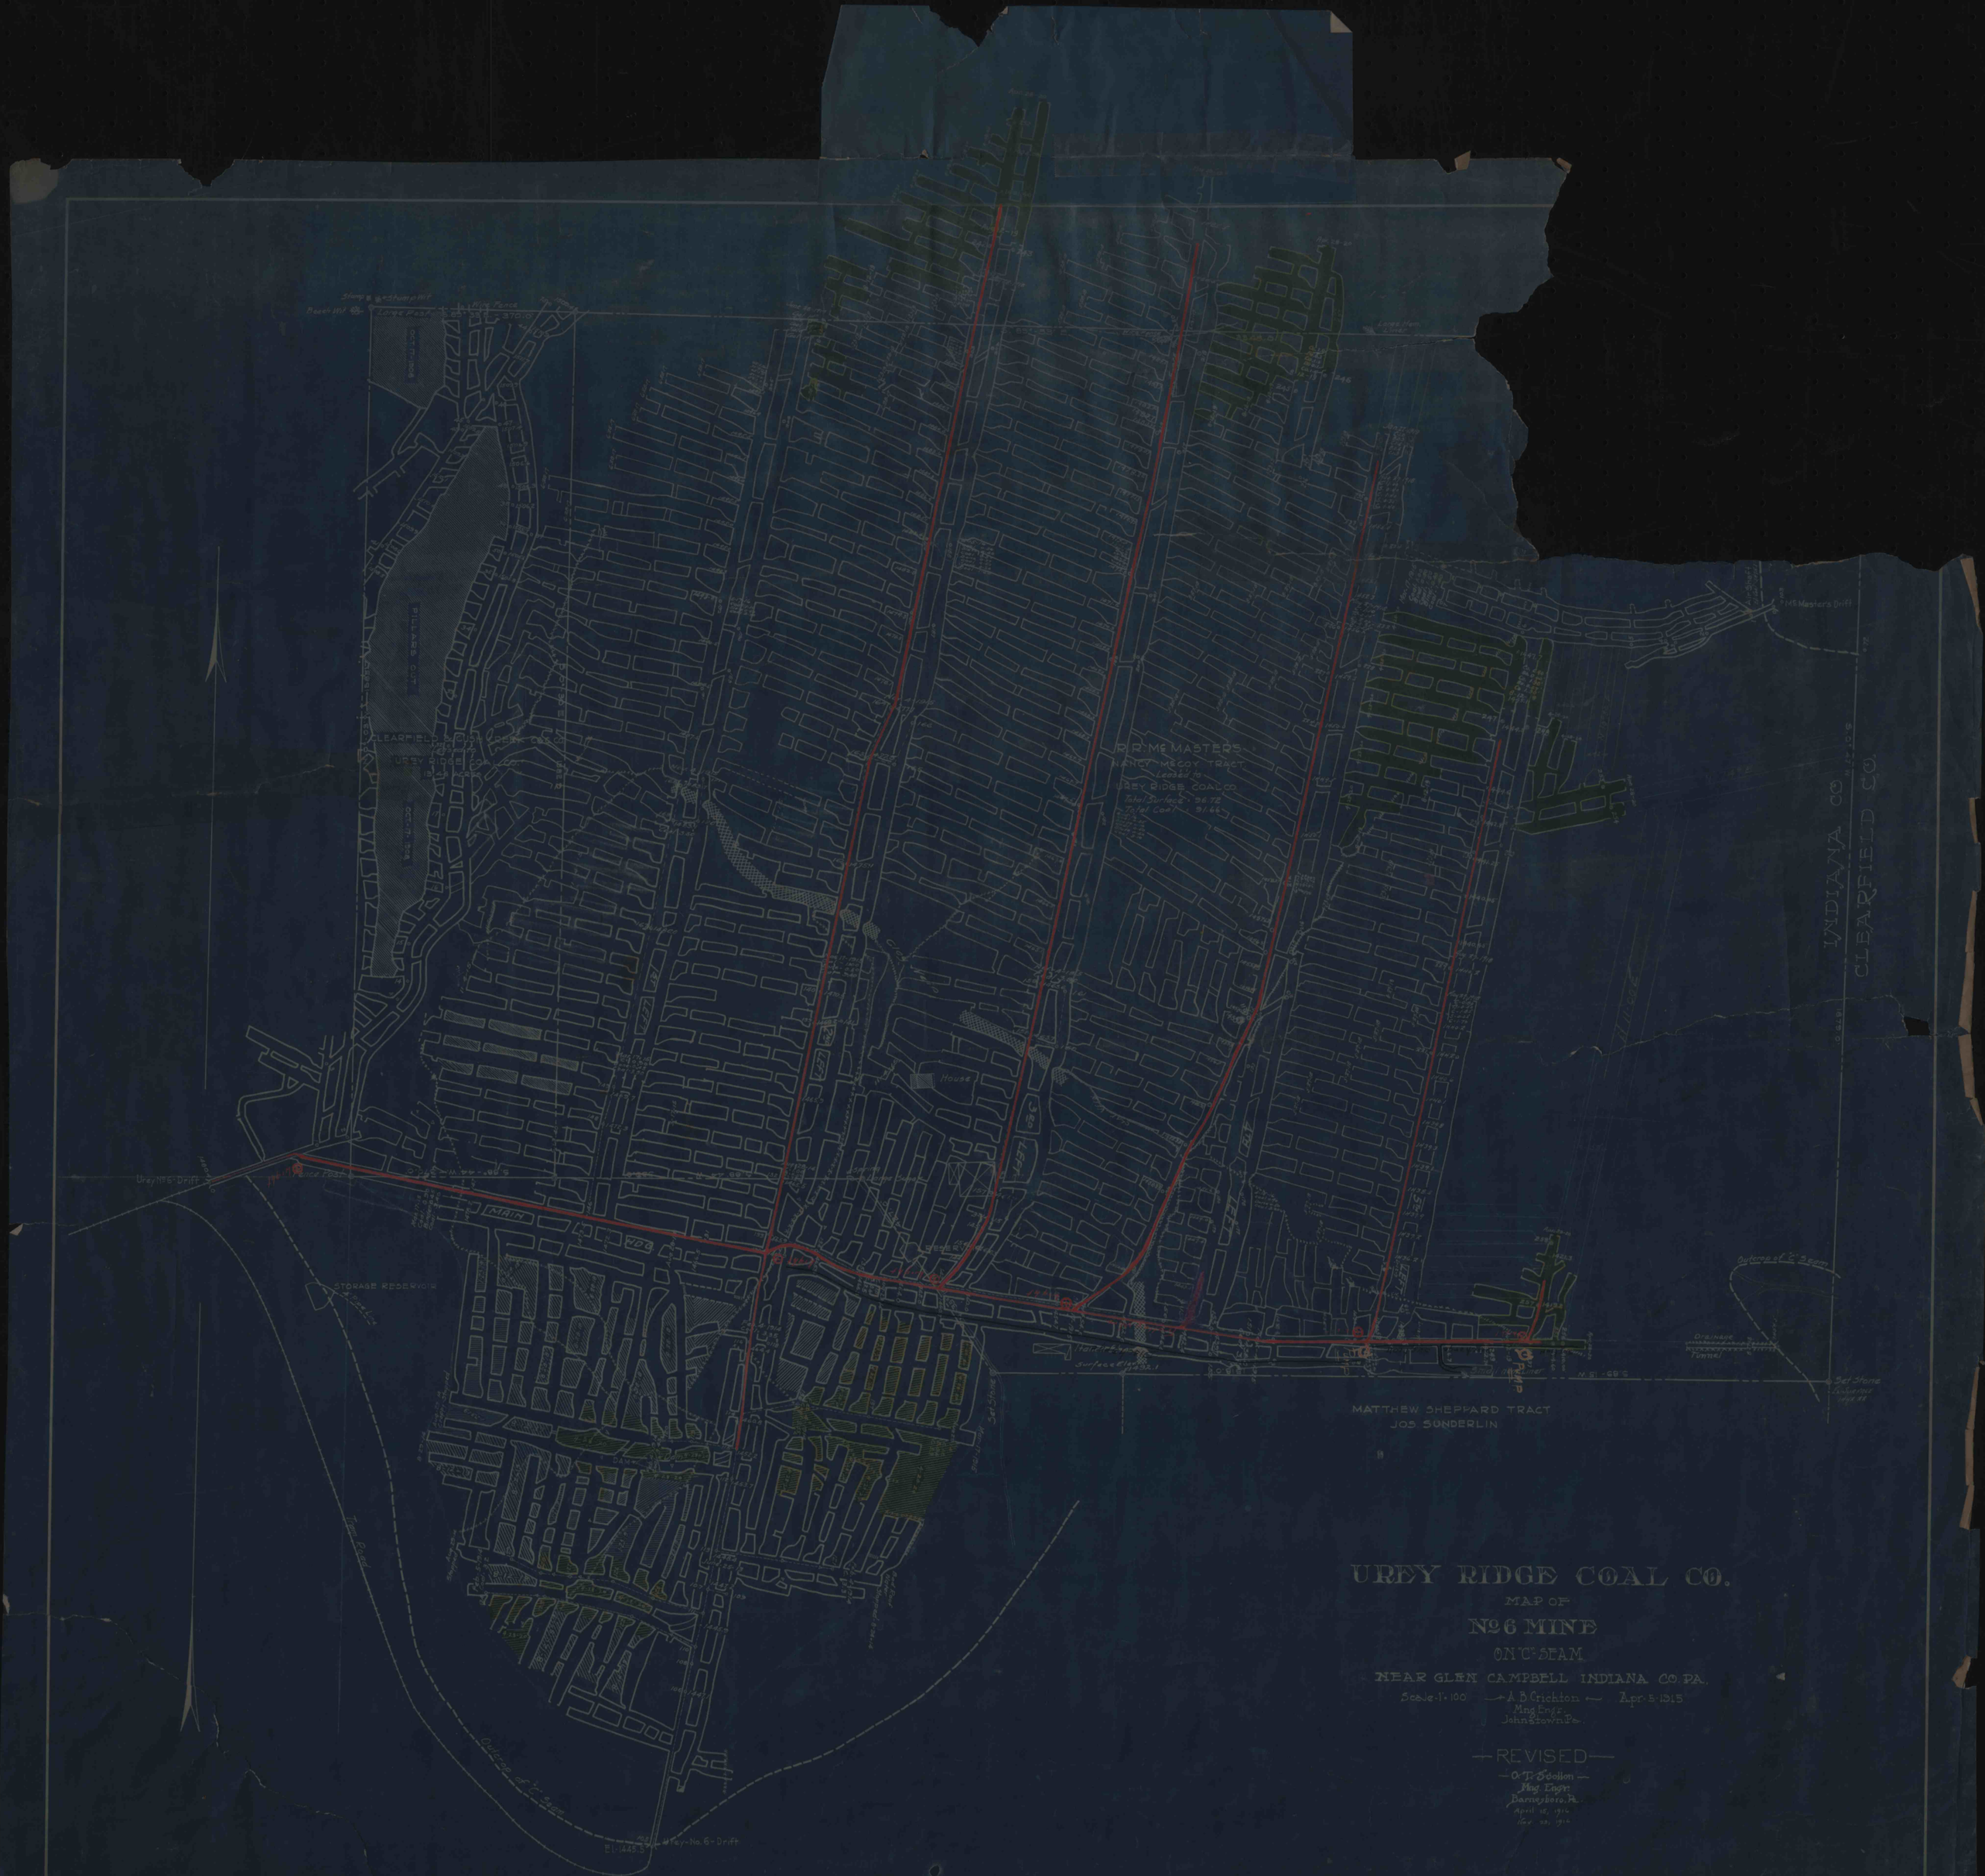

UREY RIDGE COAL CO.

MAP OF

No 6 MINE

ON "C" SEAM

NEAR GLEN CAMPBELL INDIANA CO. PA.

Scale 1" = 100' — A. B. Crichton, Mng. Engr., Johnstown, Pa. — Apr. 5. 1915

—REVISED—

O. T. Boolton, Mng. Engr. Barnesboro, Pa.

April 15, 1916

Nov. 22, 1916