
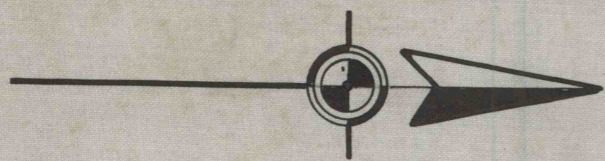


2-D-60

HENRY MILLER

LINUS M. LEWIS

SAMUEL T. LEWIS

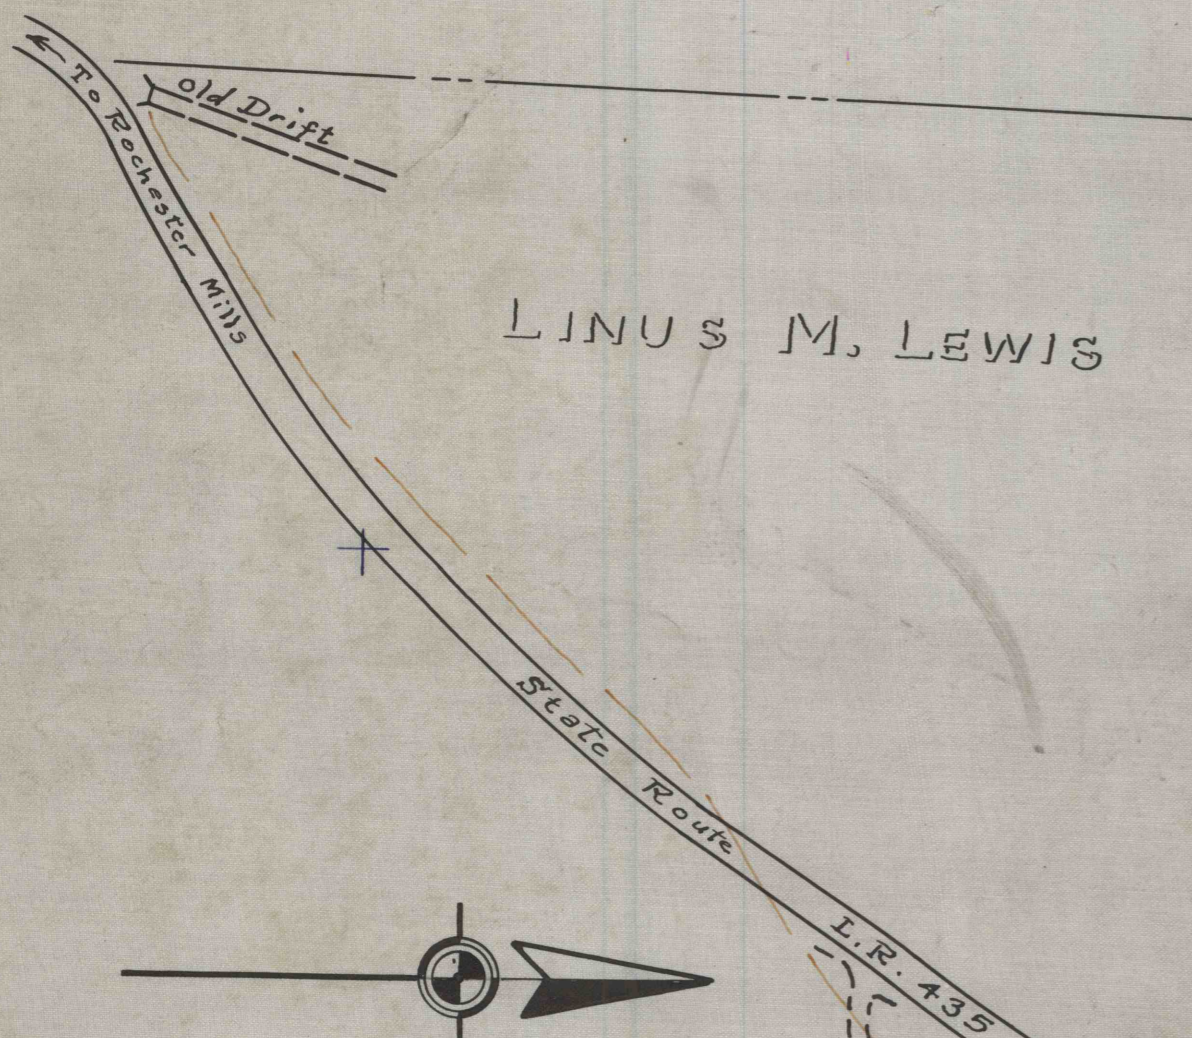

MINE MAP  
**P. & N. COAL CO., INC.**  
**LOCUST MINE**  
 CANOE TOWNSHIP, INDIANA COUNTY, PA.  
 Scale 1" = 100' Dec., 1949  
 Walter J. Zimmerman, Surveyor-Engineer, Pottsville, Pa.



2-D-60

3-A-50

2-D-60