

FRED HAWK

ADAM HENRY

DOMB HEIRS

MAY STRACHAN

School

APPROX. OLD WORKINGS

APPROX. OLD WORKINGS


$566^{\circ}41'W$
 $566^{\circ}41'W$

$587^{\circ}58'W$

DOMB HEIRS

ADAM HENRY

MRS. ETTA HENRY

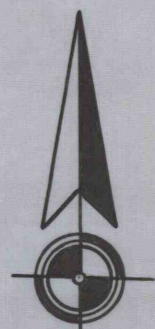

MINE MAP
 P. & N. COAL CO.
 HENRY MINE
 CANOE TOWNSHIP INDIANA CO. PA.
 SCALE 1" = 100'
 JANUARY 1951
 WALTER J. ZIMMERMAN
 SURVEYOR - ENGINEER
 PUNXSUTAWNEY PENNA.

1-B-102

2 2