

500.0 West



1000.0 West

To Punxsutawney

500.0 North

0 North
0 South

5000 South

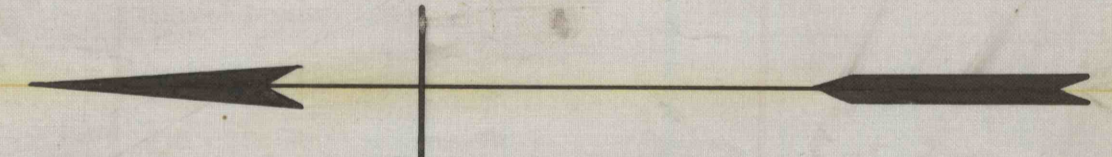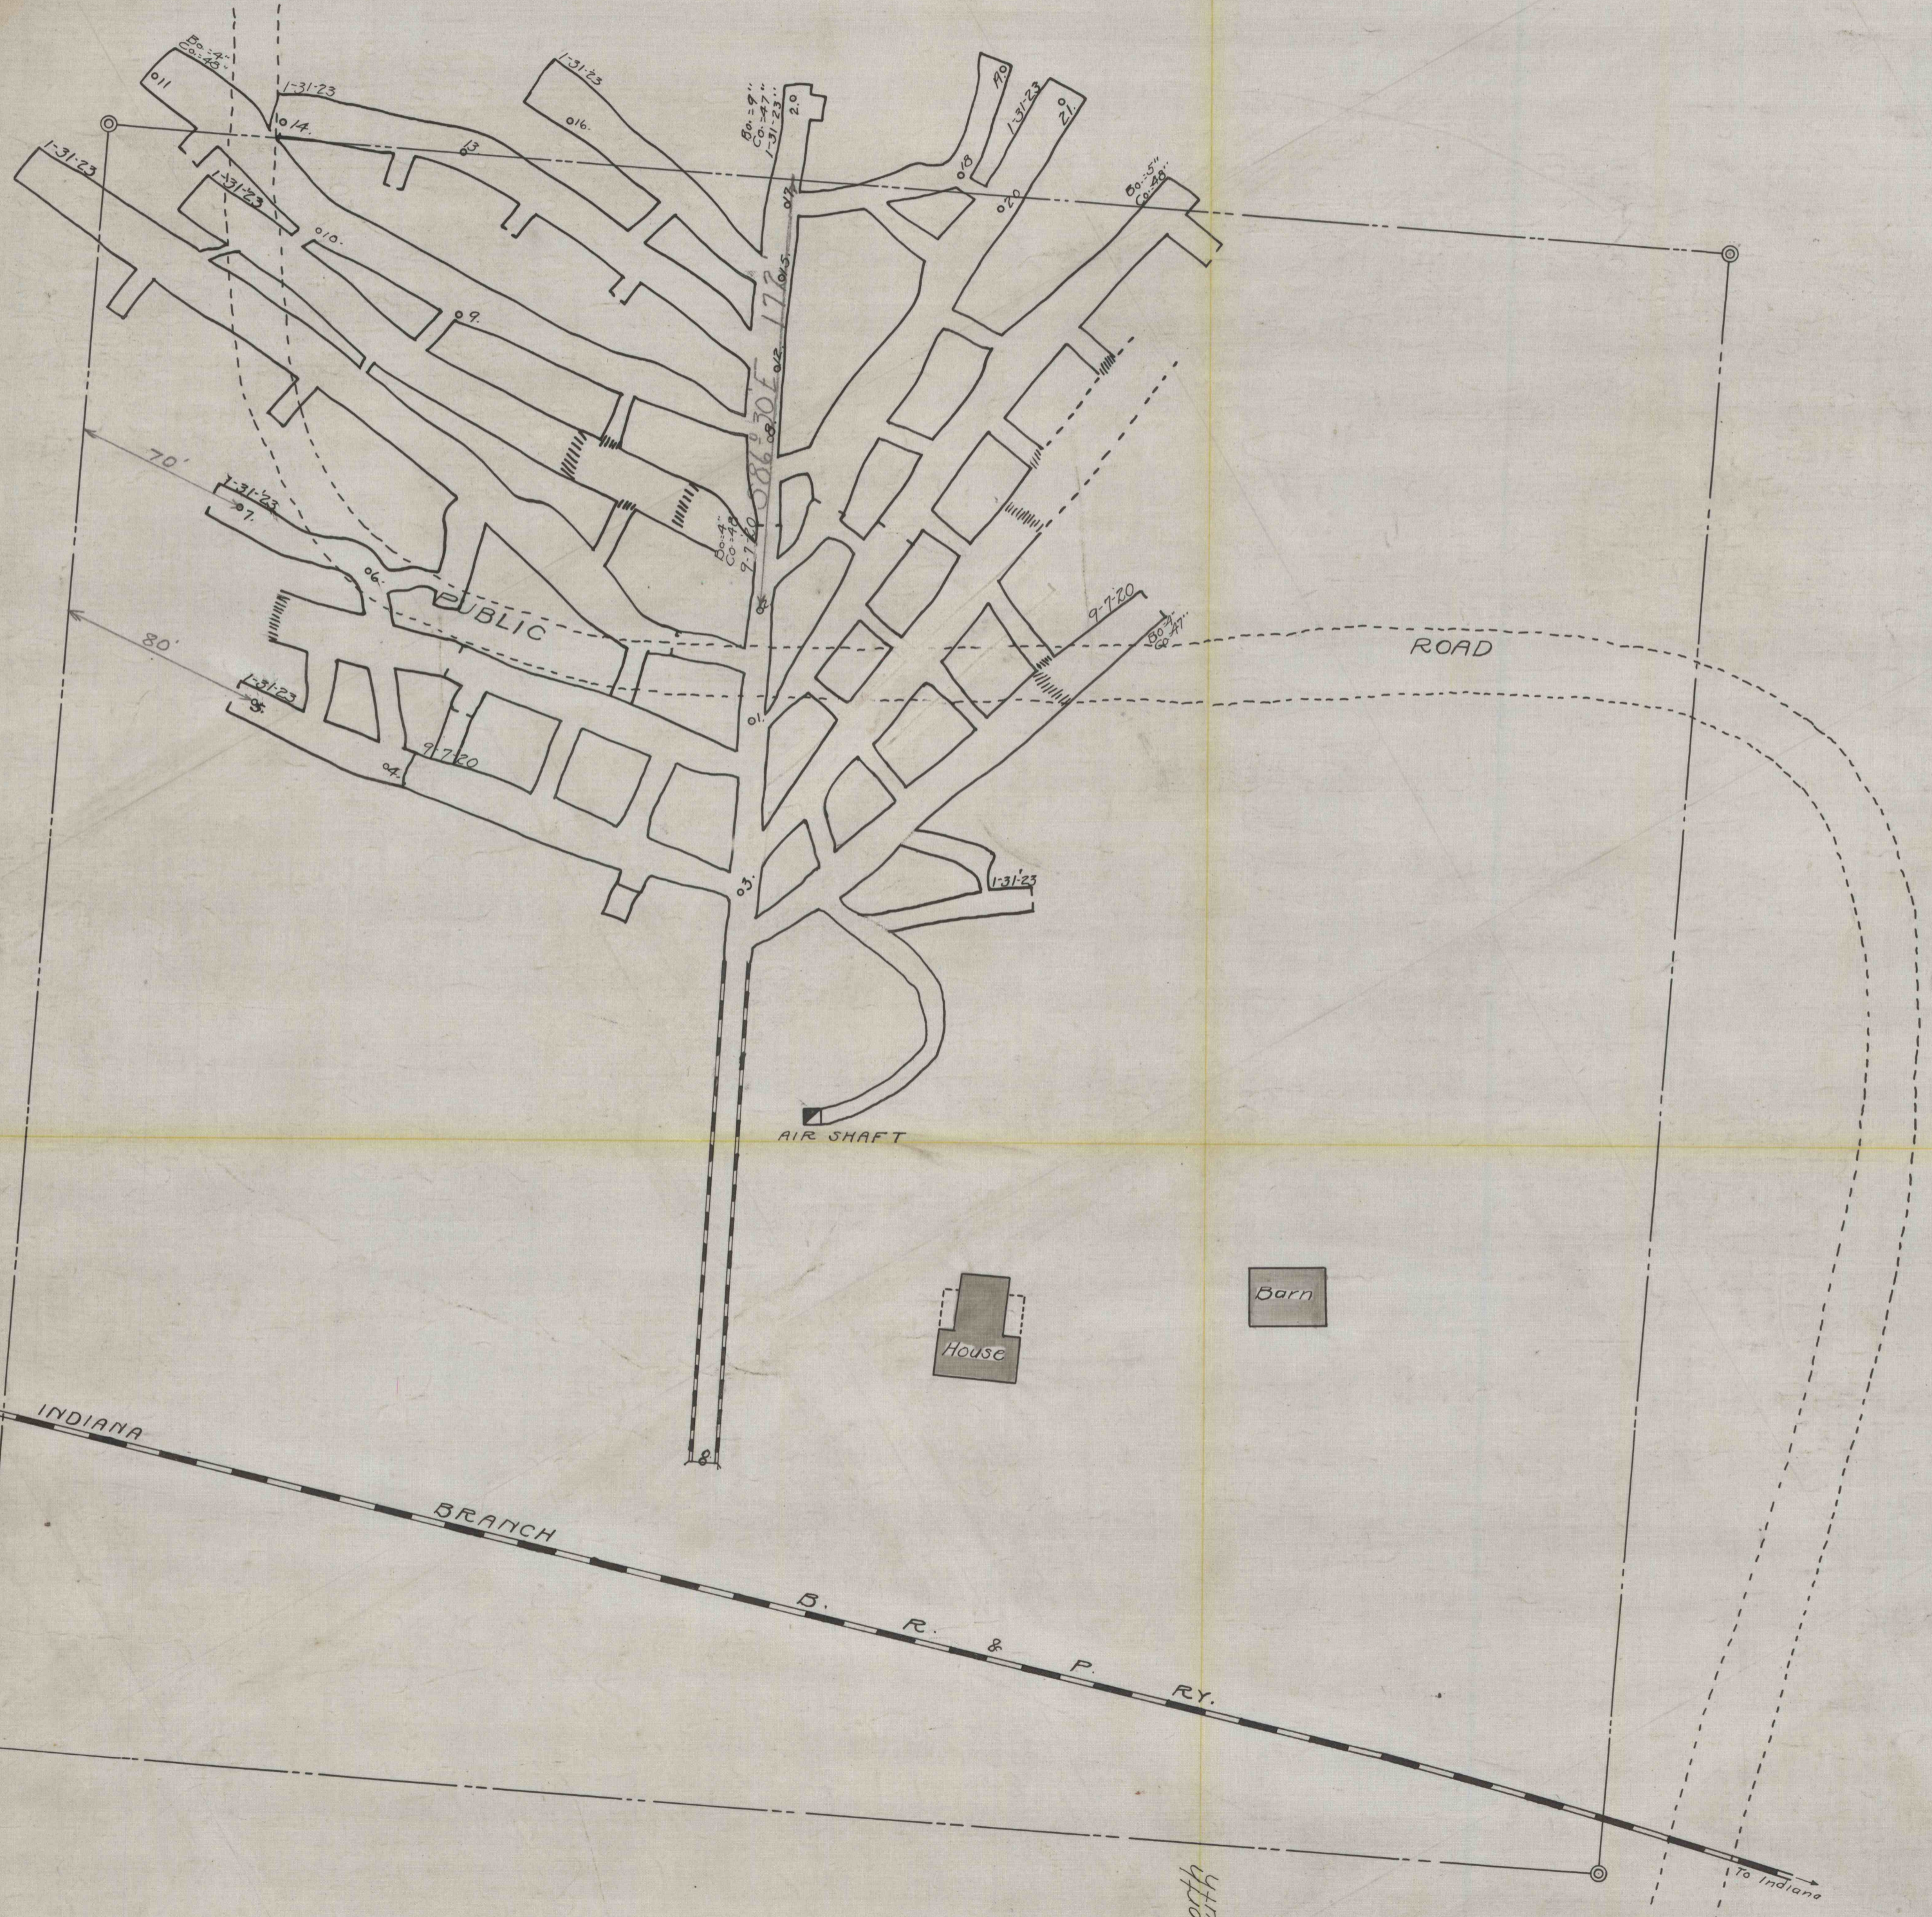

OMER B. DEPP MINE

JUNEAU IND. CO., PA.

SCALE 1 in. = 50 ft.

H.M. KANARR
Engineer

Punxsutawney Pa

Conceitop.