



1-B-94

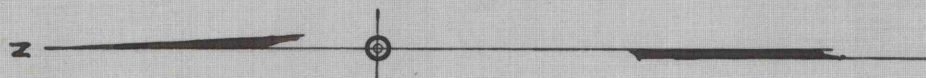

F.L. GASTON

C.W. GASTON HEIRS

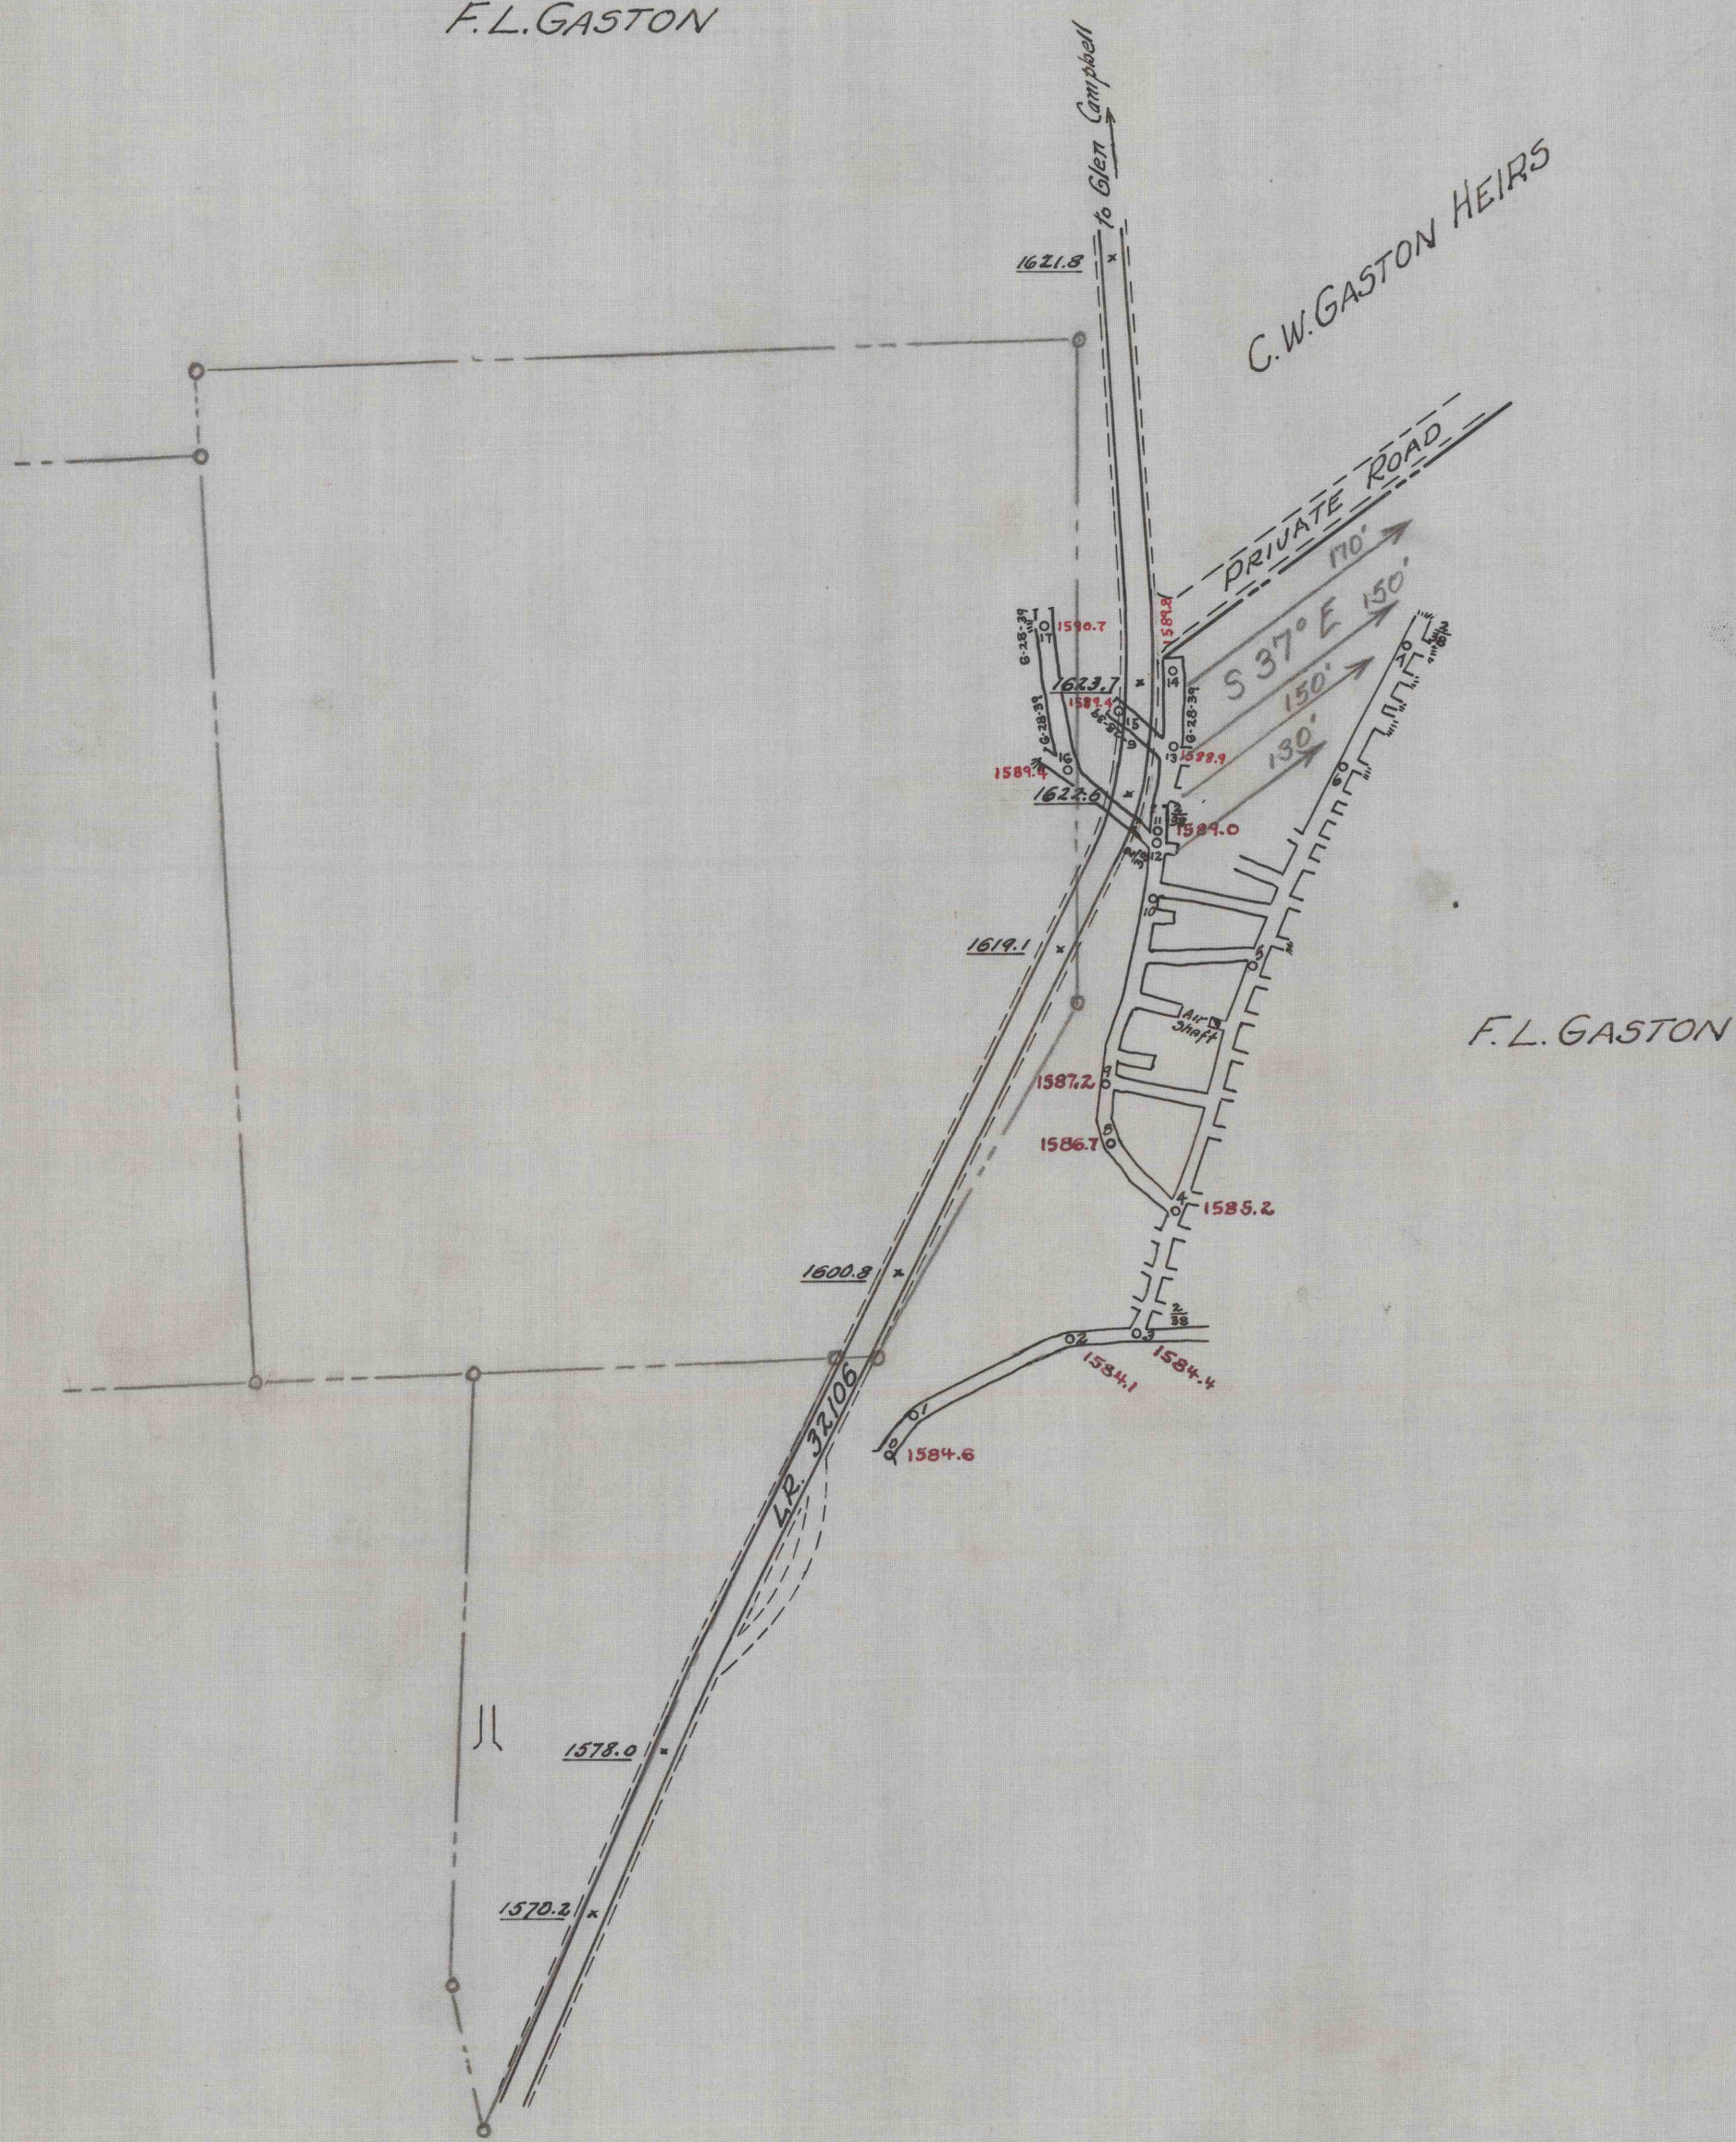

MINE MAP  
 F. L. GASTON  
 CANOE TWP., INDIANA CO. PA.  
 SCALE 1"=100' FEB. 1938

Harry M. Walker  
 Engineer  
 Danxatunney Sq.

1-B-94

1-B-94

1-B-94

Notes: Mic. 15  
 Drawing: 2-A-19  
 Tracing: 2-A-19-B  
 Traverse: 4678 Vol. 1