


11-1-17
11-1-17

1000.0 East


2000.0 East

DORA A. ROUSH.

GASTON.

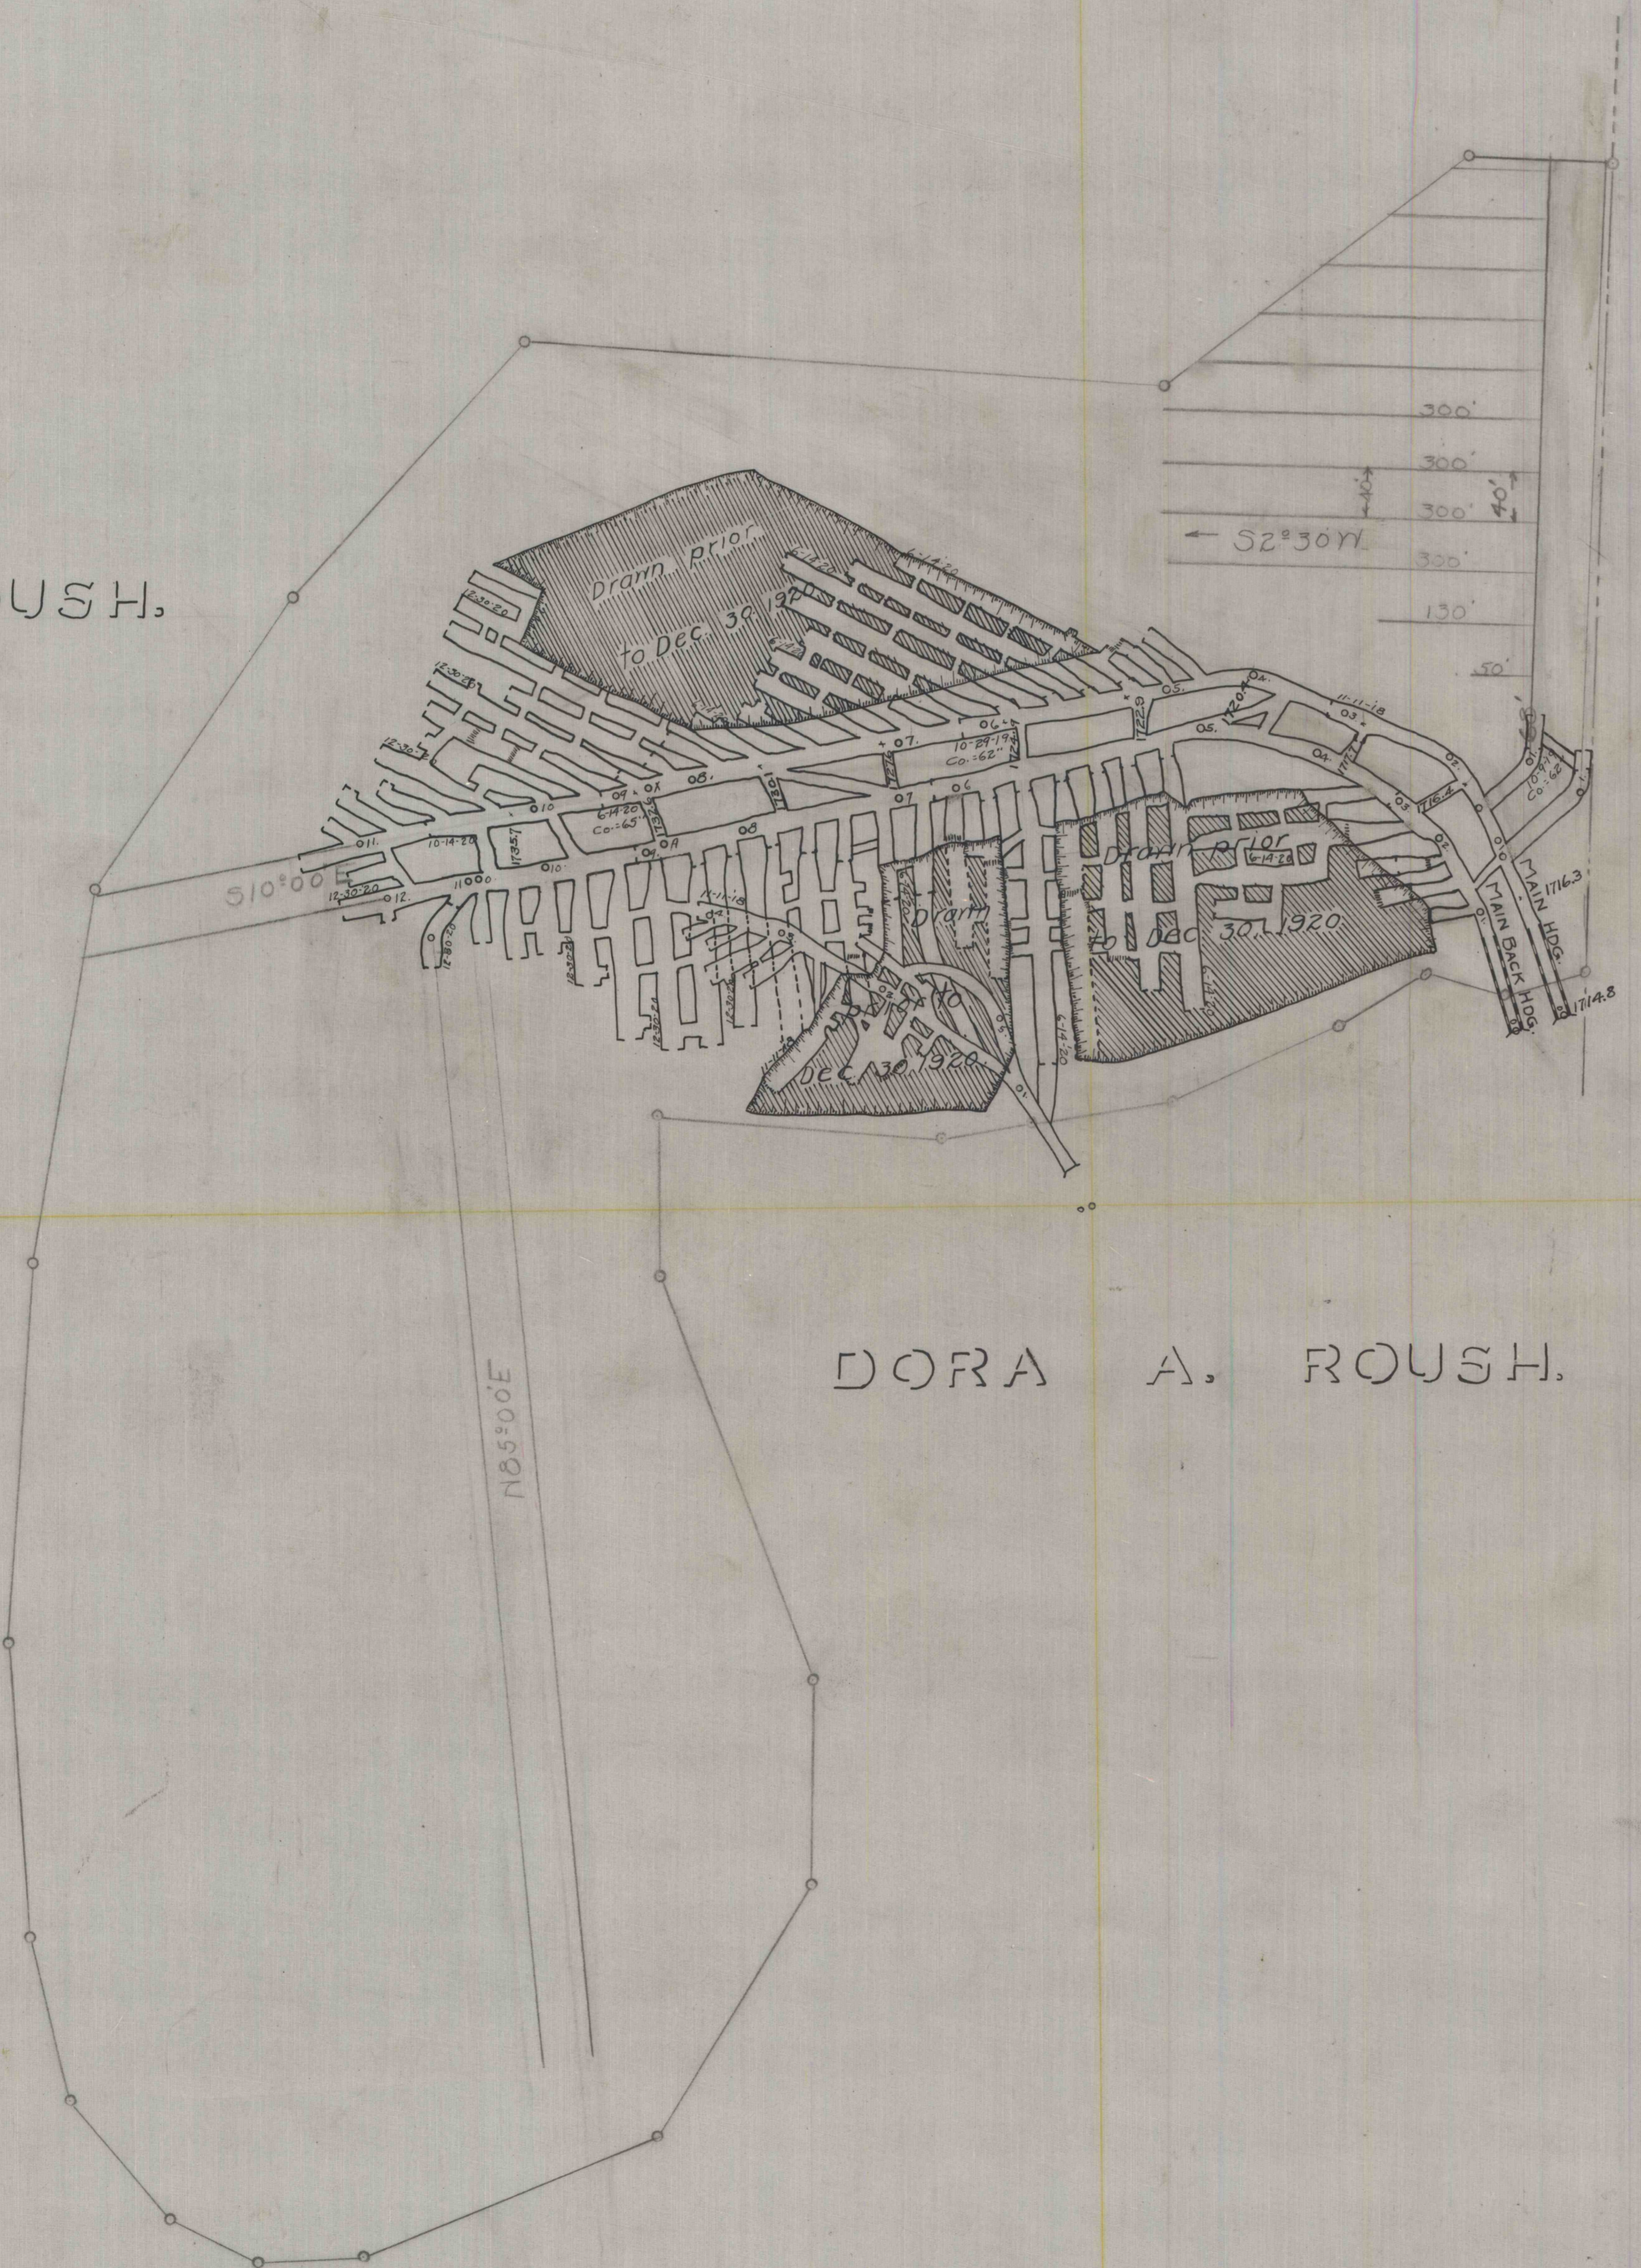

DORA A. ROUSH.

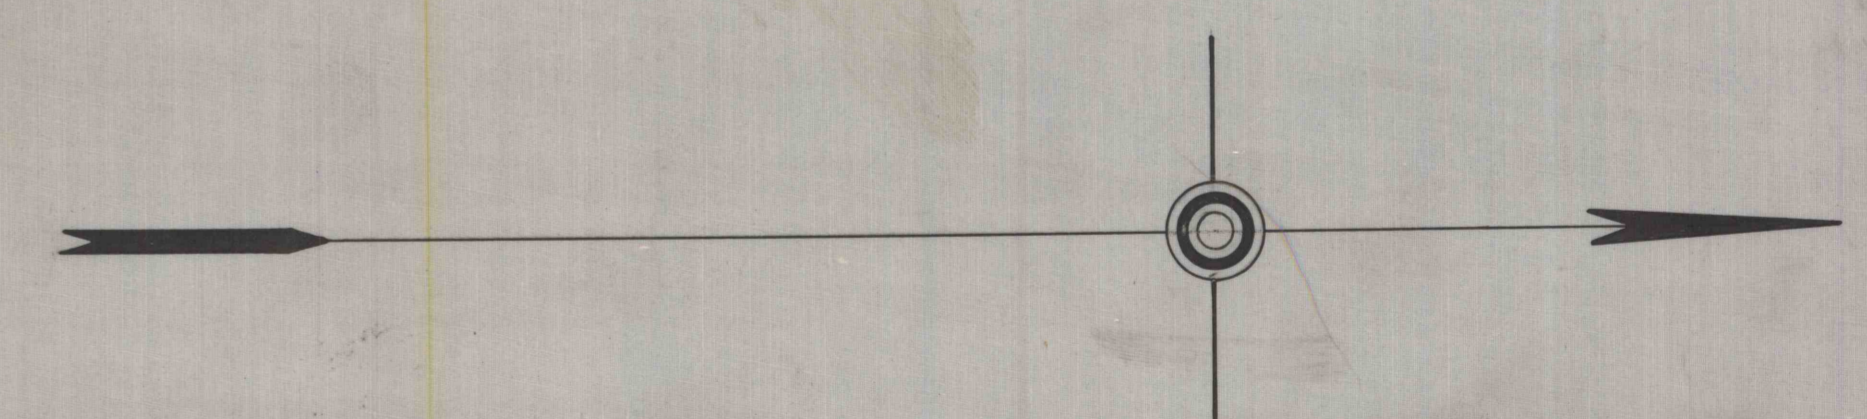

PUNXSU COAL MINING CO.
FRANCES NO 3

Scale 1 in = 100 ft.

H.M. Kanarr Engr.
Punxsutawney Pa.

4000.0 North

5000.0 North

6000.0 North