


GEO. EMERICK



MAP
OF
COAL CO
MILLS, INDIANA CO, PA.
 Oct 1919
 The H.M. Kanarr Co.
 Engineers
 Punxsutawney, Pa.

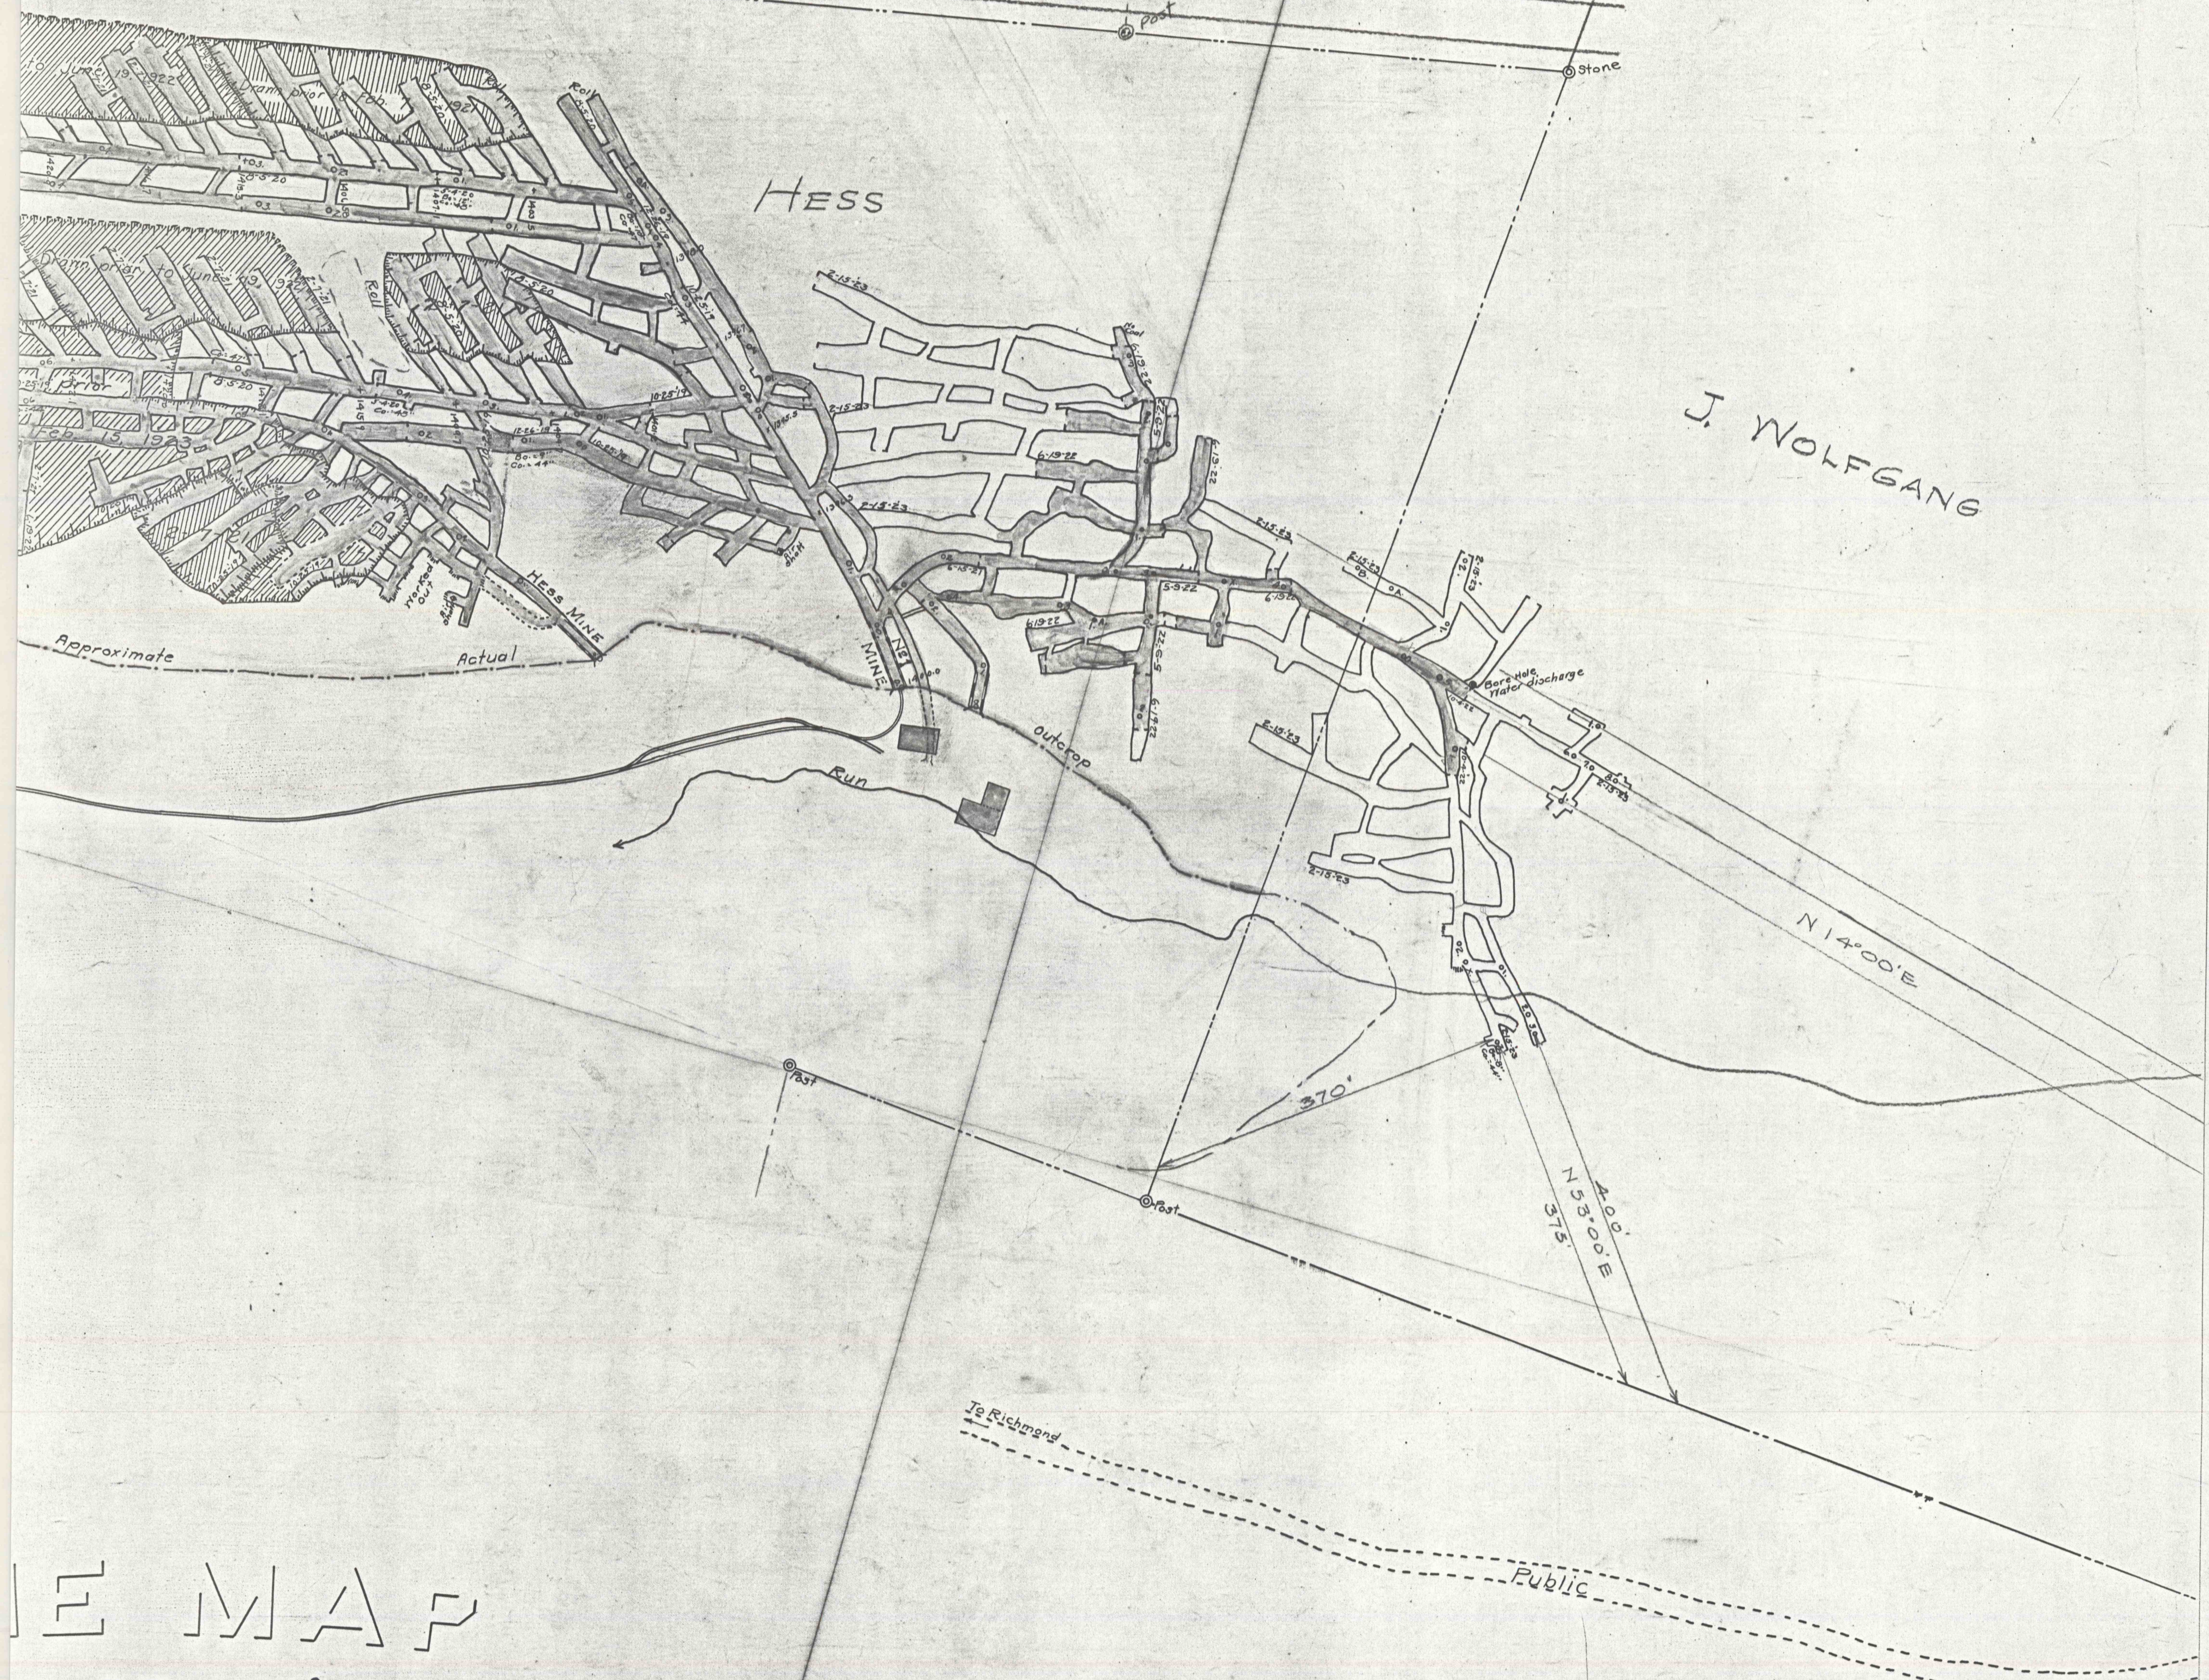