

W.H. LOWRY

EM. CRAWFORD

R.M. Coal Co  
Fee

R.M. Coal Co  
Fee  
(Town site)

No. 2  
MINE

Tramway


N42°30' W

1st Right

outcrop

4 of Proposed Plans

Present Tramway

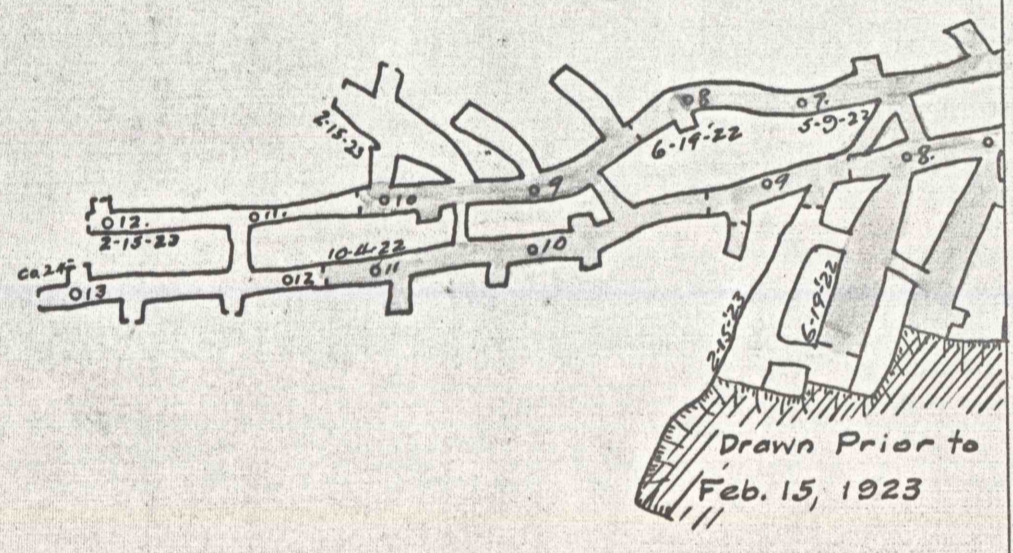

Drawn Prior to  
Feb. 15, 1923