


GEO. EMERICK

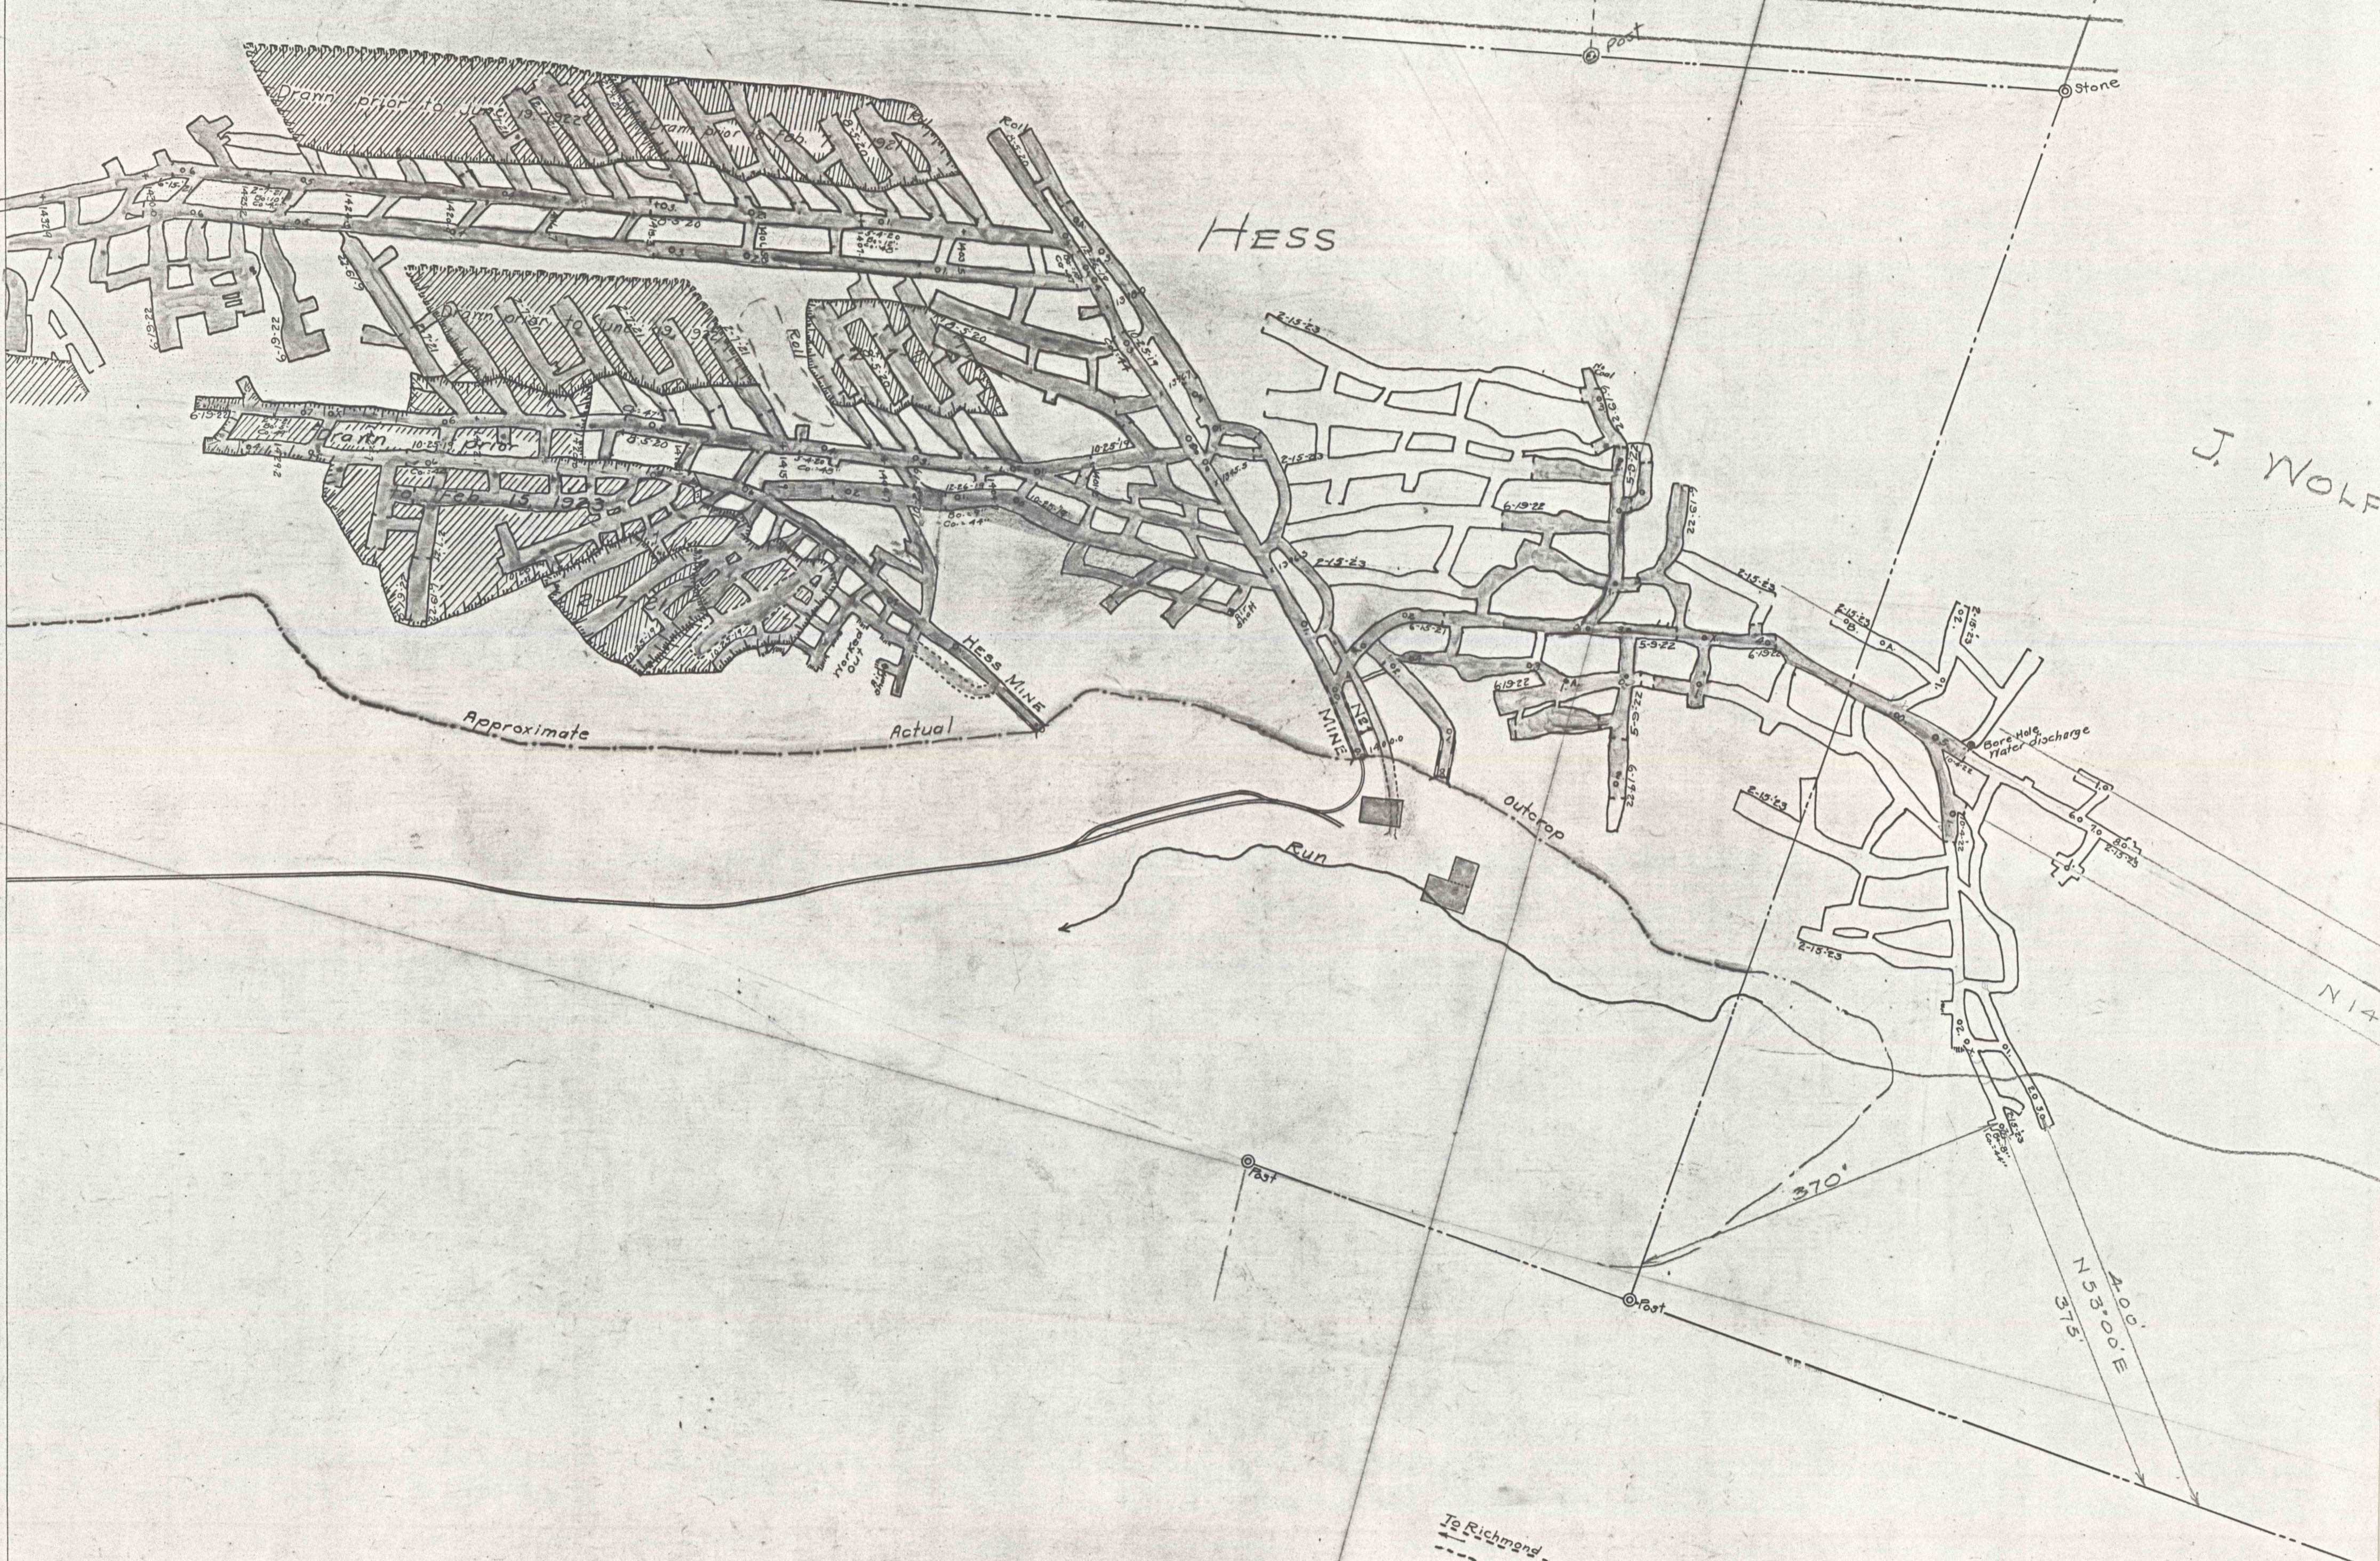

MINE MAP

OF

ROCHESTER MILLS COAL CO

ROCHESTER MILLS, INDIANA CO, PA.

Scale 1"=100' Oct 1919

The H.M. Kanarr Co.
Engineers
Punxsutawney, Pa.

Surveys
Oct. 25, 1919
Aug. 8, 1920
June 19, 1922
Feb. 15, 1923

3000 ft North