


IN-12

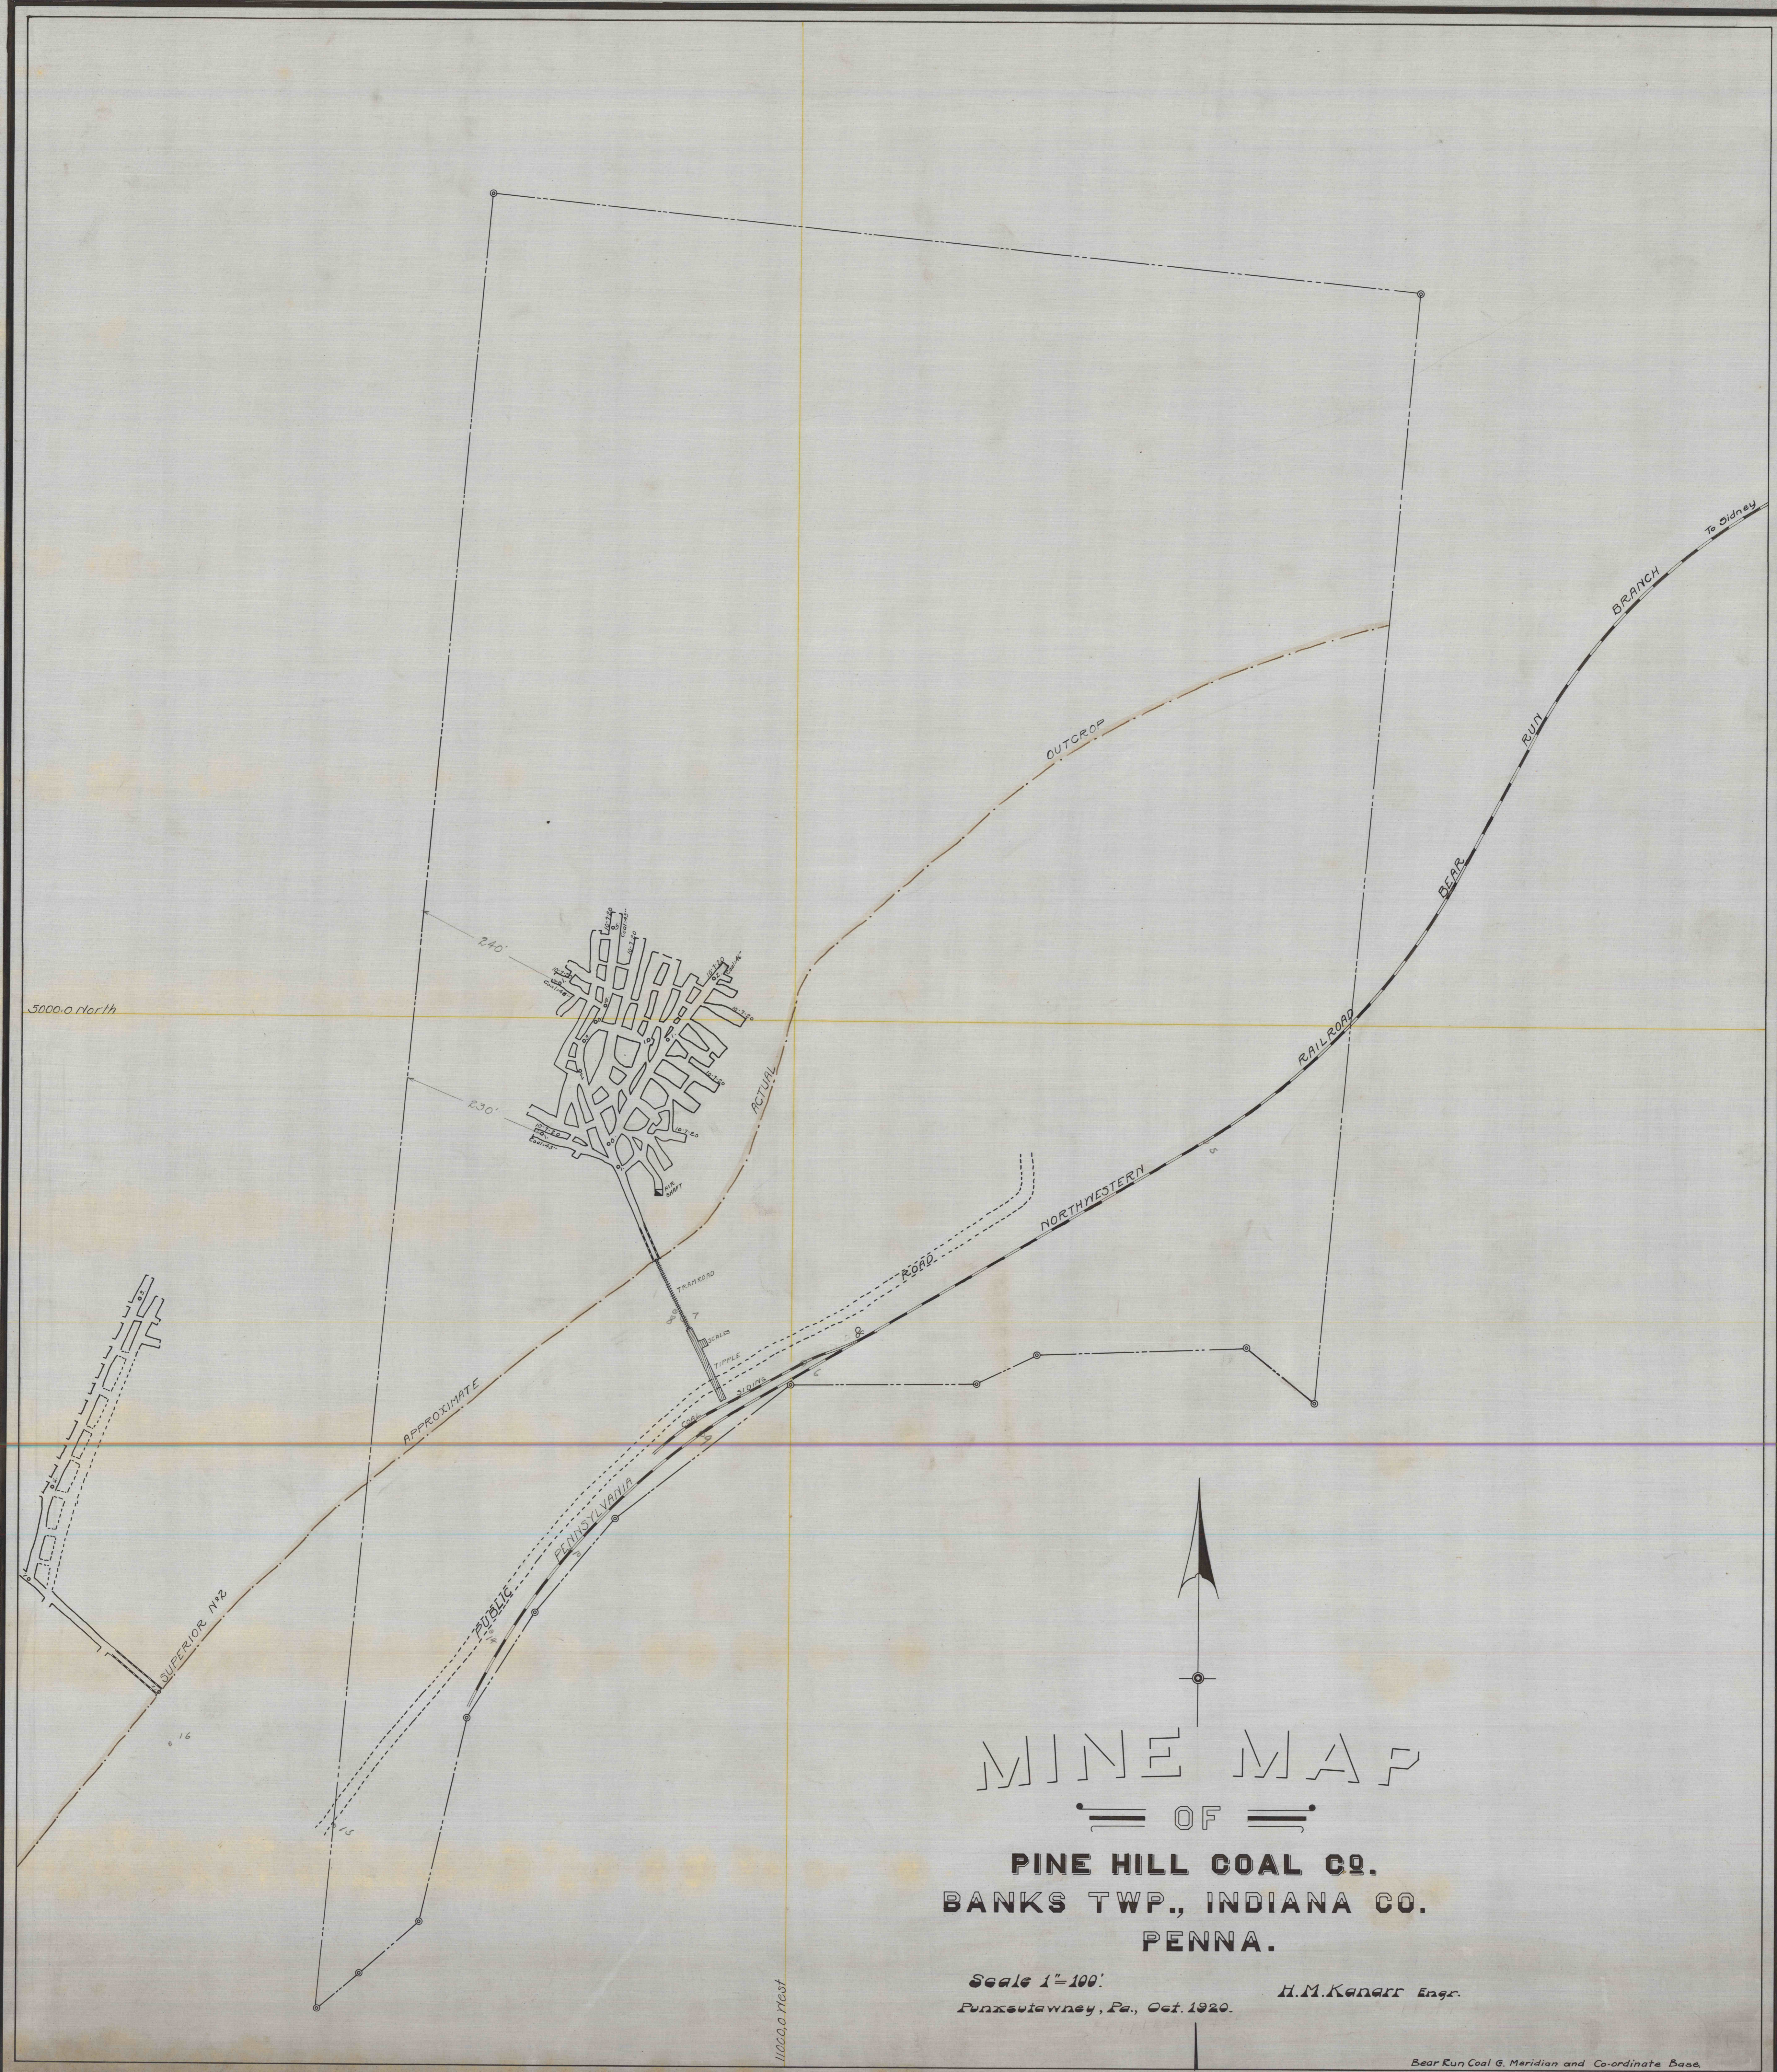

MINE MAP
OF
PINE HILL COAL CO.
BANKS TWP., INDIANA CO.
PENNA.

Scale 1"=100'
 Punxsutawney, Pa., Oct. 1920.
 H.M. Kenarr Engr.

Bear Run Coal Co. Meridian and Co-ordinate Base.

11000.0 West