




BANKS COLLIERY CO
 Banks Township Indiana Co. Pa.
 Scale 1 in. = 100 ft

SURVEYS	
11-15-16	Thos Peeler
3-28-17	" "
8-1-17	" "
1-23-18	H.M. Kaparr
8-21-18	" "
9-15-18	" "
4-8-20	" "
10-10-20	" "

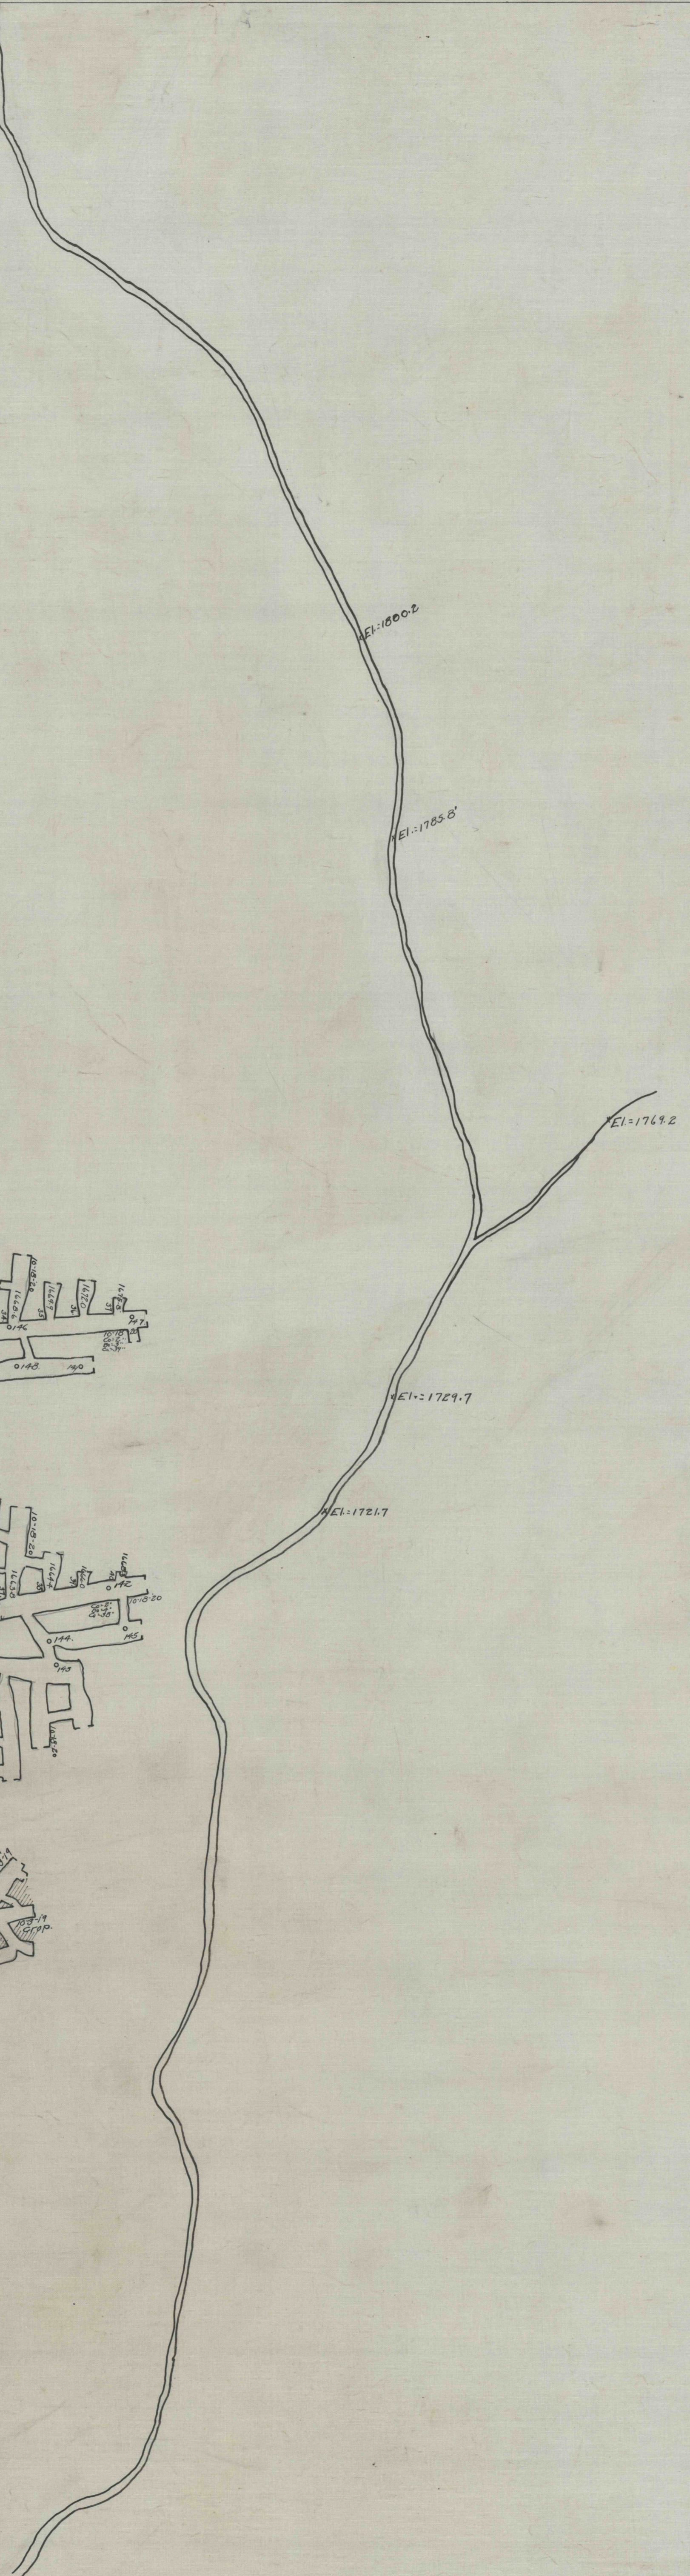

E1-1866.0

E1-1785.6

E1-1764.2

E1-1729.7

E1-1717