

TM-28

J. WAKEFIELD

D. WOODS

J. WAKEFIELD


GARFIELD REFRACTORIES CO.

T.S. LYNN



I.C. LICHTENFELS

EDWARD BOWSER

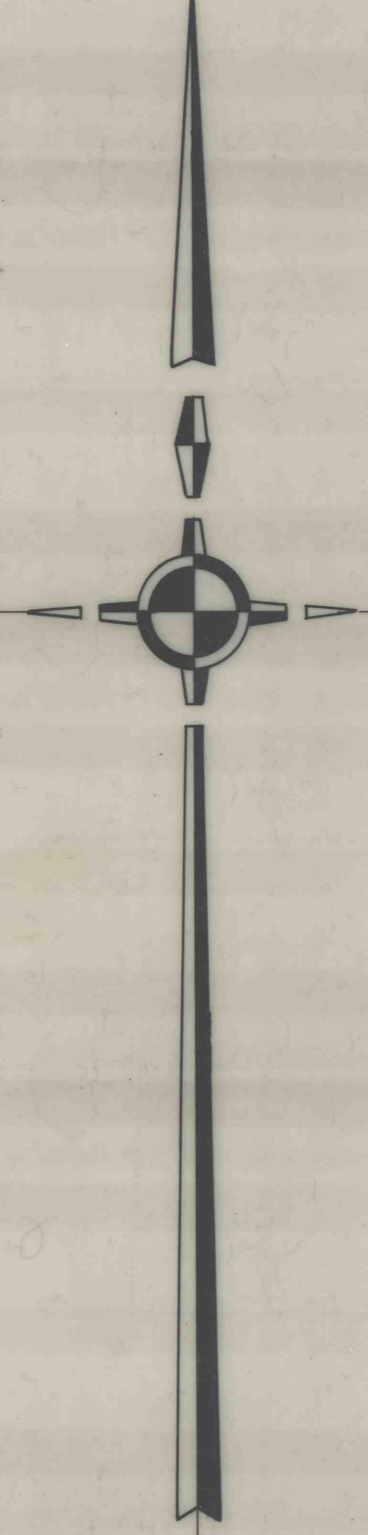


MAP SHOWING  
**THOMPSON COAL CO.**  
 MINE NO 3

SITUATE IN  
 WEST WHEATFIELD TWP., INDIANA CO., PA.

SCALE: 1 IN. = 100 FT.      DATE OF SURVEY: FEB. 7, 1958

LEWIS L. GWIN - CONSULTING ENGINEERS  
 ALTOONA, PENNA.  
 JOHN W. FOREMAN, MINING ENGINEER

*John W. Foreman*

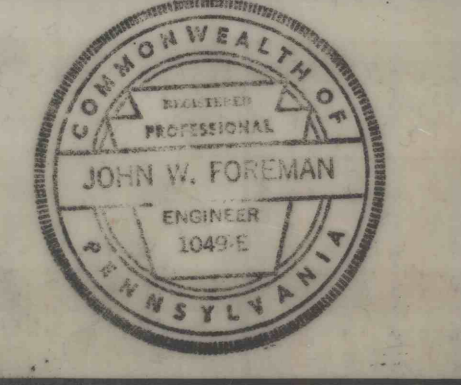

*Handwritten notes and signatures in the right margin.*