
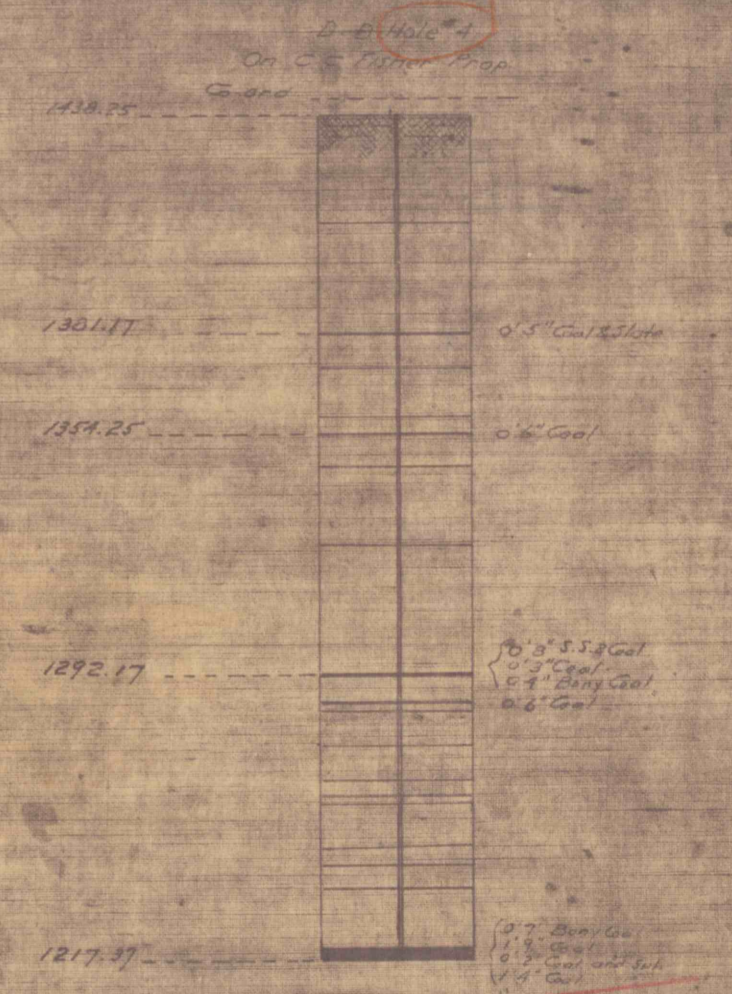


VERTICAL 1/250

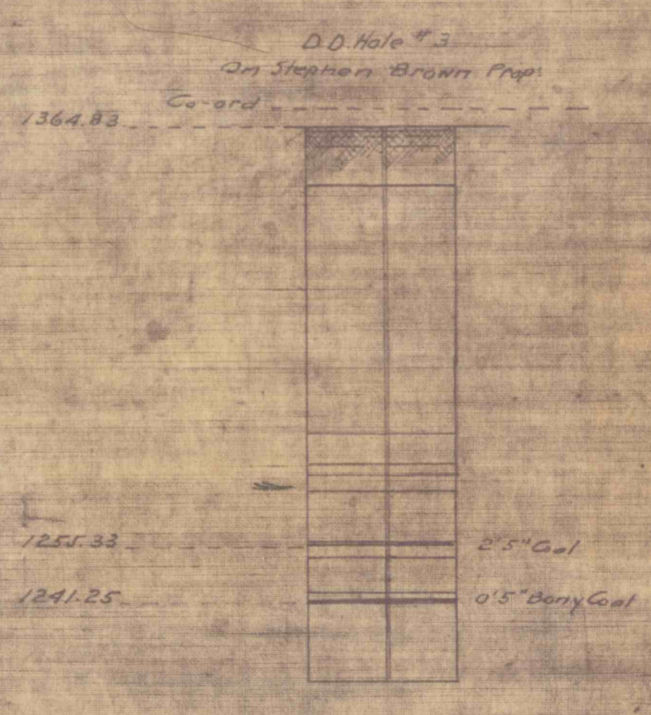

Vinton Colliery Company  
Tidal Elevations of  
**BORE HOLES & COAL OPEN**  
at and adjoining  
**Claghorn, Pa.**  
Scale 1" = 50'  
Claghorn, Pa.  
May 20, 1918