


2-11

LOWMASTER.

GRIFFITH.

SEGARS.

DINGER & STARISELL.

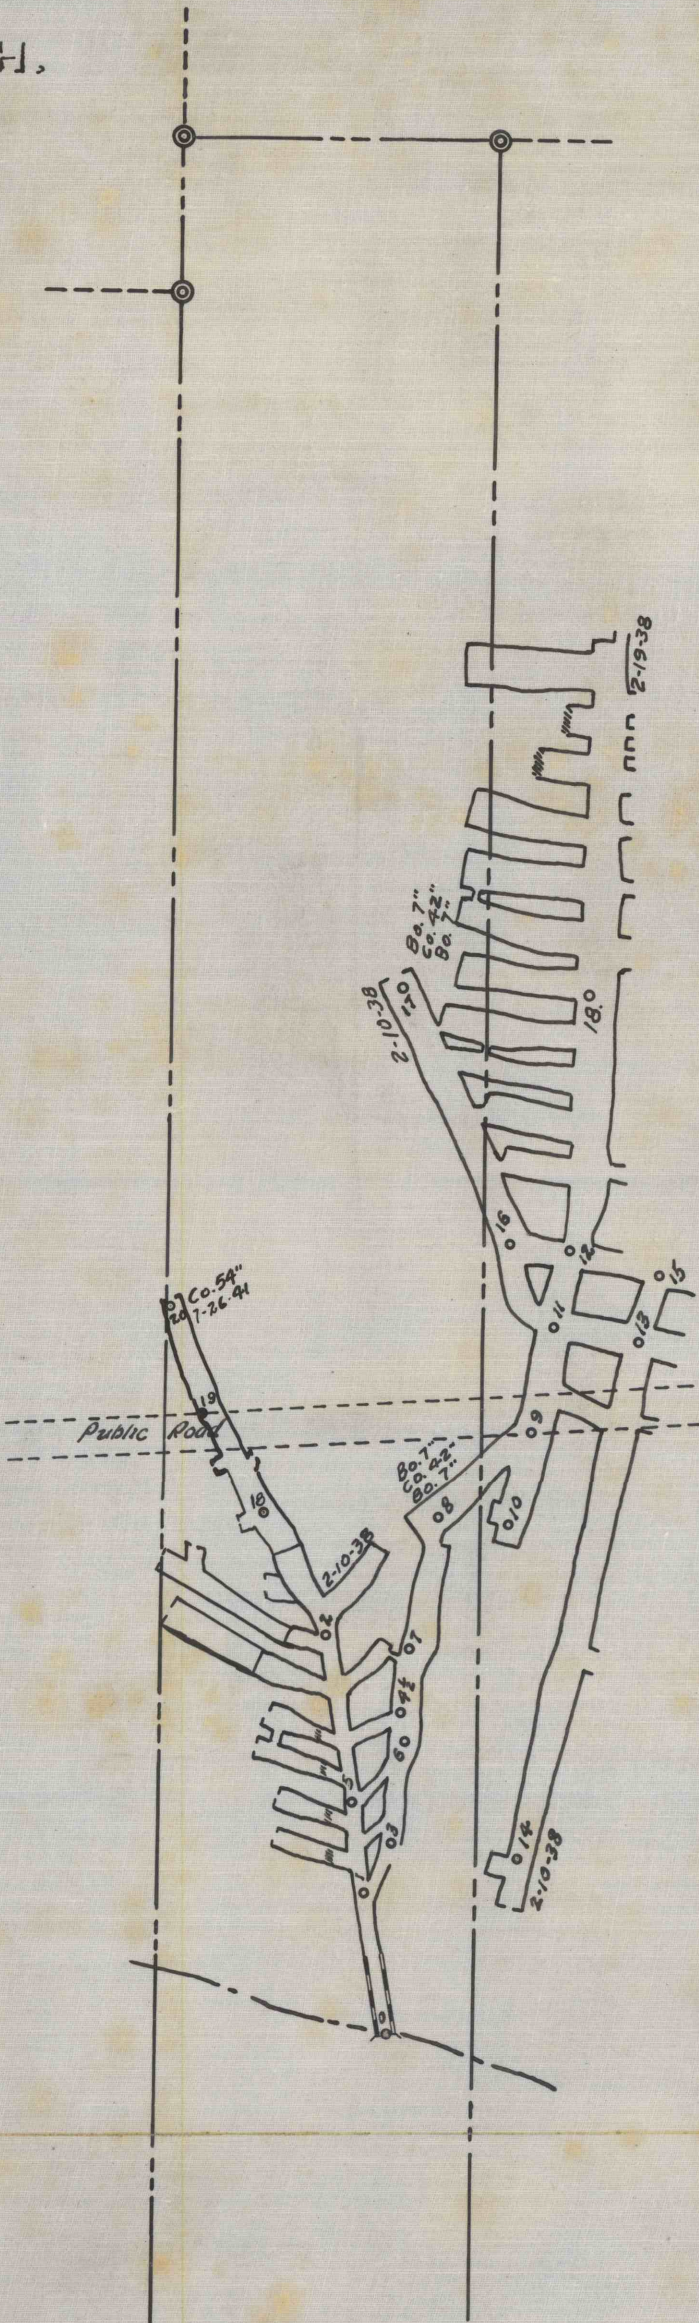

MINE MAP
- FOR -
THOMAS ORGAN
BANKS TWP., INDIANA CO., PA.
SCALE 1"=100' FEBRUARY, 1938

Notes: M-26 Pg. 25-59
Drawing: 2-0-7
Tracing: 2-0-7
Traverse: L.L.T.B. Vol. #1

Harry M. Walker
Engineer
Pittsburgh, Pa.

Notes:
Drawing:
Tracing:
Traverse: