


Bituminous Coal Corporation

Center Top
Indiana City
M. Evans

Highway

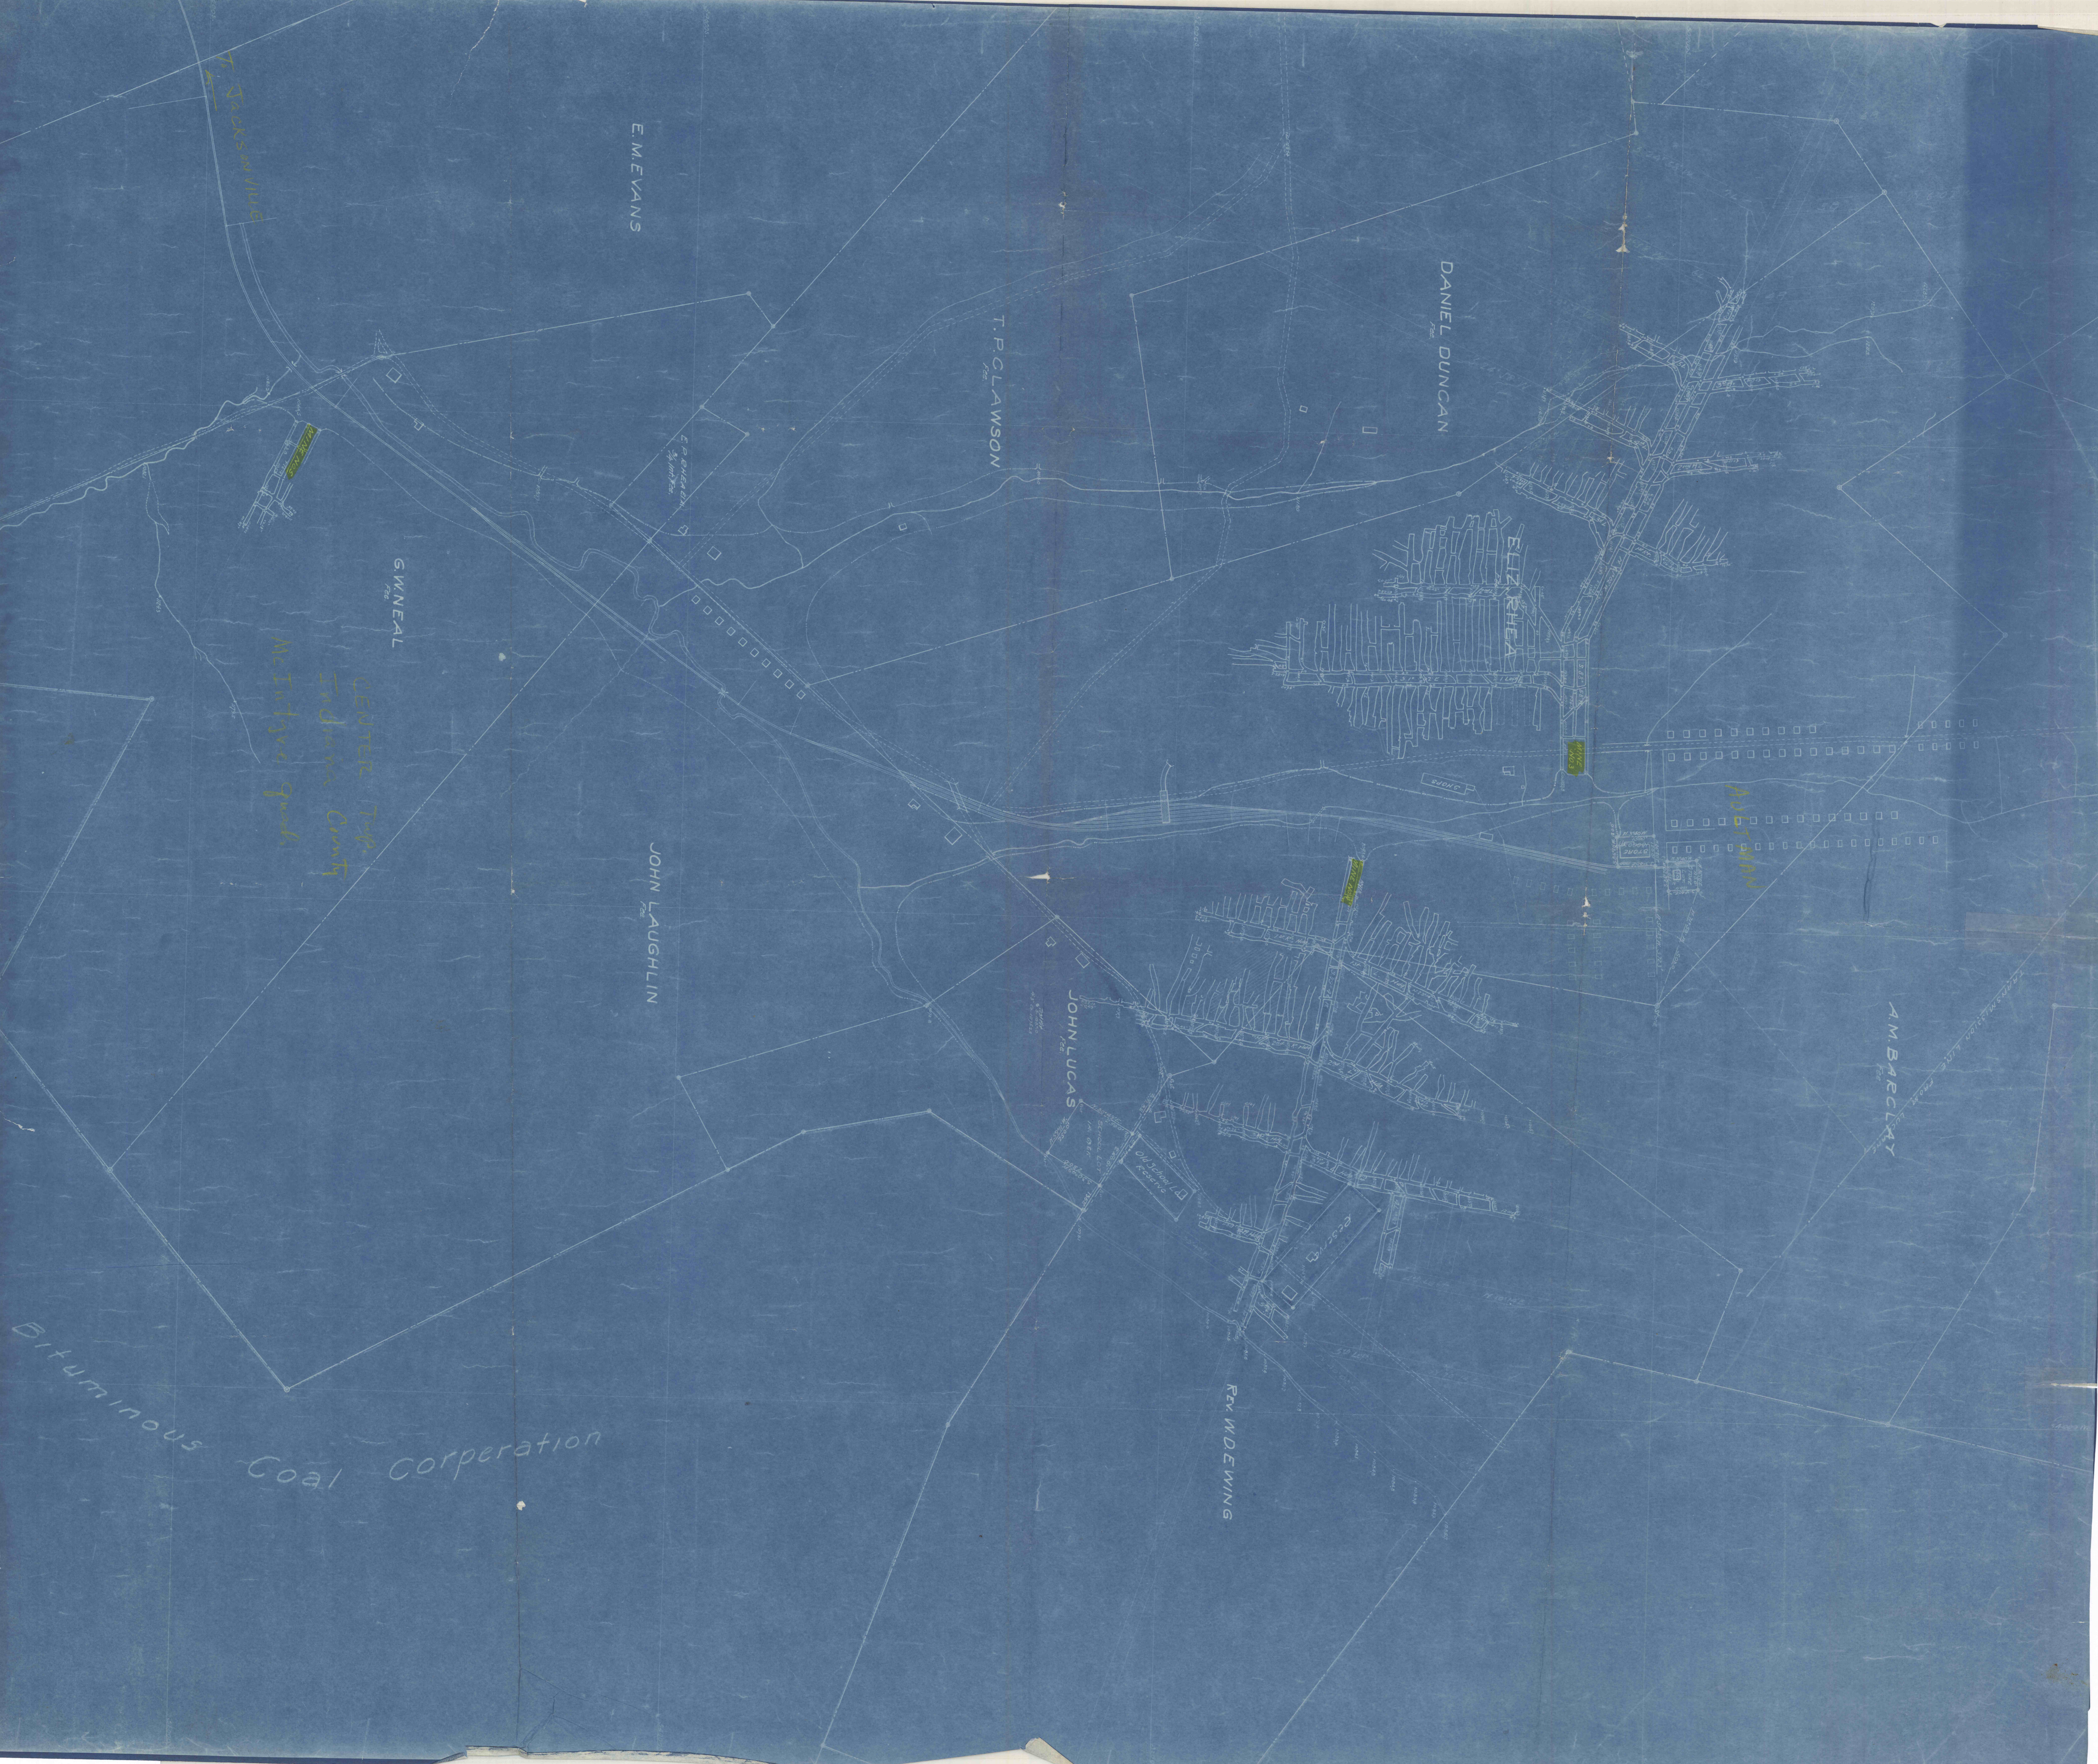


E. M. EVANS

T. P. CLAWSON

DANIEL DUNCAN

G. W. NEAL

JOHN LAUGHLIN

JOHN LUCAS

Rev. W. DE WING

A. M. BARCLAY

ELZEBETHA

