

LULA CLAWSON Surf.

W.E. BOWLIN Surf.


H.E. CLARK INT. Surf.

C.B.C. CORP. Fee

C.B.C. CORP. Fee

A.R.E. Bros.  
1940-48 P.

C. Barr  
37 31 51 P.

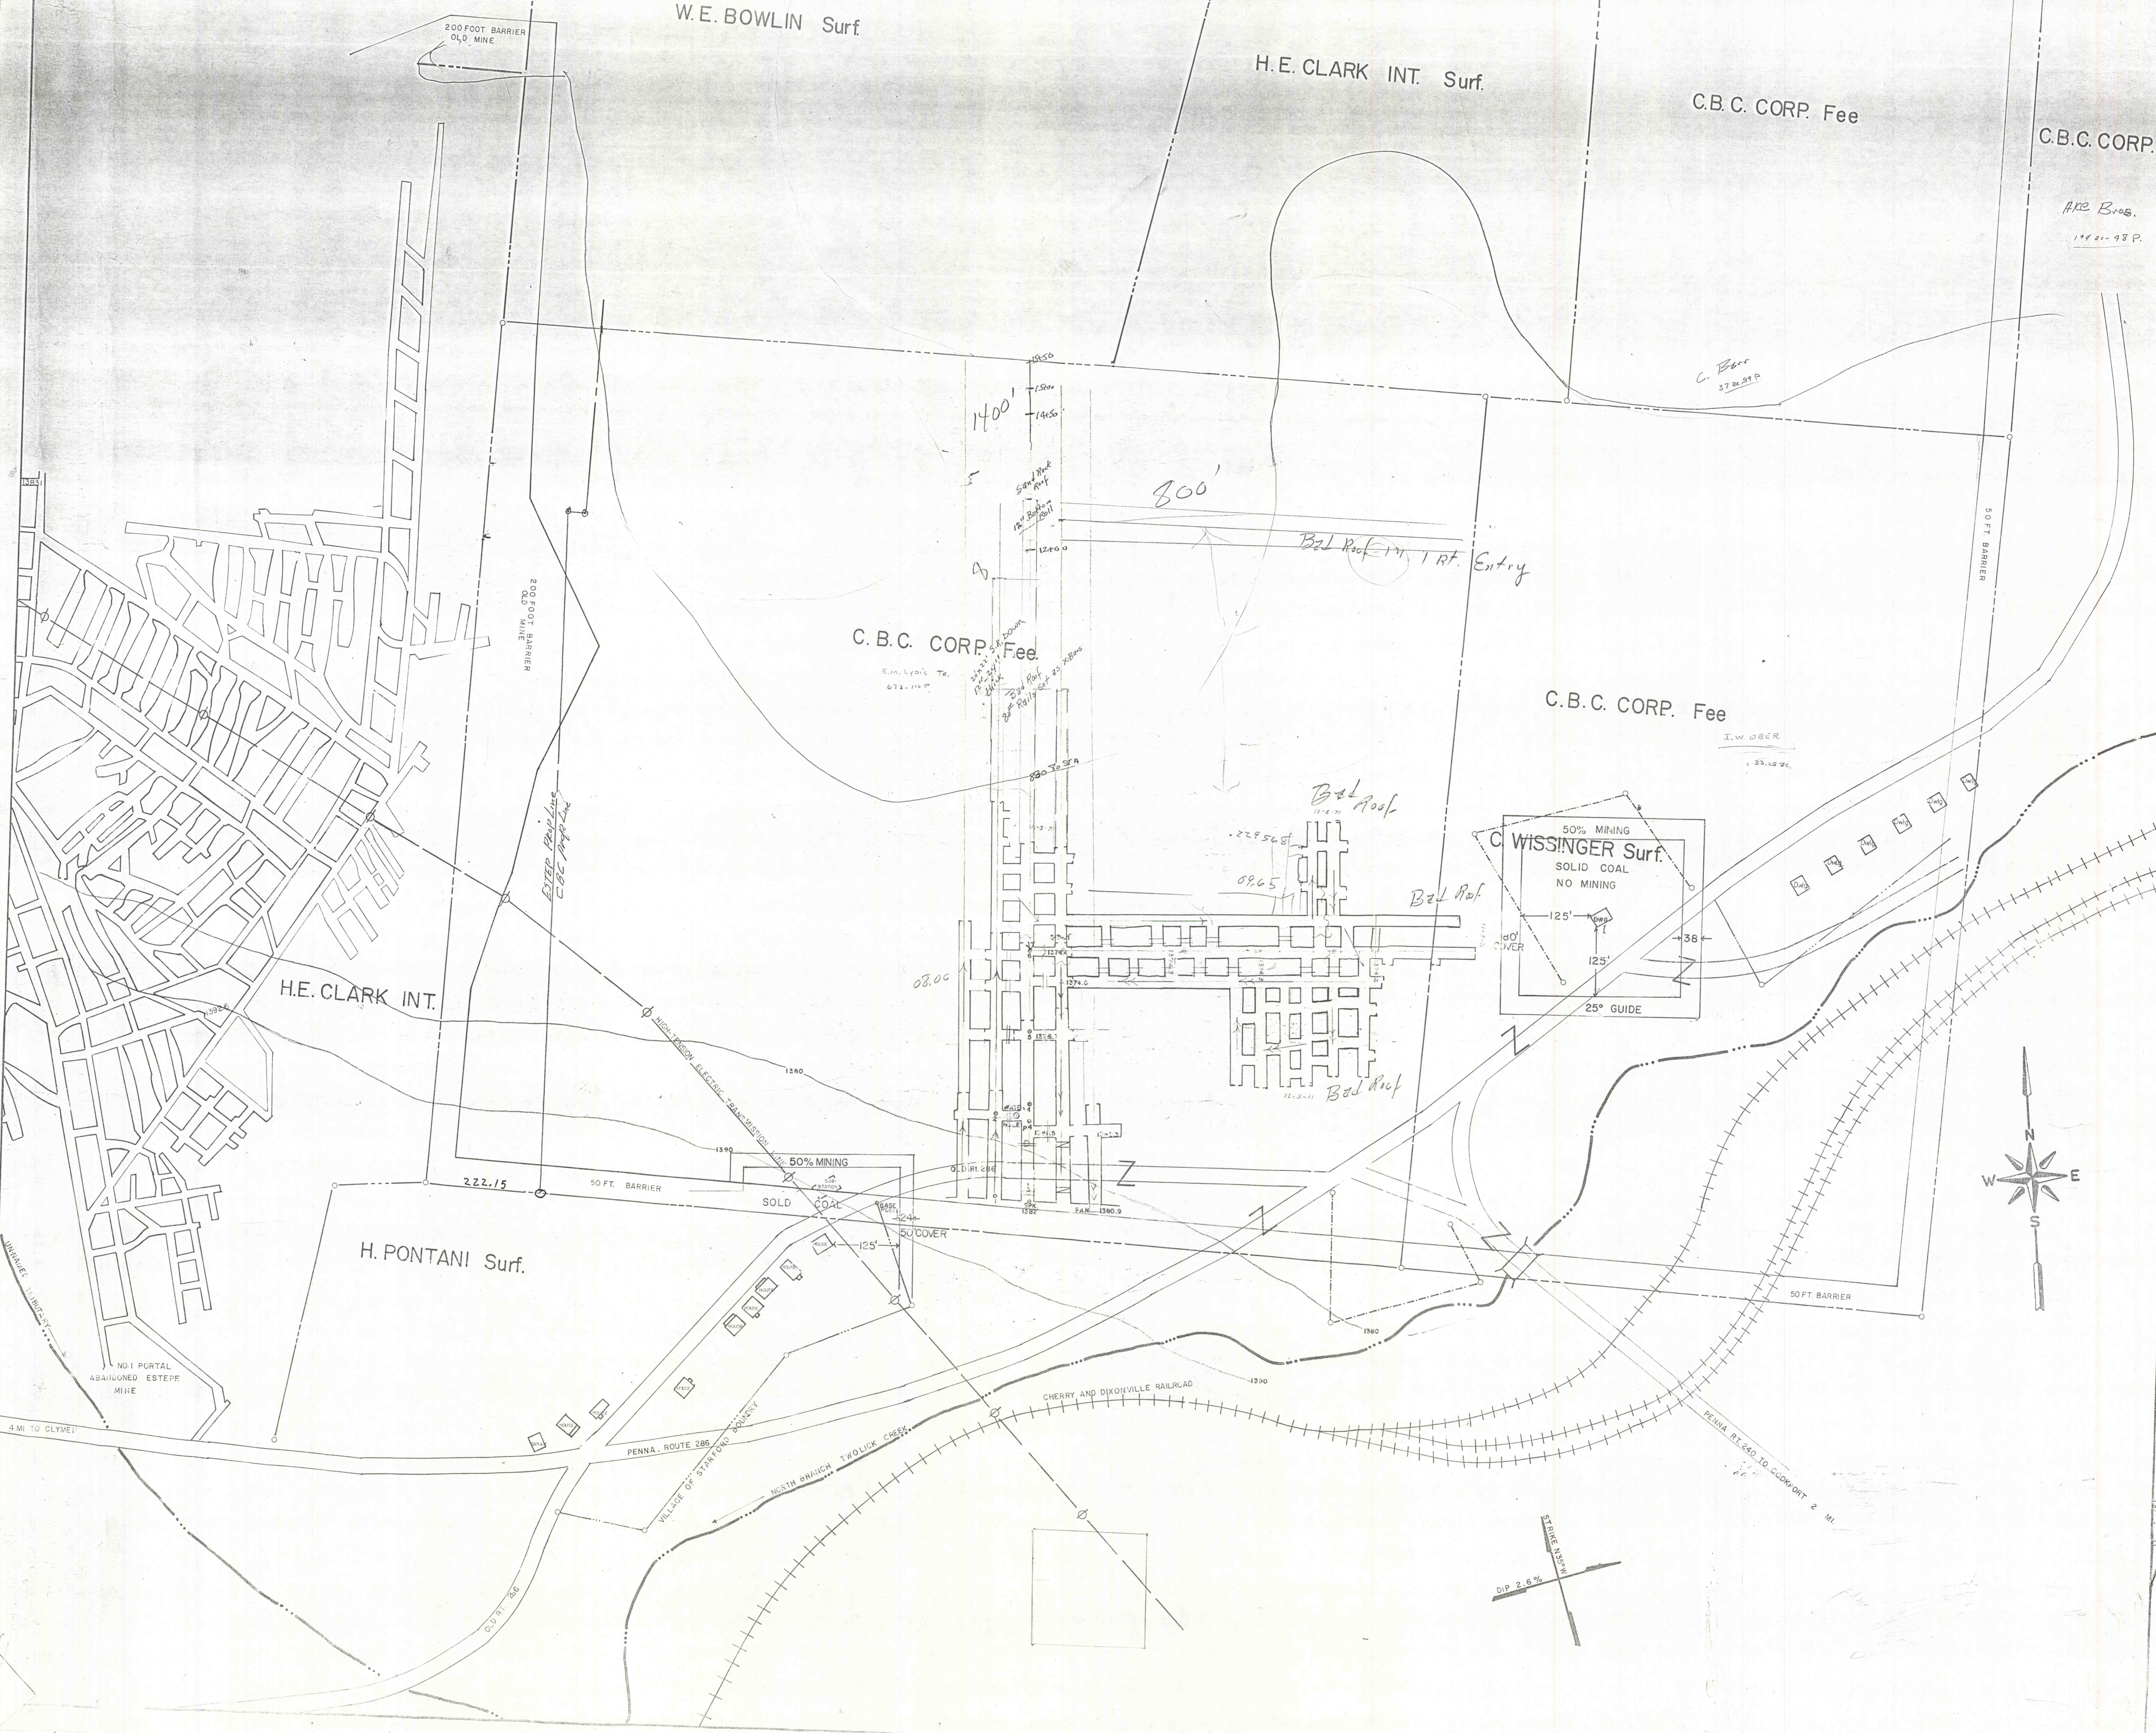

C.B.C. CORP. Fee  
E.M. Lyric Tr.  
672.114 P.

C.B.C. CORP. Fee  
I.W. OBER  
25.25 P.

C. WISSINGER Surf.  
50% MINING  
SOLID COAL  
NO MINING  
125'  
125'  
25° GUIDE  
38'

H. PONTANI Surf.

50% MINING  
SOLD COAL


CHERRY AND DIXONVILLE RAILROAD

PENNA. ROUTE 286



DIP 2.6%

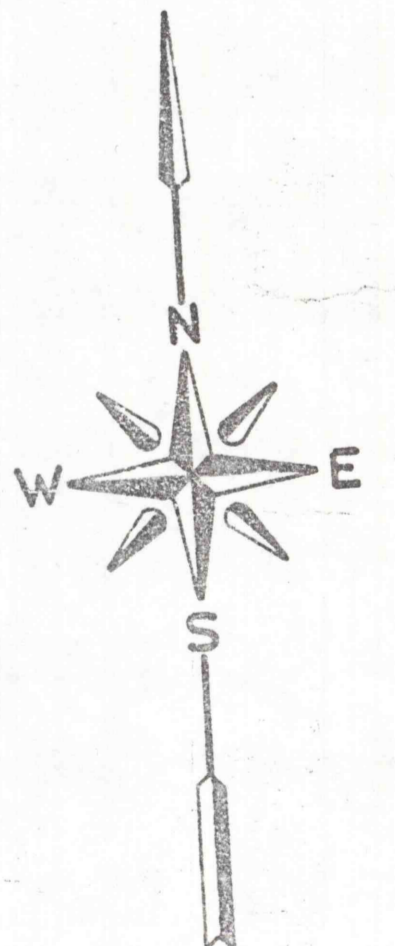

NDI PORTAL  
ABANDONED ESTEPE  
MINE

4 MI TO CLYMER

OLD RT. 286


50 FT. BARRIER

50 FT. BARRIER

200 FOOT BARRIER  
OLD MINE

C.B.C. Property

HIGH TENSION ELECTRIC TRANSMISSION LINE

08.00

09.65

1400'

800'

Bal Roof Entry T.R.T. Entry

Bal Roof

Bal Roof

Bal Roof

222.15

1390

1390

