


NO MINING IN THIS AREA

NO MINING IN THIS AREA

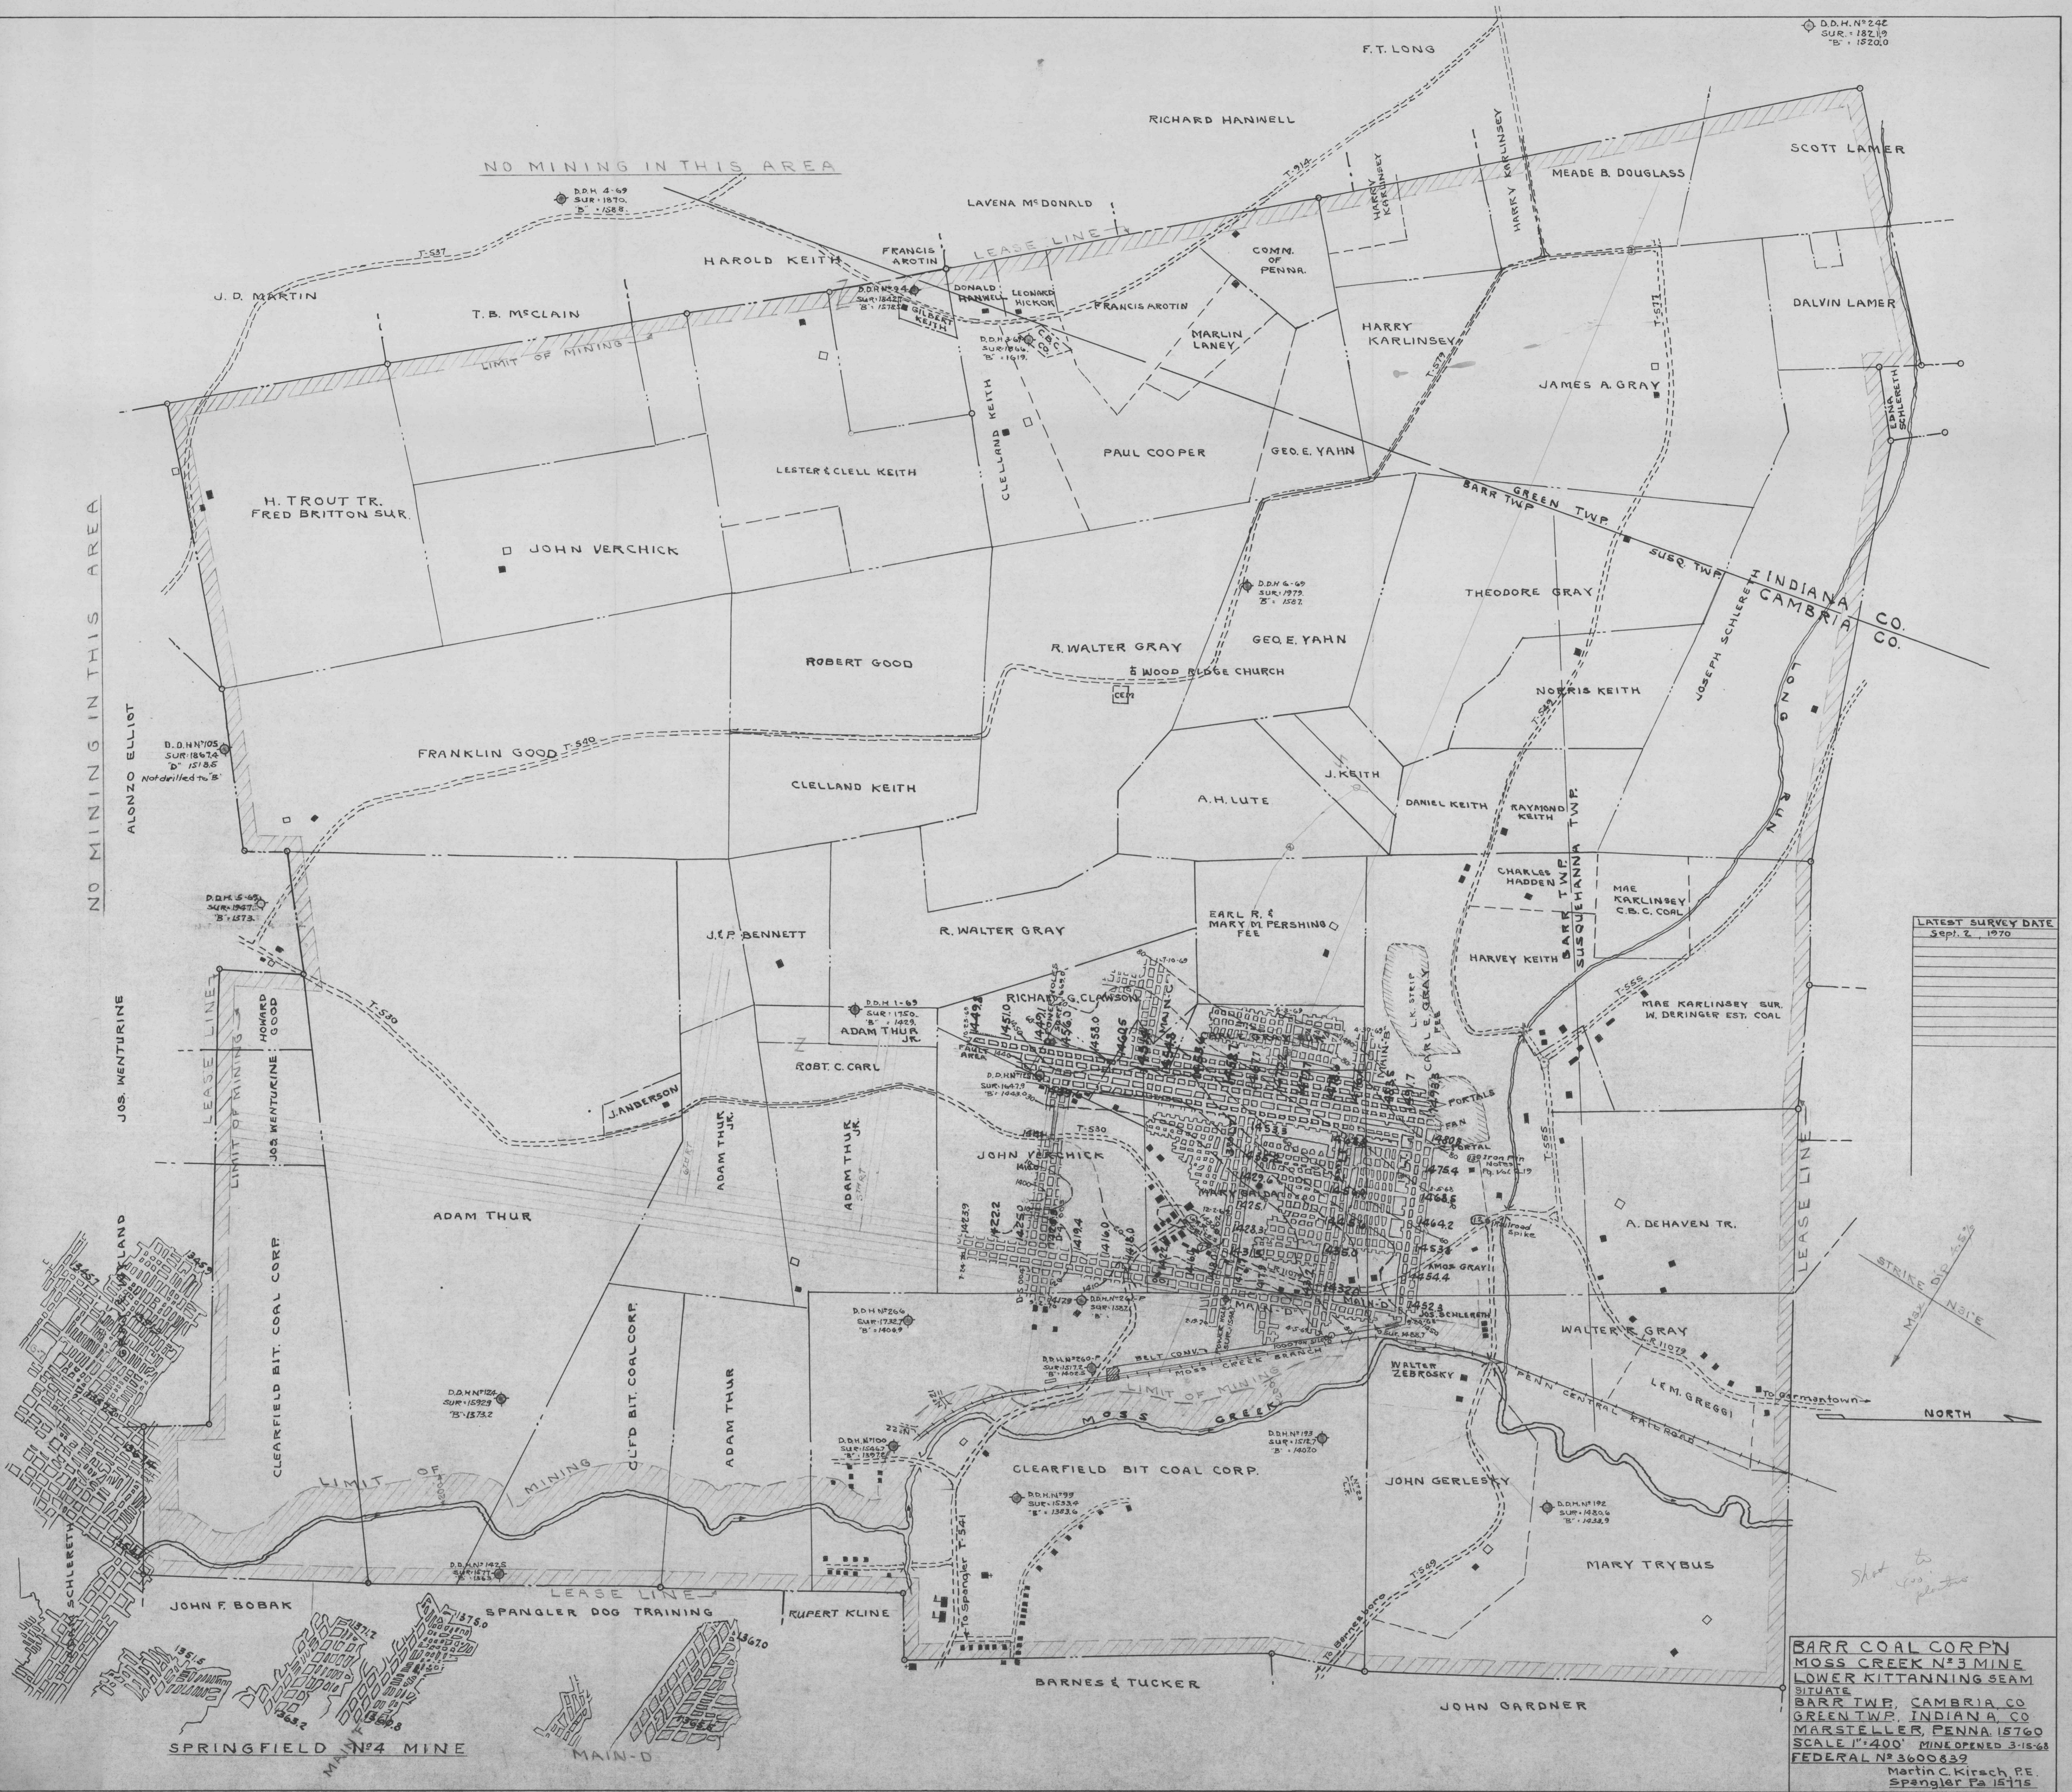

LATEST SURVEY DATE  
Sept. 2, 1970

BARR COAL CORP  
MOSS CREEK N°3 MINE  
LOWER KITTANNING SEAM  
SITUATE  
BARR TWP, CAMBRIA CO  
GREEN TWP, INDIANA CO  
MARSTELLER, PENNA. 15760  
SCALE 1"=400' MINE OPENED 3-15-68  
FEDERAL N° 3600832  
Martin C. Kirsch P.E.  
Spangler Pa 15715

Shot to  
plant

SPRINGFIELD N°4 MINE

MAIN-D