



NO MINING IN THIS AREA

NO MINING IN THIS AREA

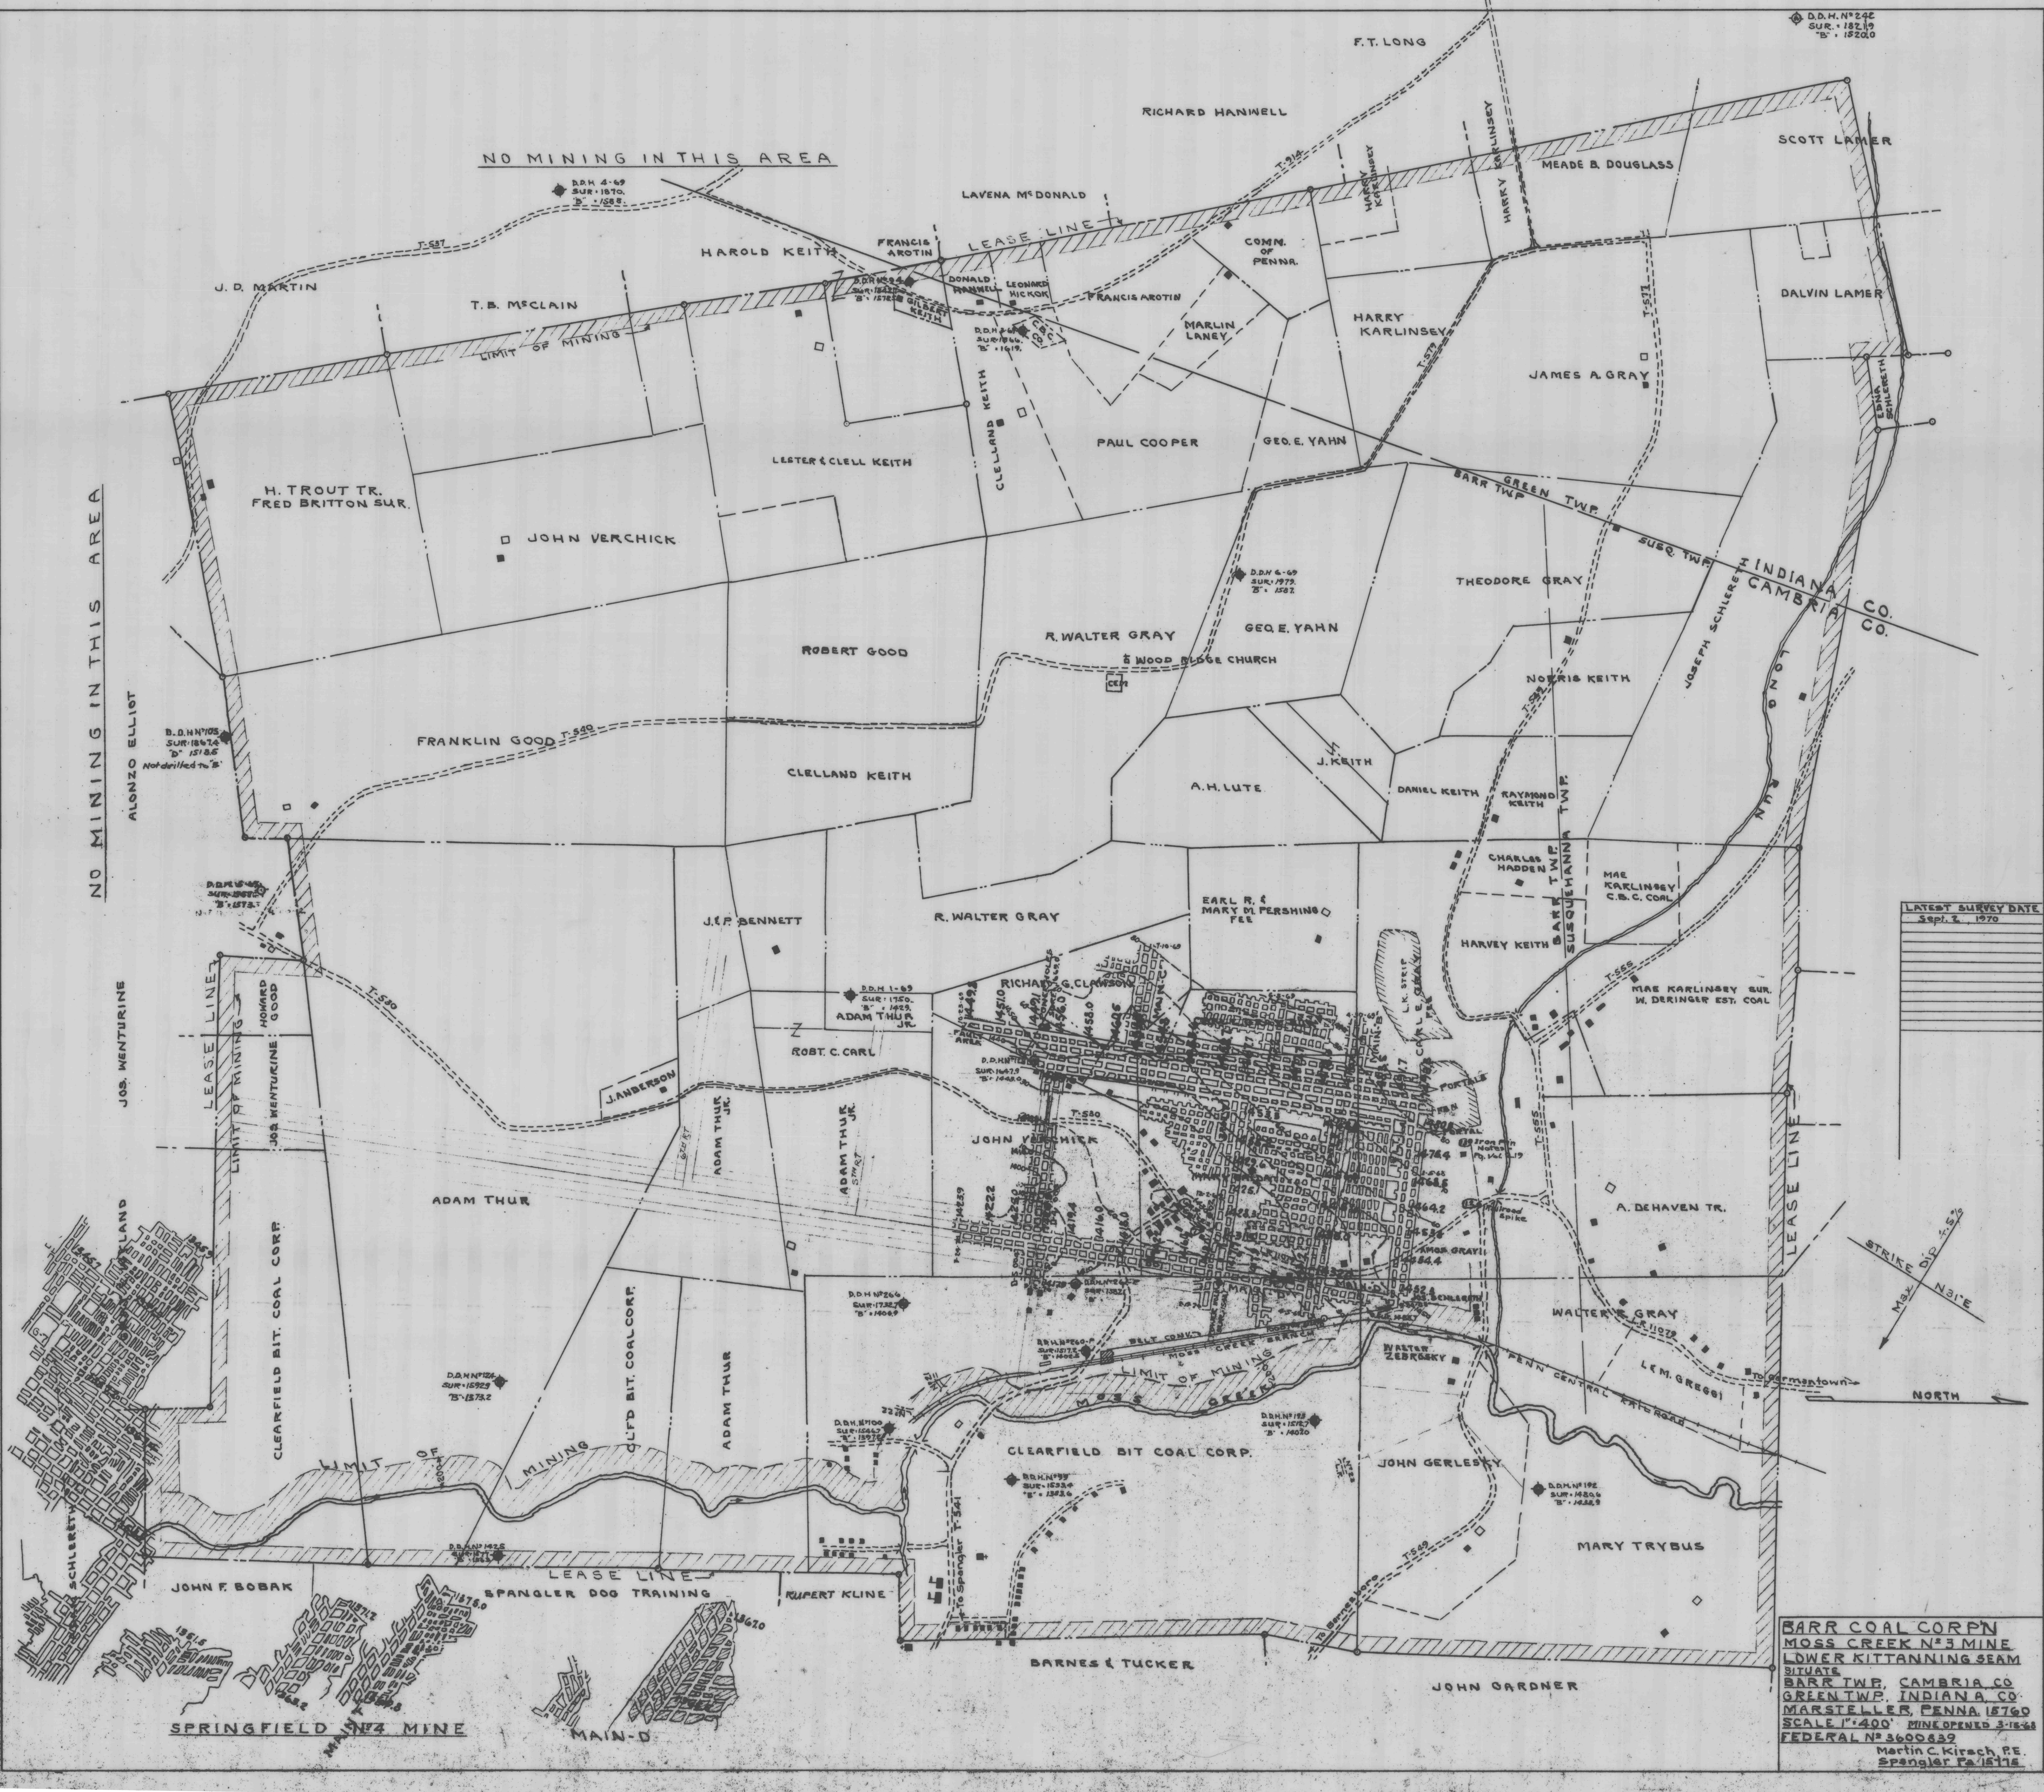

LATEST SURVEY DATE
Sept. 2, 1970

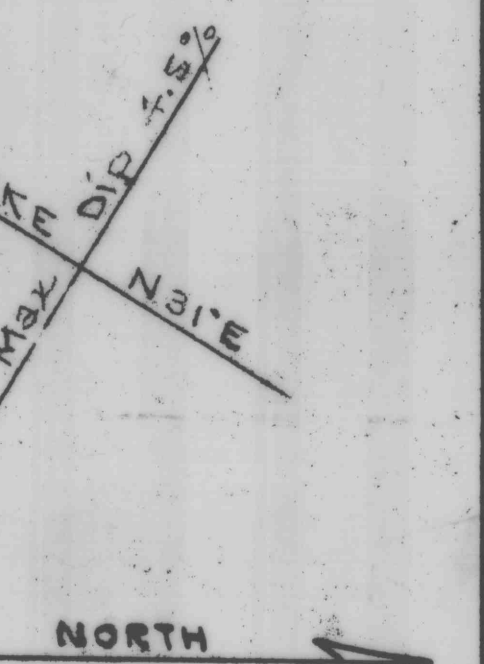

BARR COAL CORPN
MOSS CREEK NO. 3 MINE
LOWER KITTANNING SEAM
 SITUATE
 BARR TWP, CAMBRIA CO
 GREEN TWP, INDIANA CO
 MARSTELLER, PENNA 15760
 SCALE 1"=400' MINE OPENED 3-15-68
 FEDERAL No. 3600839
 Martin C. Kirach, P.E.
 Spangler Pa 15775

SPRINGFIELD NO. 3 MINE

MAIN-D

BARNES & TUCKER

JOHN GARDNER