

PENN

MARY

COAL

LEASEHOLD

ROAD



KALANSEY

DANIEL

KALANSEY

DANIEL

Barnesboro
4243

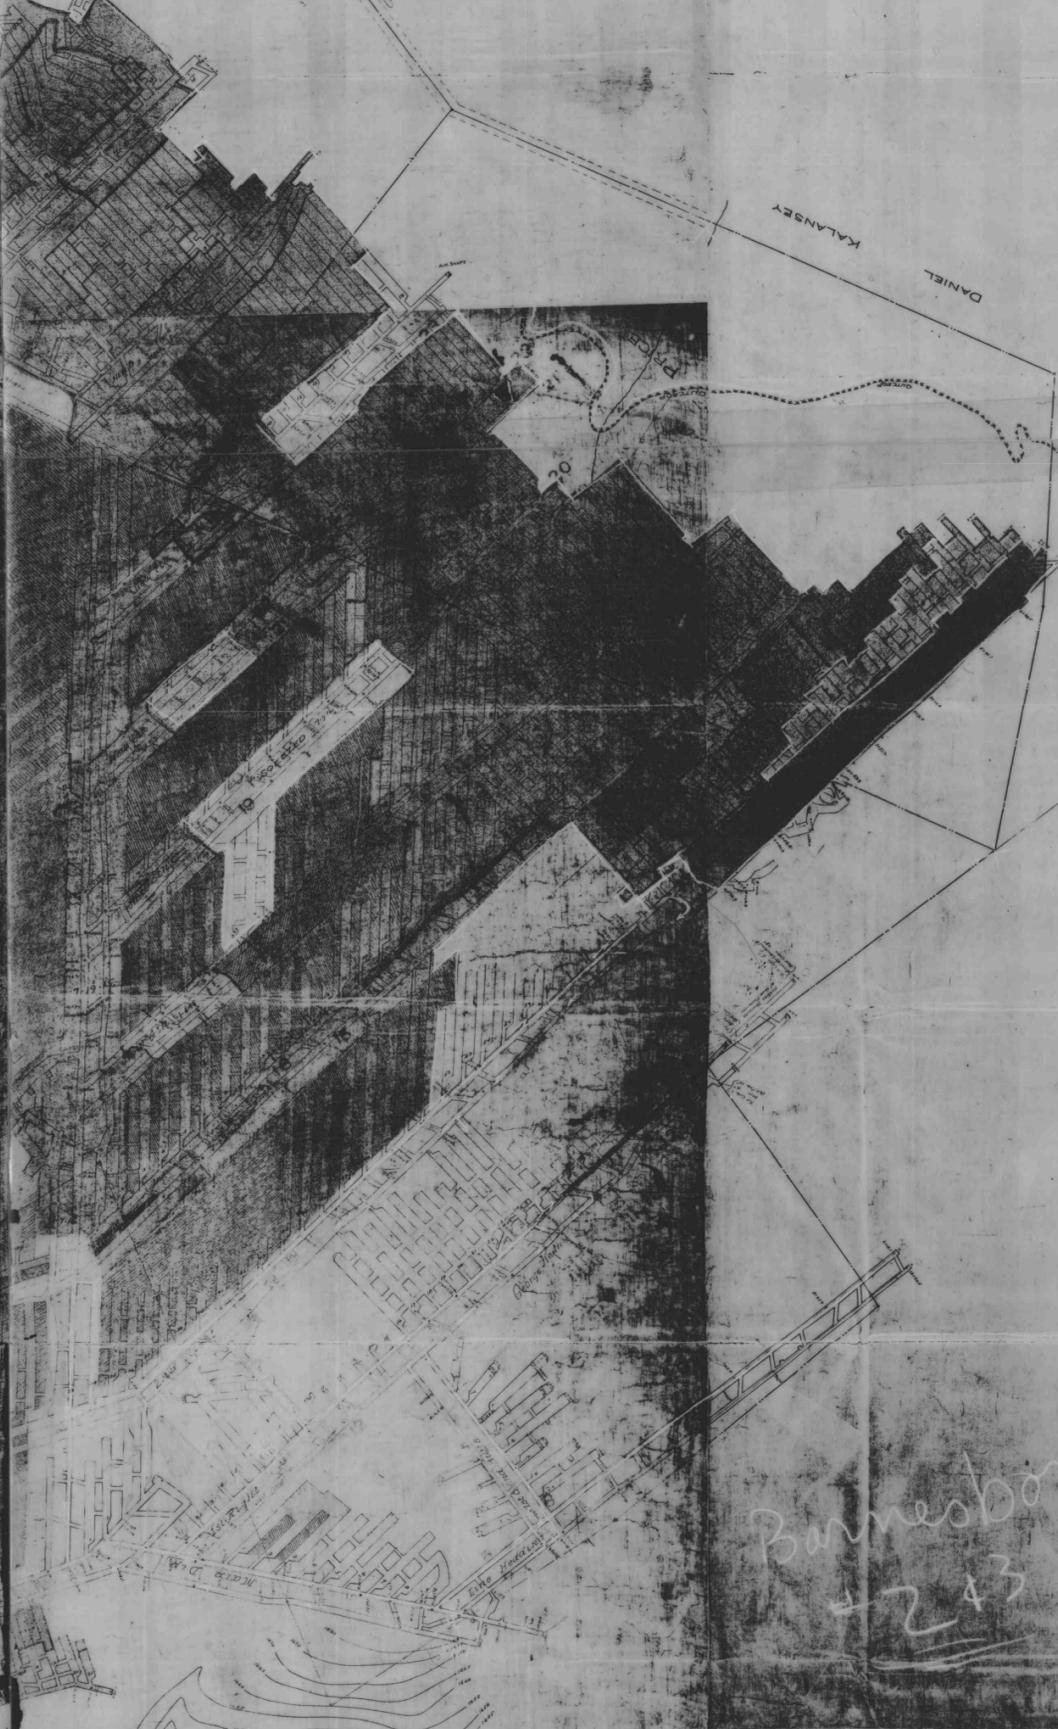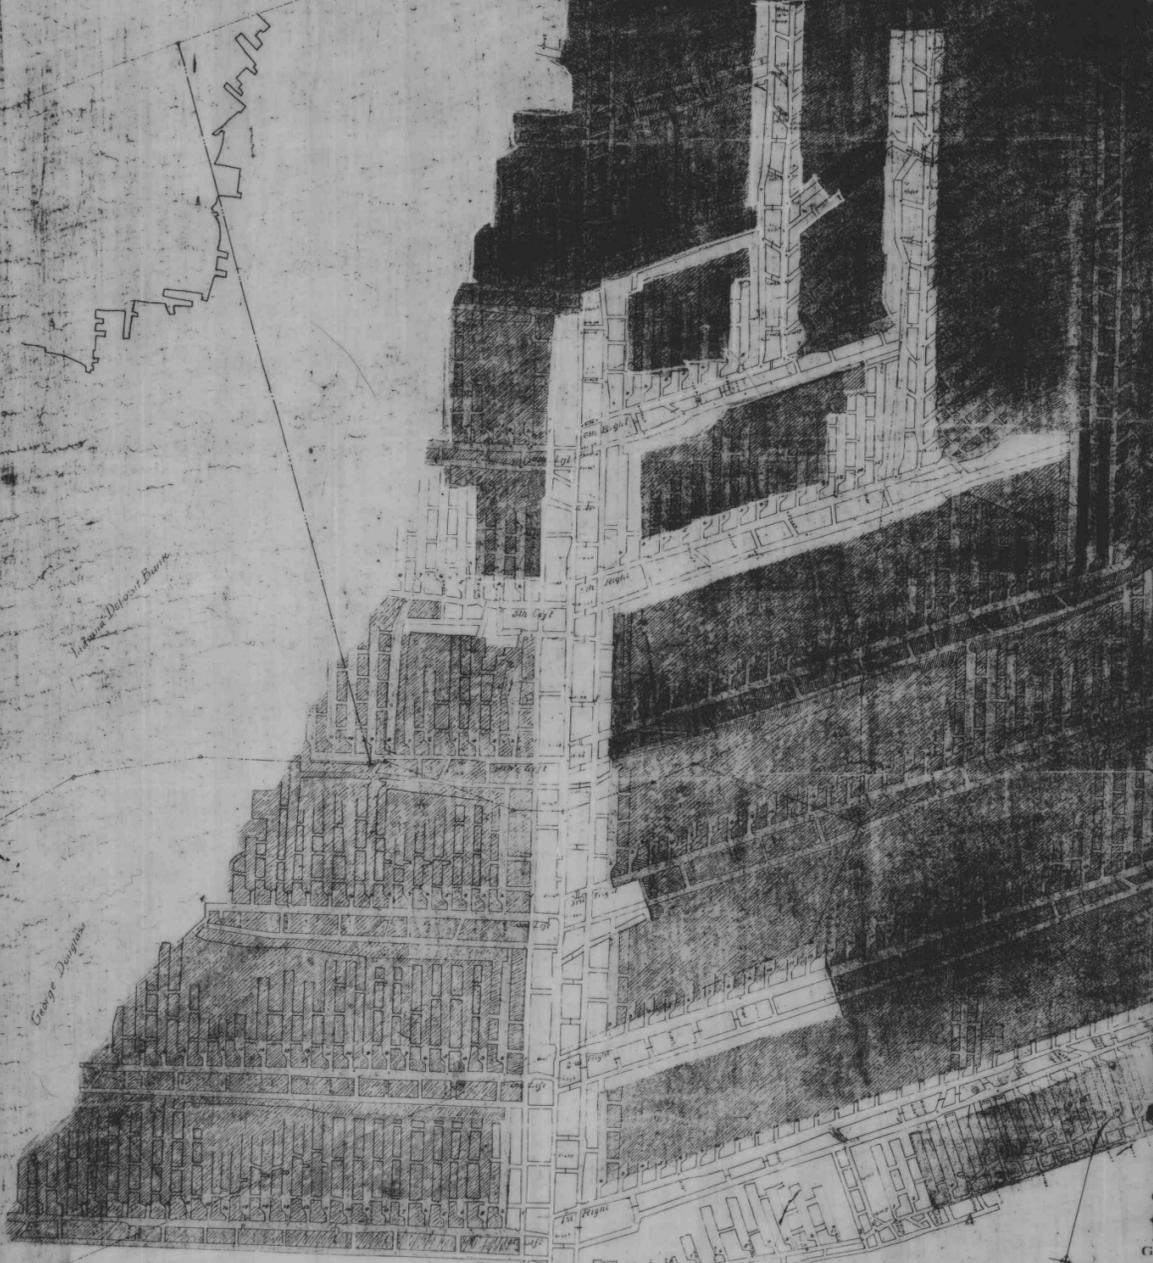

MAP OF
TUNNEL COALING CO'S
GREENWICH COAL & COKE CO'S
MINE NO. 2
SITUATE NEAR
GREEN STATION, CRESSON DIV. OF P. R. R.
INDIANA COUNTY, CAMERIA COUNTY,
SUSQUEHANNA TOWNSHIP,
SCALE 1"=100'

WORKINGS SURVEYED BY J. H. B. S. C. 1907

CONVEYANCE INDICATED THIS:
 - 1" = 100' HORIZONTAL SCALE
