
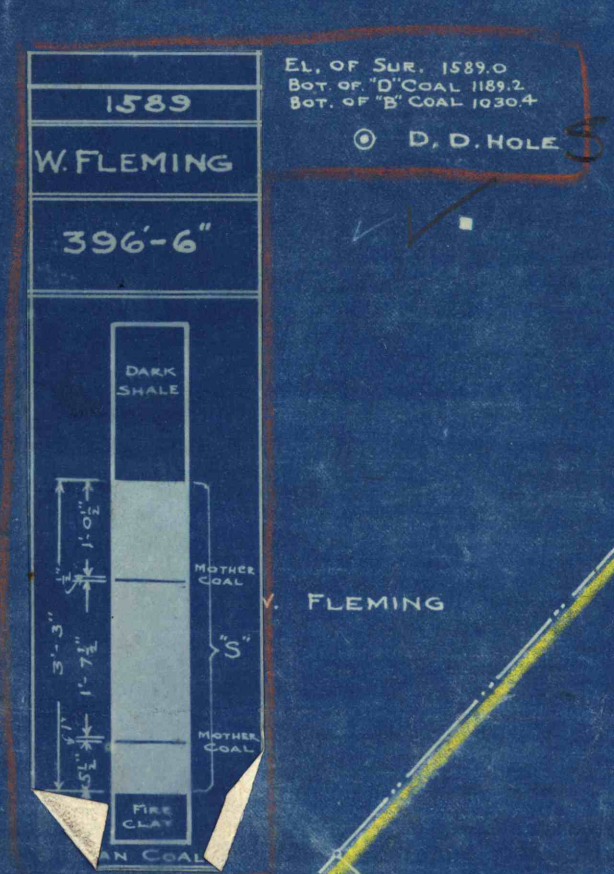
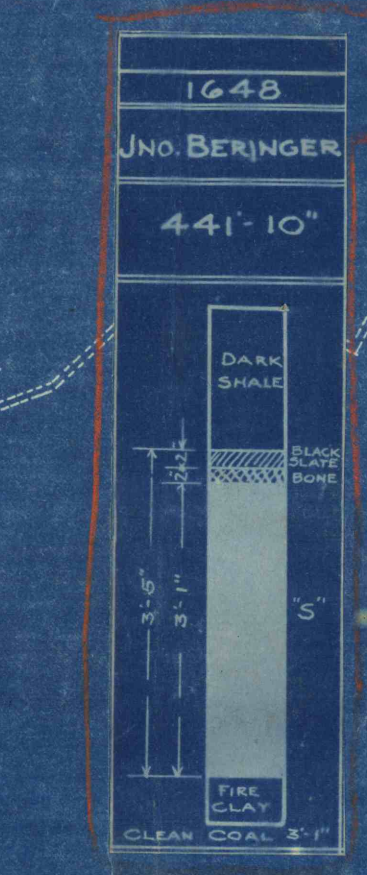
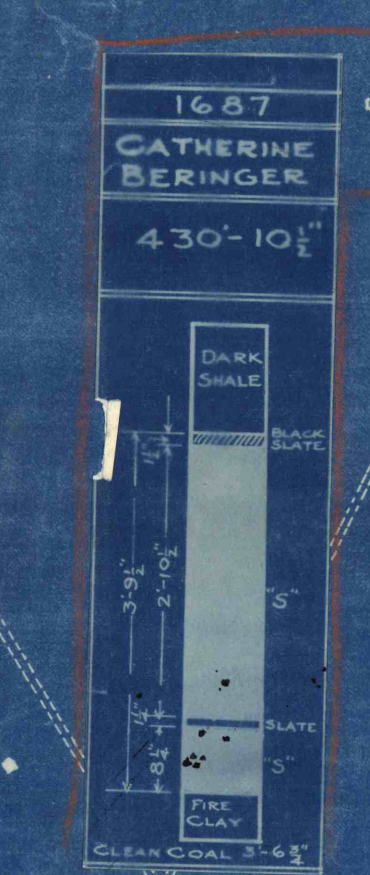
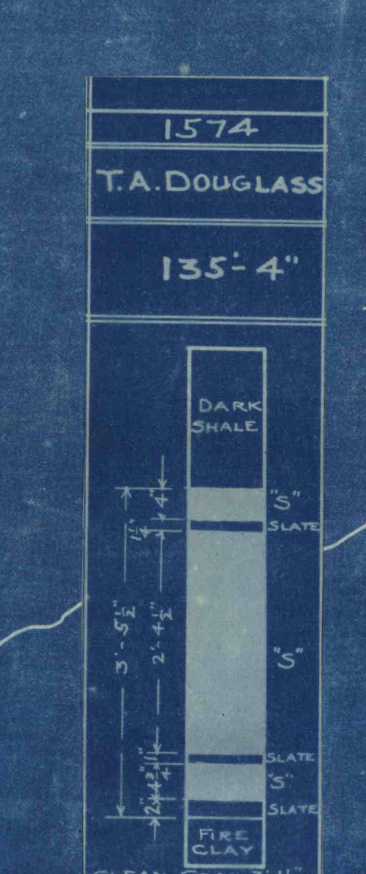
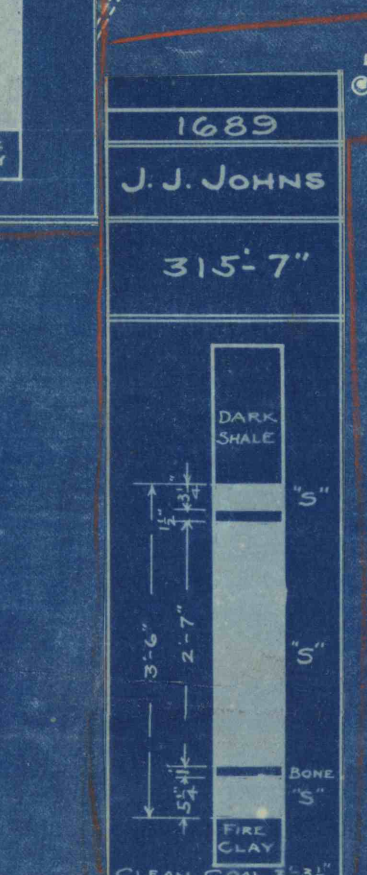
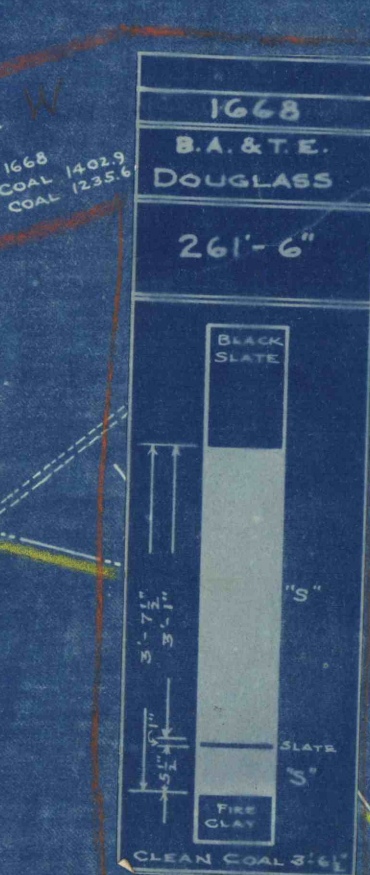
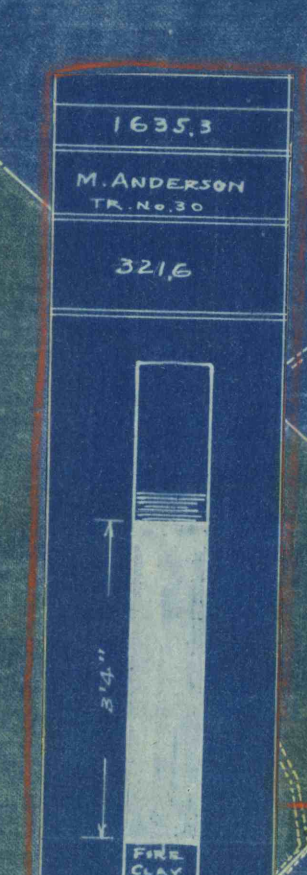
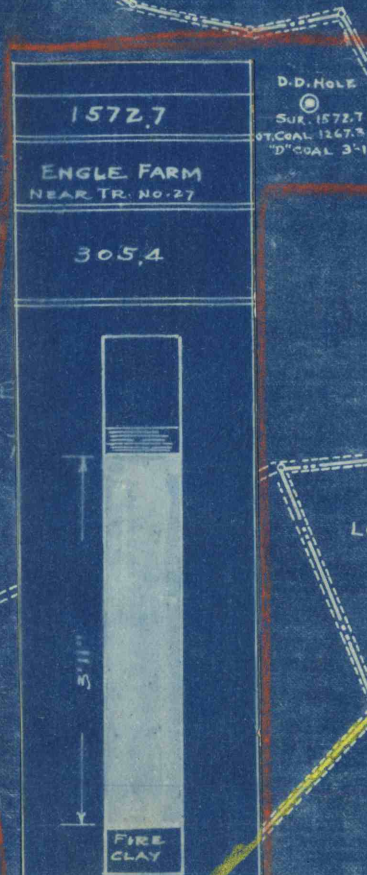


MAP OF
TUNNEL COALING CO'S
No. 2 and 3 MINES

SITUATE IN
GREEN TOWNSHIP INDIANA COUNTY, PA.
SUSQUEHANNA TWP. CAMBRIA COUNTY, PA.

Scale: 1 in. = 400 ft.

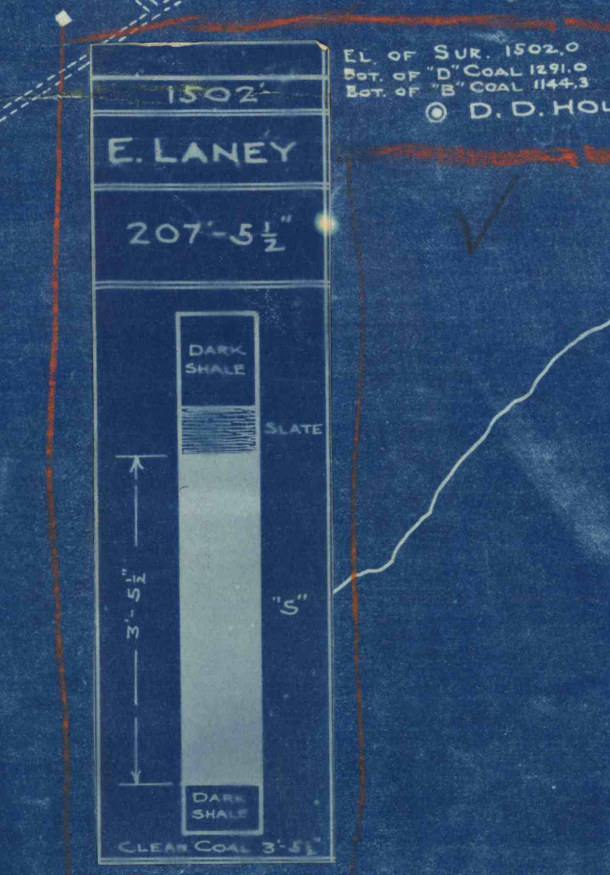

Ben Mary Coal Co.
Indiana Coal Co.
Horse

Ben Mary Coal Co.
Indiana Coal Co.
Horse

INDIANA COUNTY
CAMBRIA COUNTY