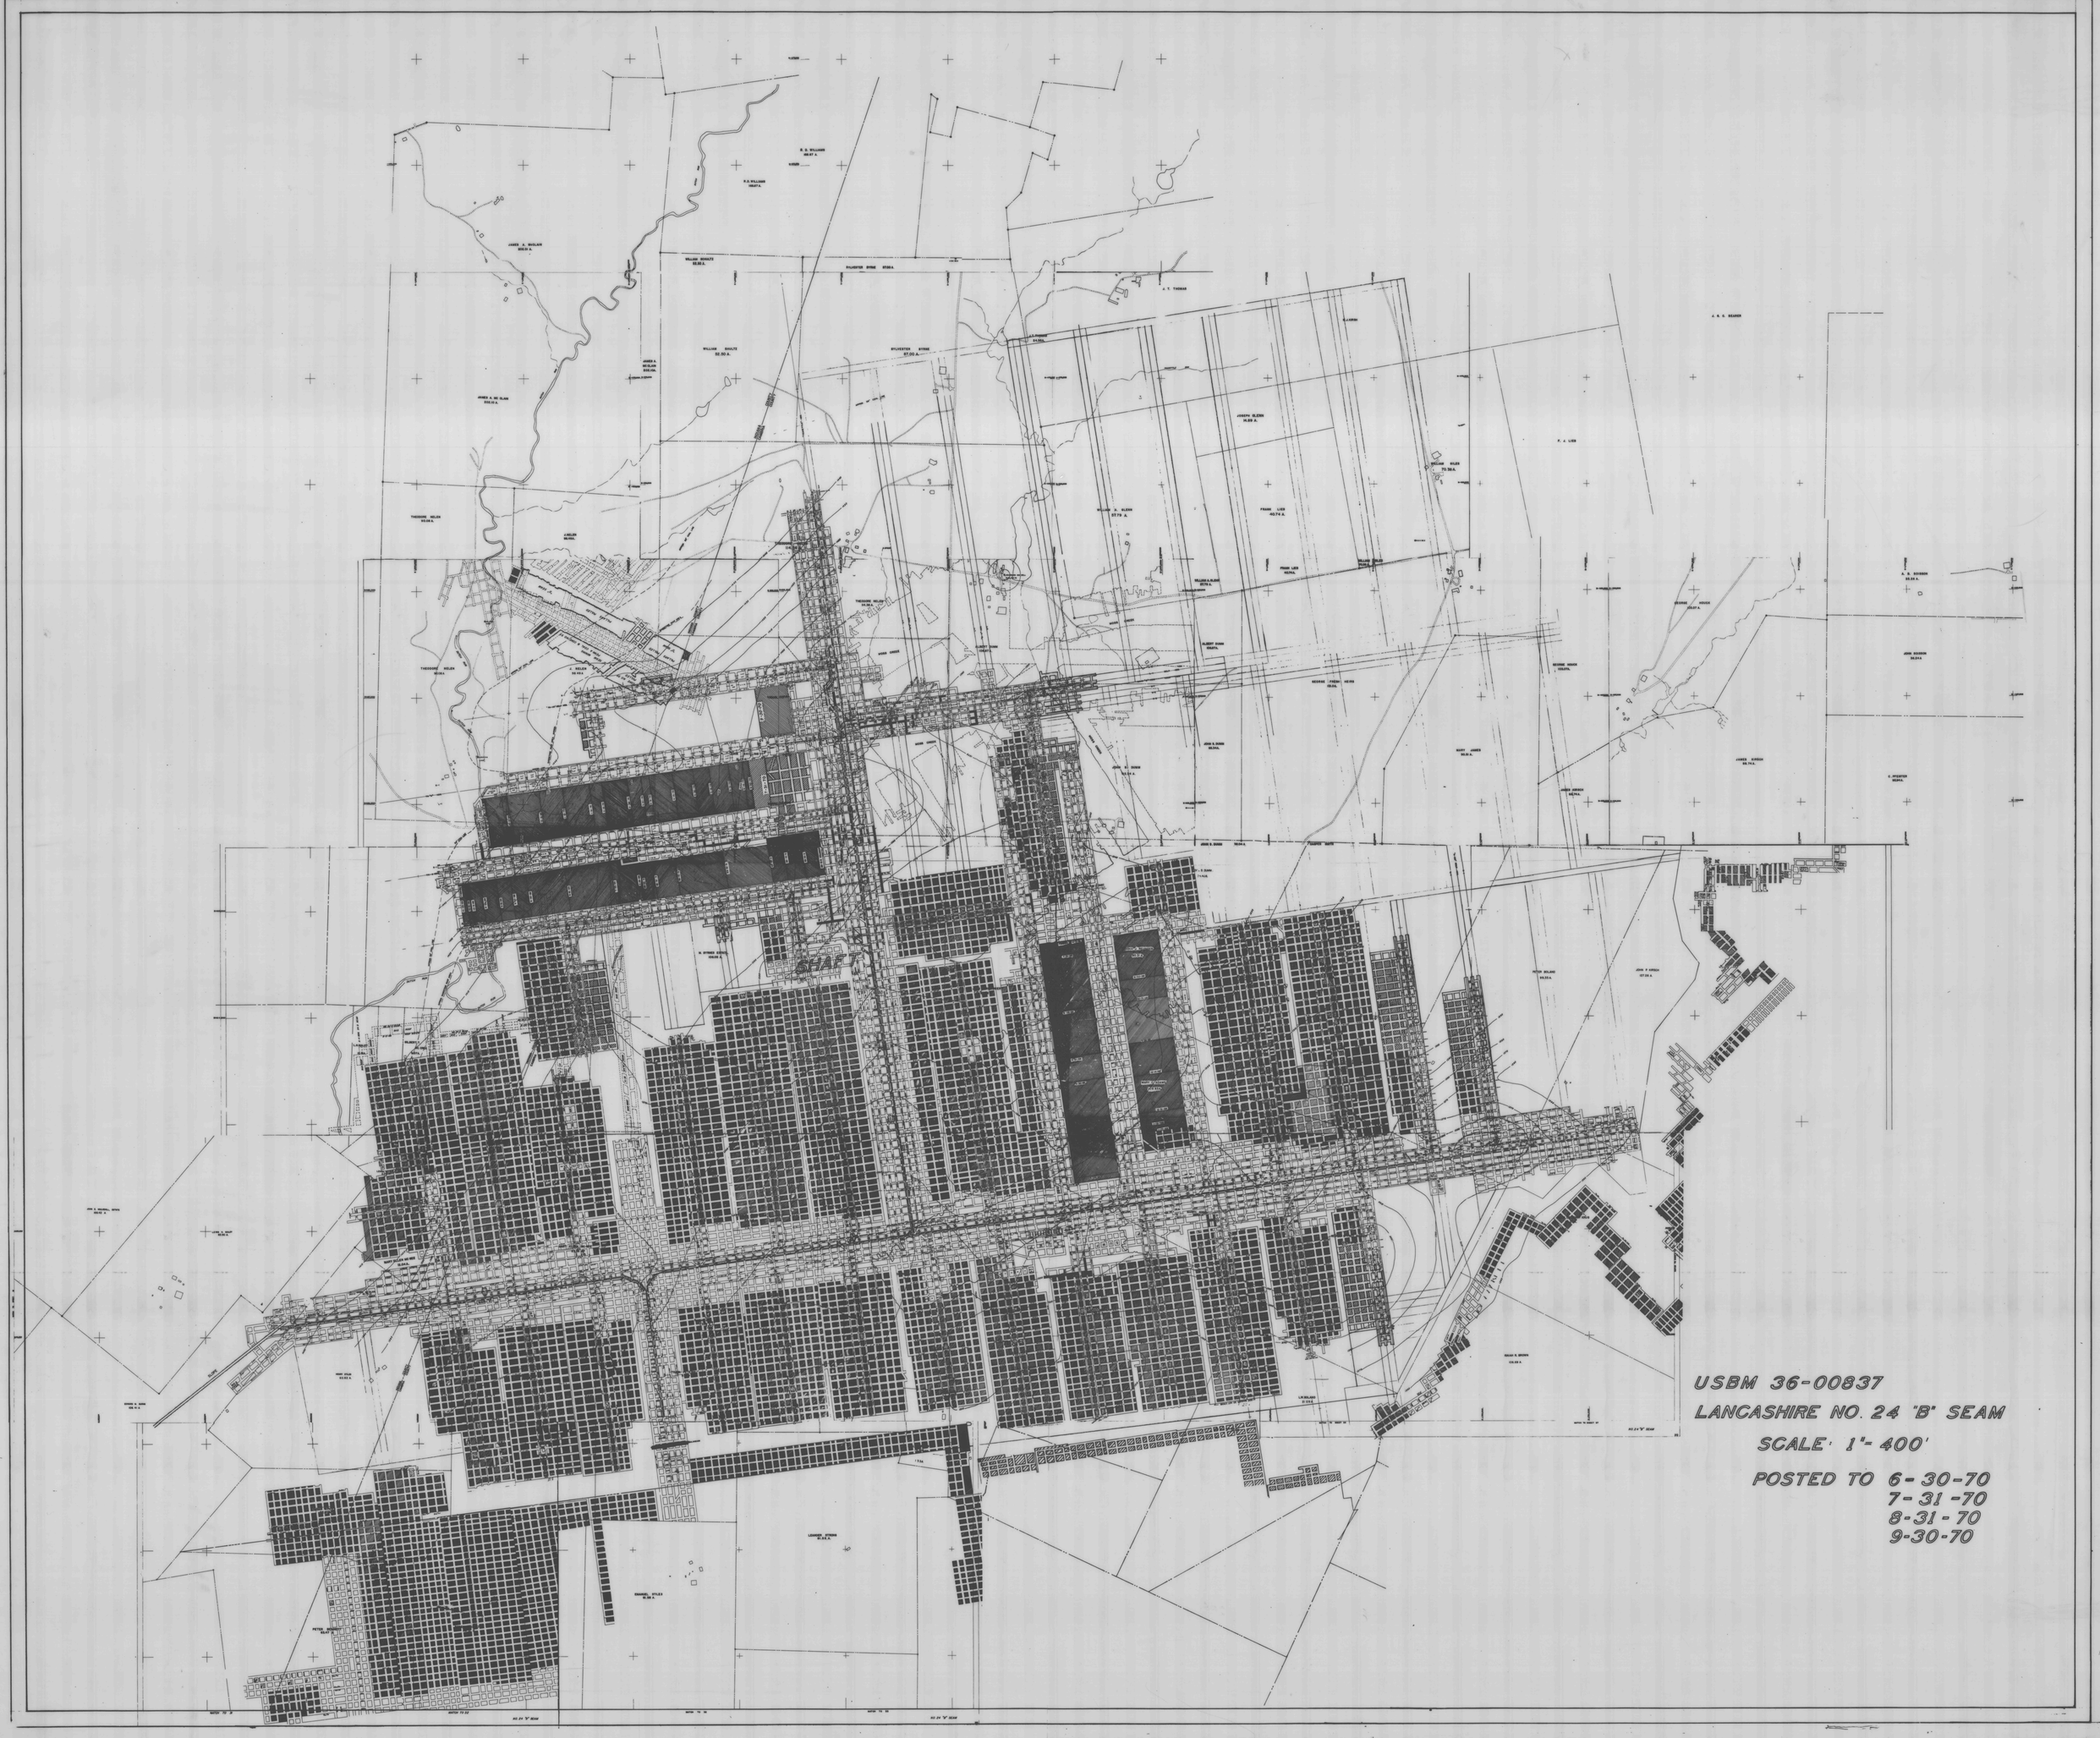
SHAFT
USBM 36-00837
LANCASHIRE NO. 24 'B' SEAM
SCALE: 1"= 400'
POSTED TO 6-30-70
7-31-70
8-31-70
9-30-70