


2-D-52

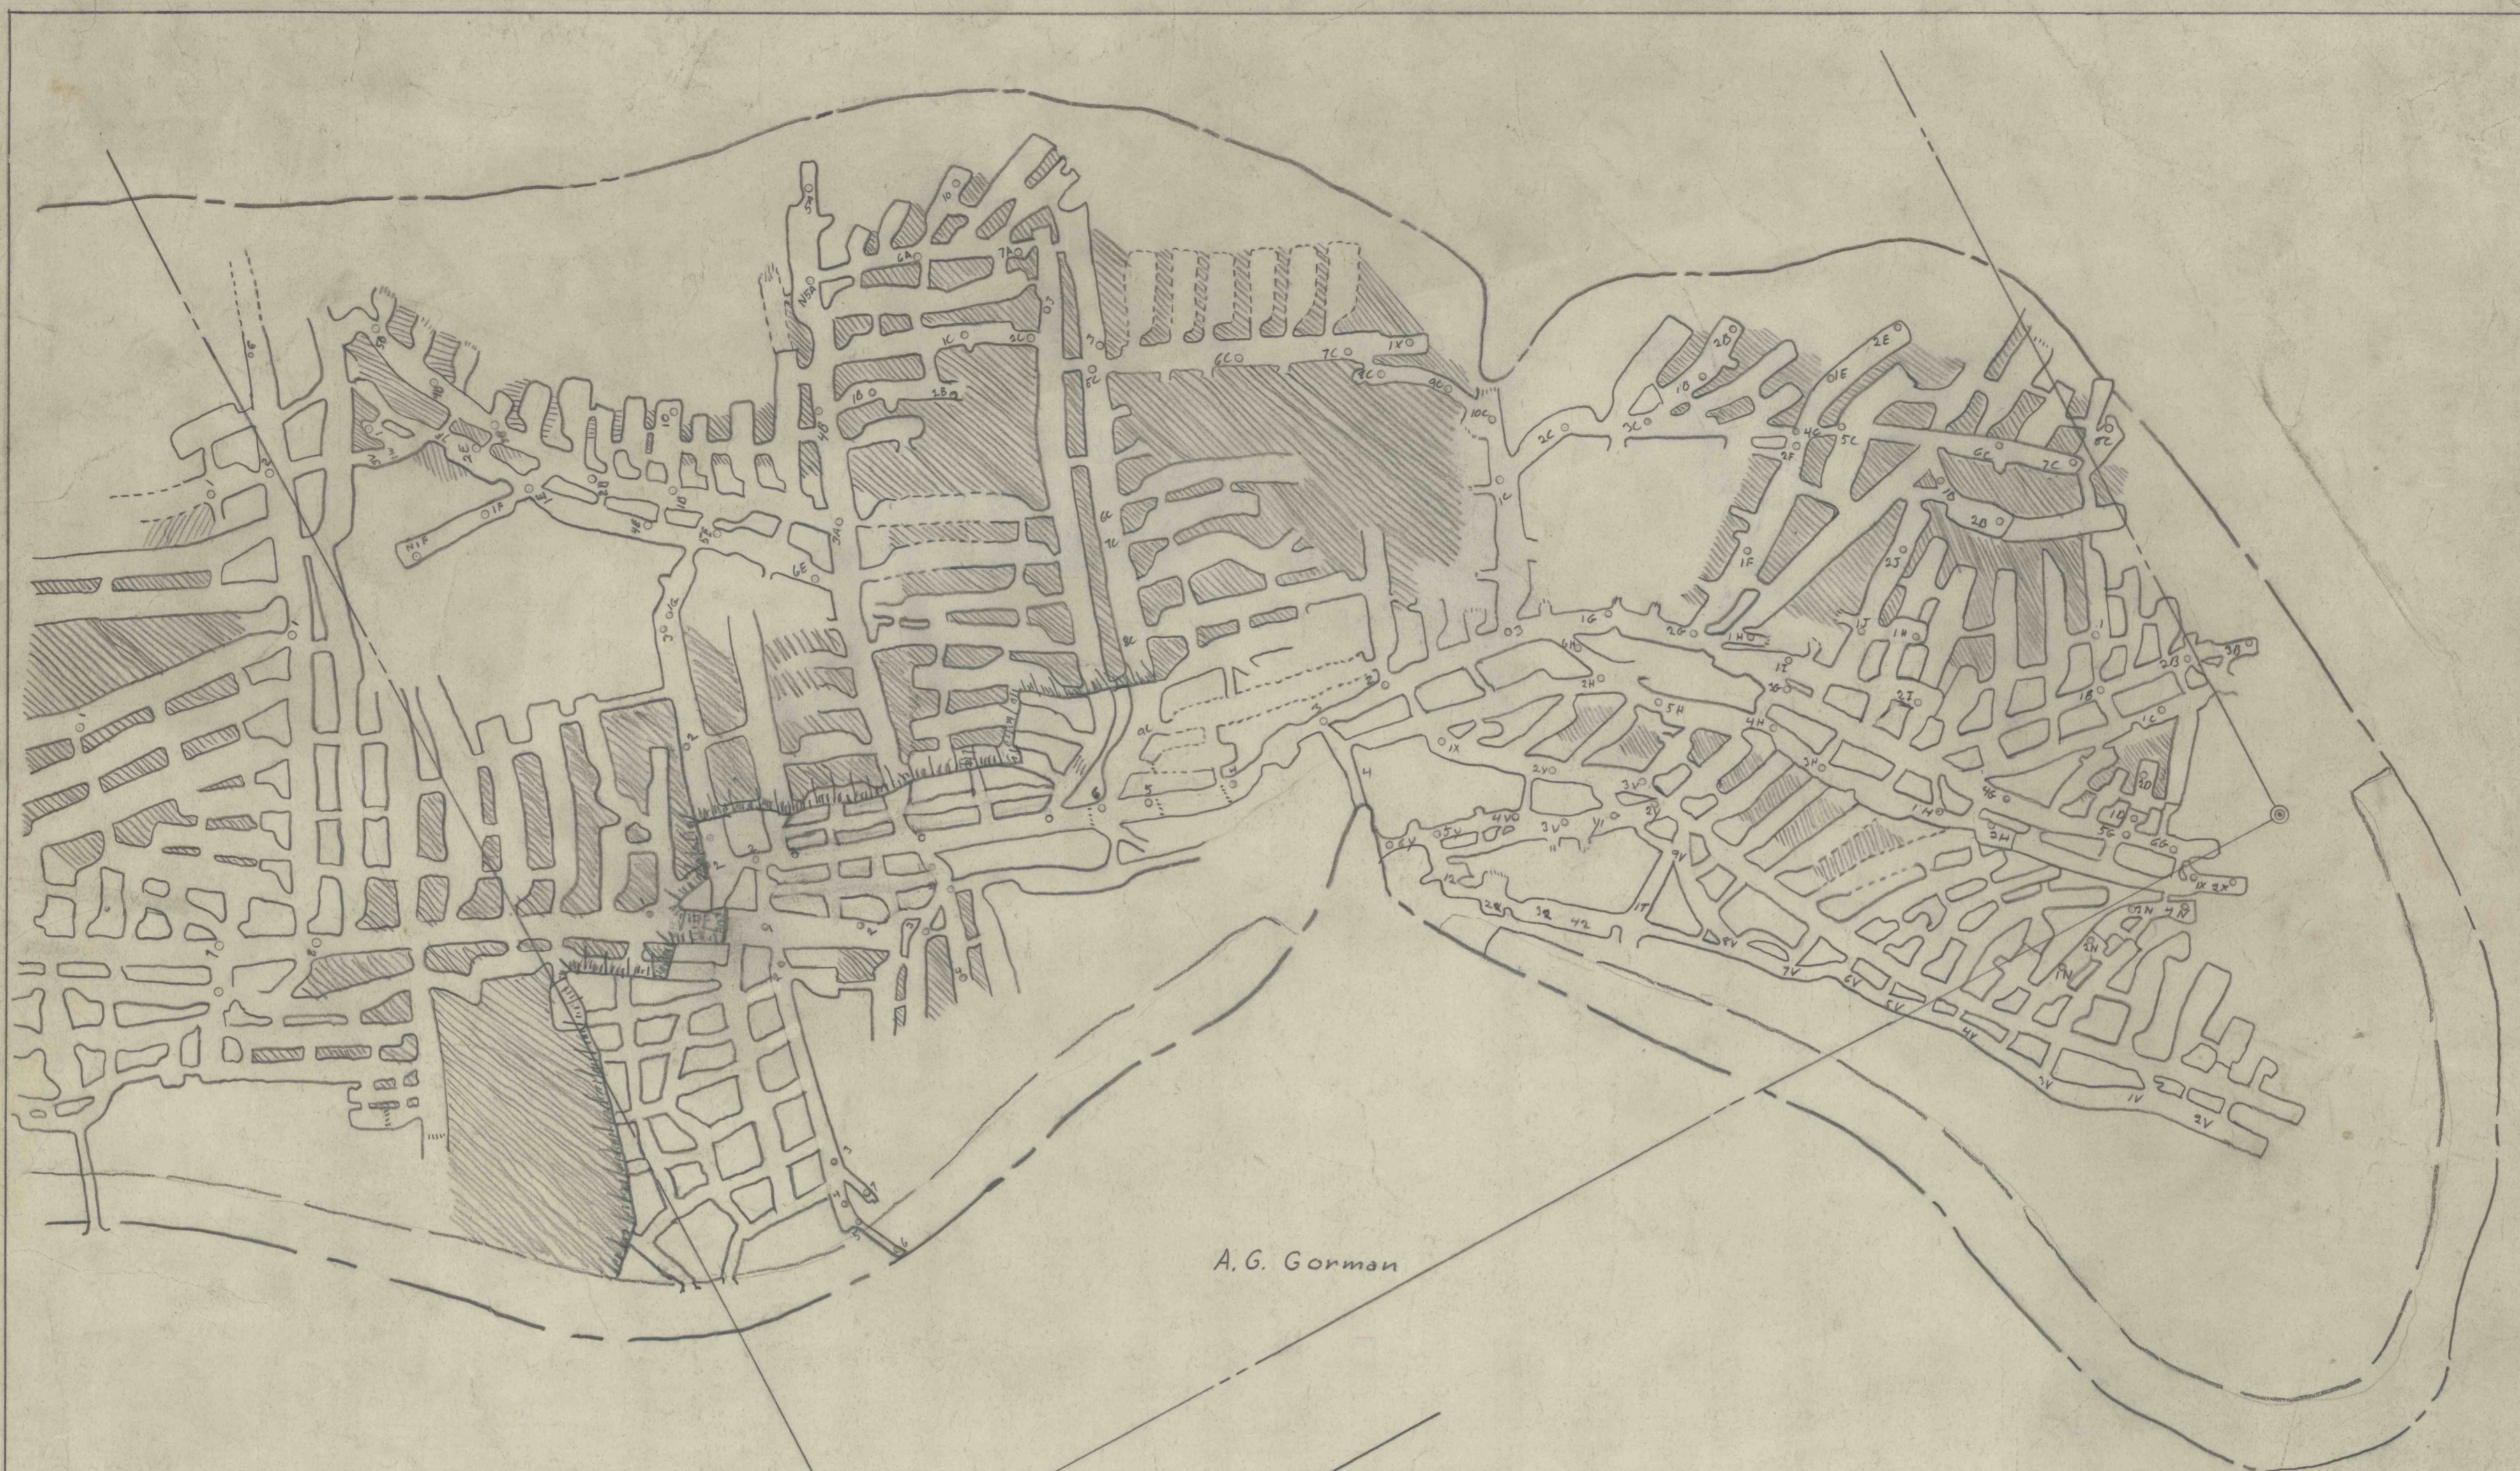

A.G. Gorman




MINE MAP
 ARCADIA COMPANY
 COAL MINE

Montgomery Township, Indiana County, Penna.
 Scale 1"= 100'
 June 16, 1960
 Walter J. Zimmerman Surveyor Engineer Punxsutawney, Pa.

Sept. 1, 1960

2-D-52

2-D-52a

2-D-52a