


RED - P.C. RR
BROWN - P.S. RR
GREEN - B.&O. RR.

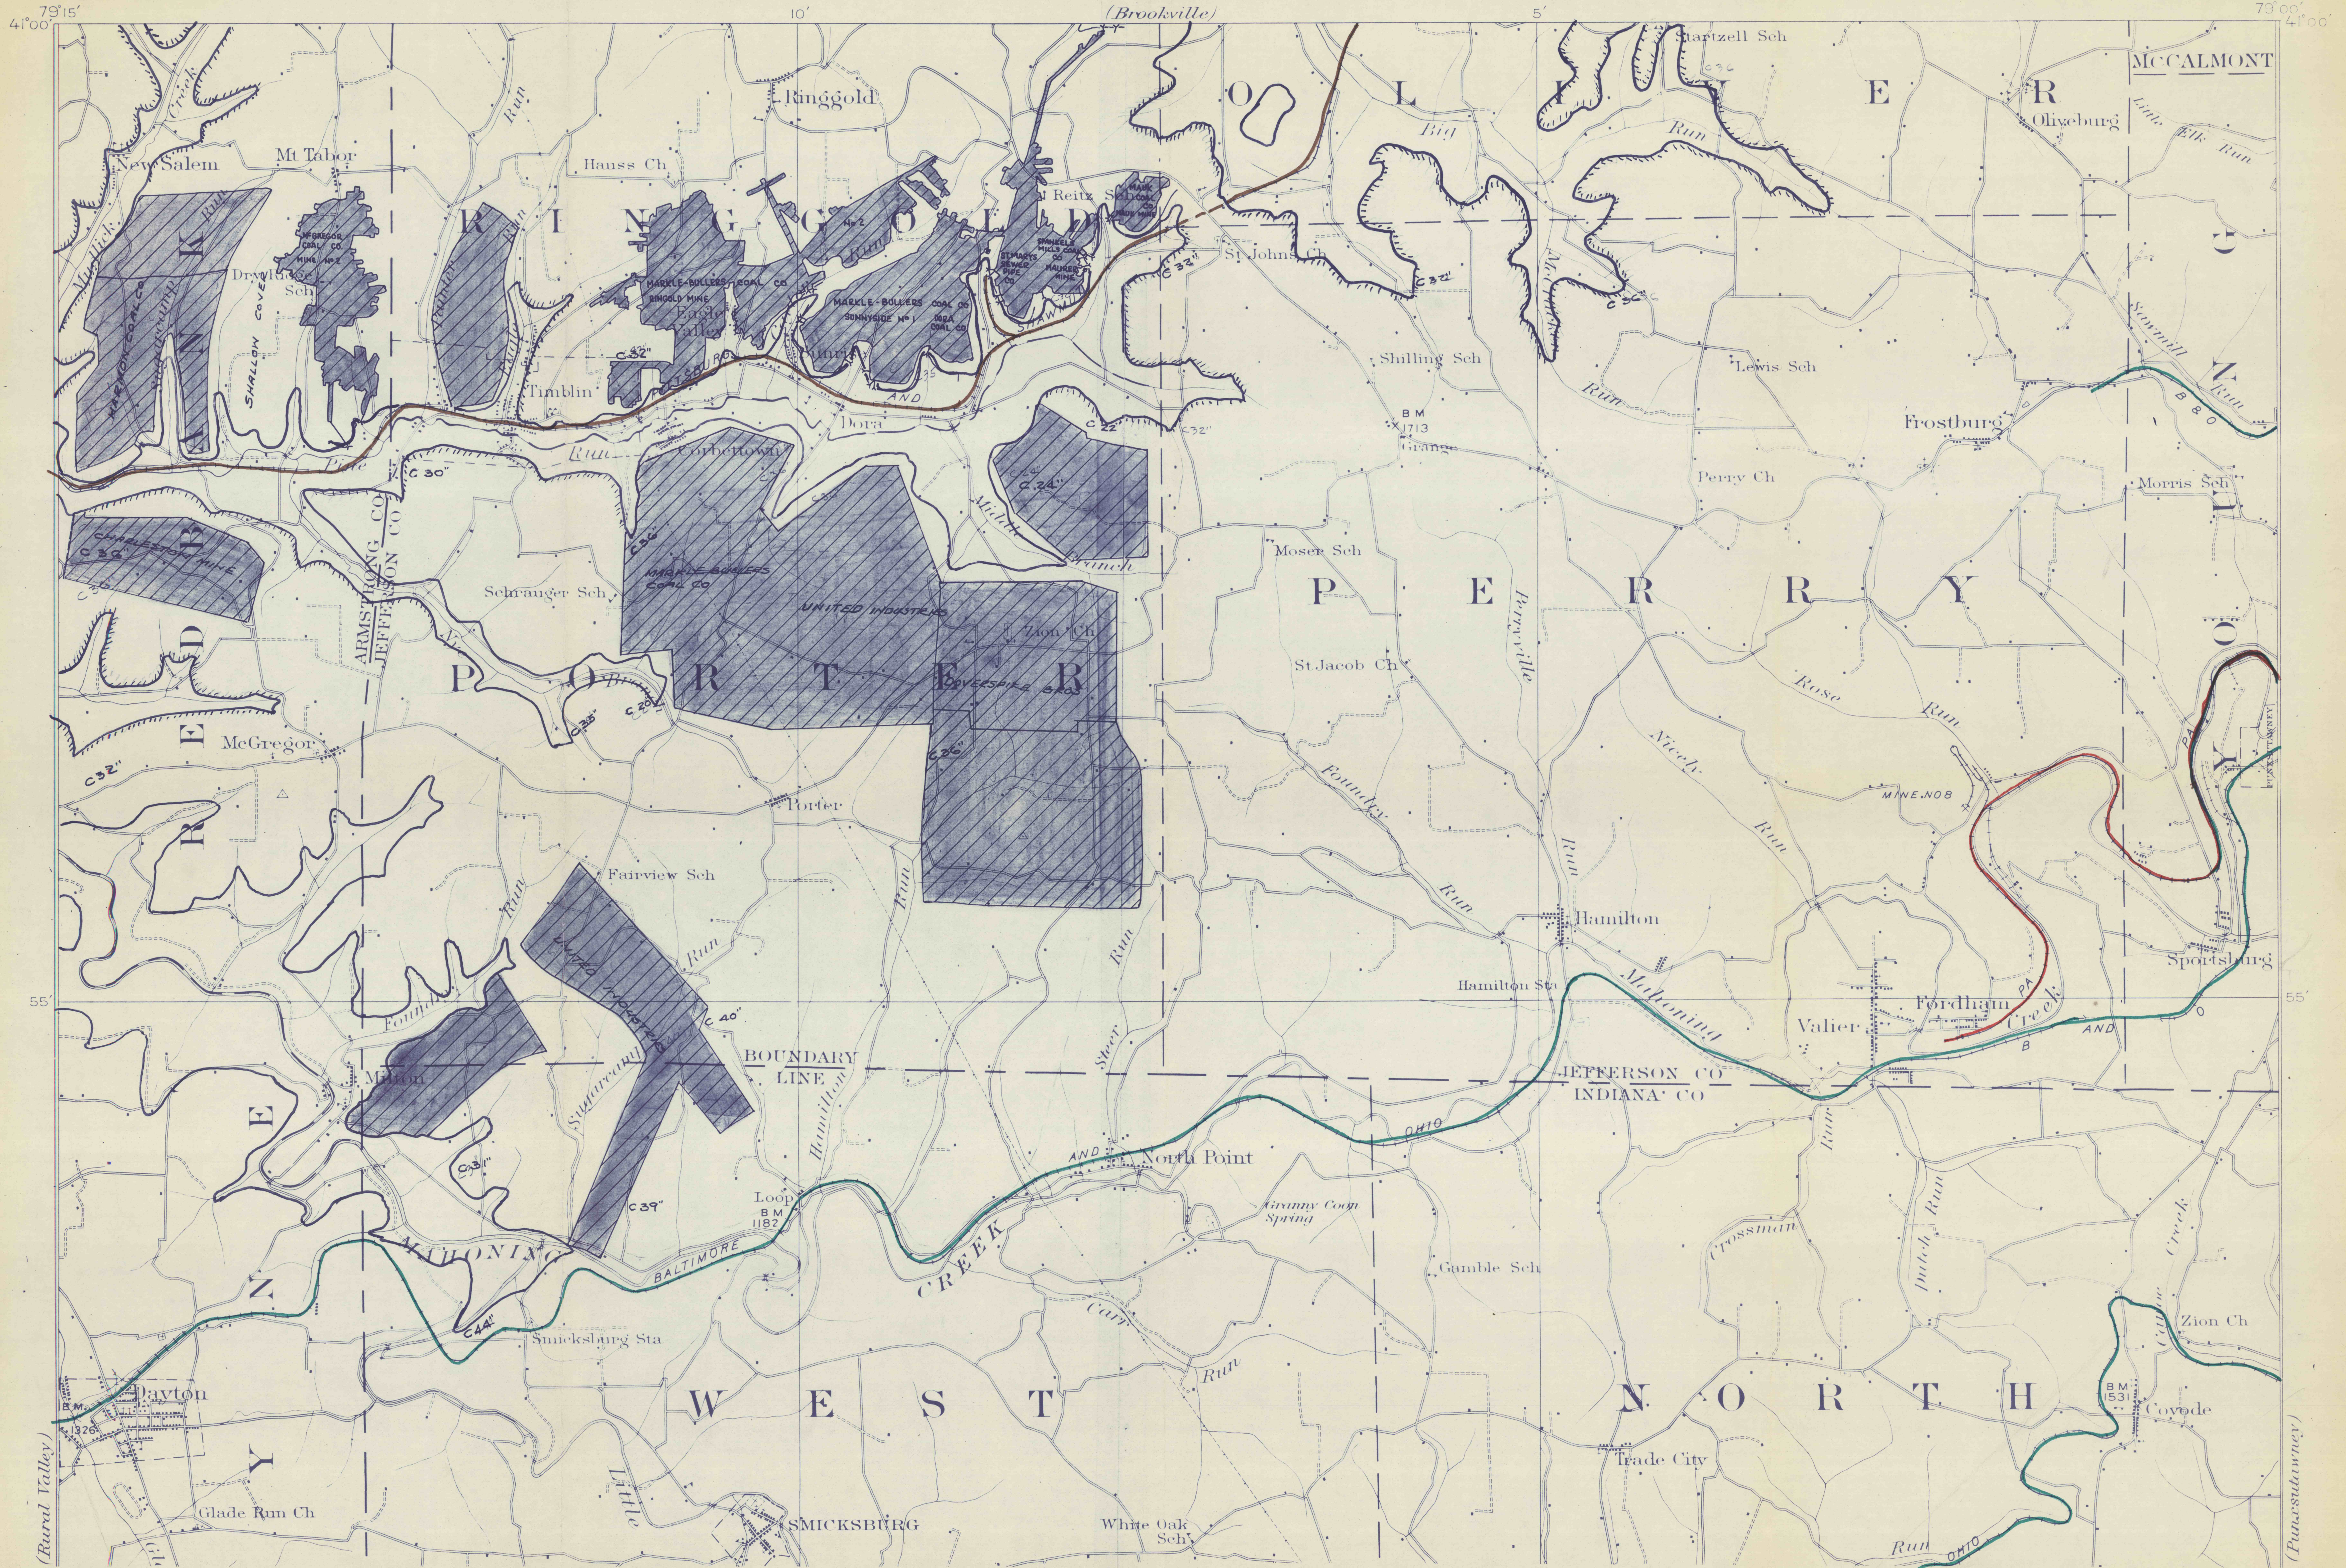

SCALE: 1"=2000'