

*Harman  
Coal  
Co.  
MS Supply Co.  
Frederick Corp*

*N. Kordachia  
improved on Bling  
of land owned by  
Puffo Mines  
The property  
was sold  
ca 1985*

*Maple Hill  
Co. Amer.  
Summit Coal  
Corp.*

*Northy. Co*


*Kennedy C.C.  
#4 Portal*

*Kennedy #4  
Portal*

*Shrock #3  
Portal #2*

*42*

Mapped, edited, and published by the Geological Survey  
Control by USGS and USC&GS  
Topography by photogrammetric methods from aerial  
photographs taken 1967. Field checked 1968  
Polyconic projection. 1927 North American datum  
10,000-foot grids based on Pennsylvania coordinate system,  
north and south zones.  
1,000-meter Universal Transverse Mercator grid ticks,  
zone 17, shown in blue  
Fine red dashed lines indicate selected fence and field lines where  
generally visible on aerial photographs. This information is unchecked  
Area covered by dashed light-blue pattern  
is subject to controlled inundation

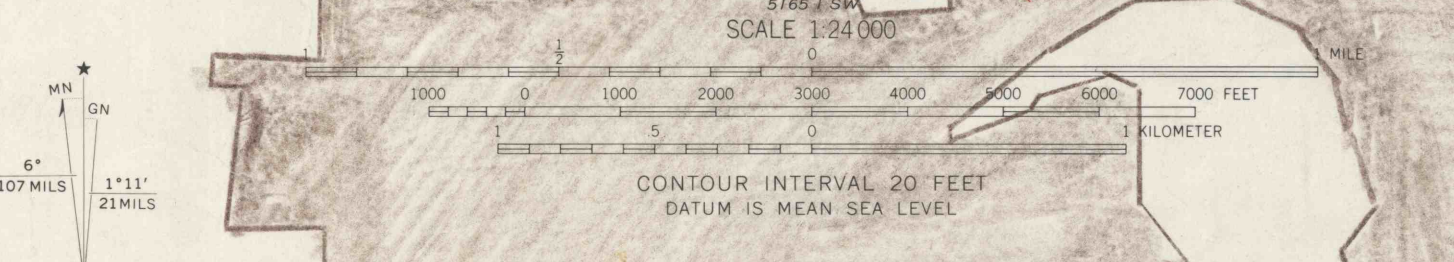

ROAD CLASSIFICATION  
Secondary highway, all weather - Light duty road, all weather,  
hard surface  
Unimproved road, fair or dry  
weather  
State Route

DAYTON, PA.  
NW/4 SMICKSBURG 15' QUADRANGLE  
1:4002.5 - W7907.5  
1968  
AMS 5161 NW-SERIES V831

*Lease Lines  
Bap  
Mines*