

# Subsidence Legend

Previous Six-Month's Mining

Contemplated Mining To

Mining Completed

Subsidence Control Plan Boundary

Occupied Dwelling

Unoccupied Structures

SUPPORT AREAS:

No Mining Within

Subsidence Control Area

NOTE: Any Pillar That Straddles A Support Line Will Remain In Place.

NO MINING AREA

NO MINING

MINING ON

SUBSIDENCE CONTROL BLOCK

9 LEHS OF HOIAM  
MATCH TO SHEET 6

**VALLEY COAL COMPANY**

LEONARD RUN NO. 1 MINE  
LOWER KITTANNING COAL SEAM

STATE: PENNSYLVANIA  
COUNTY: INDIANA COUNTY

SHEET #7

SCALE: 1" = 200'


RD 1 Central City, PA 15926  
(814) 754-8477

**Musser Engineering, Inc.**

**FINAL MAP 4-30-98**

**MODULE 19.5**

MUSSEER ENGINEERING, INC. IS NOT RESPONSIBLE FOR MAPPING BEFORE JUNE, 1993. MAPPING PRIOR TO THAT DATE WAS CONDUCTED BY THE ENGINEERING STAFF OF VALLEY COAL COMPANY.

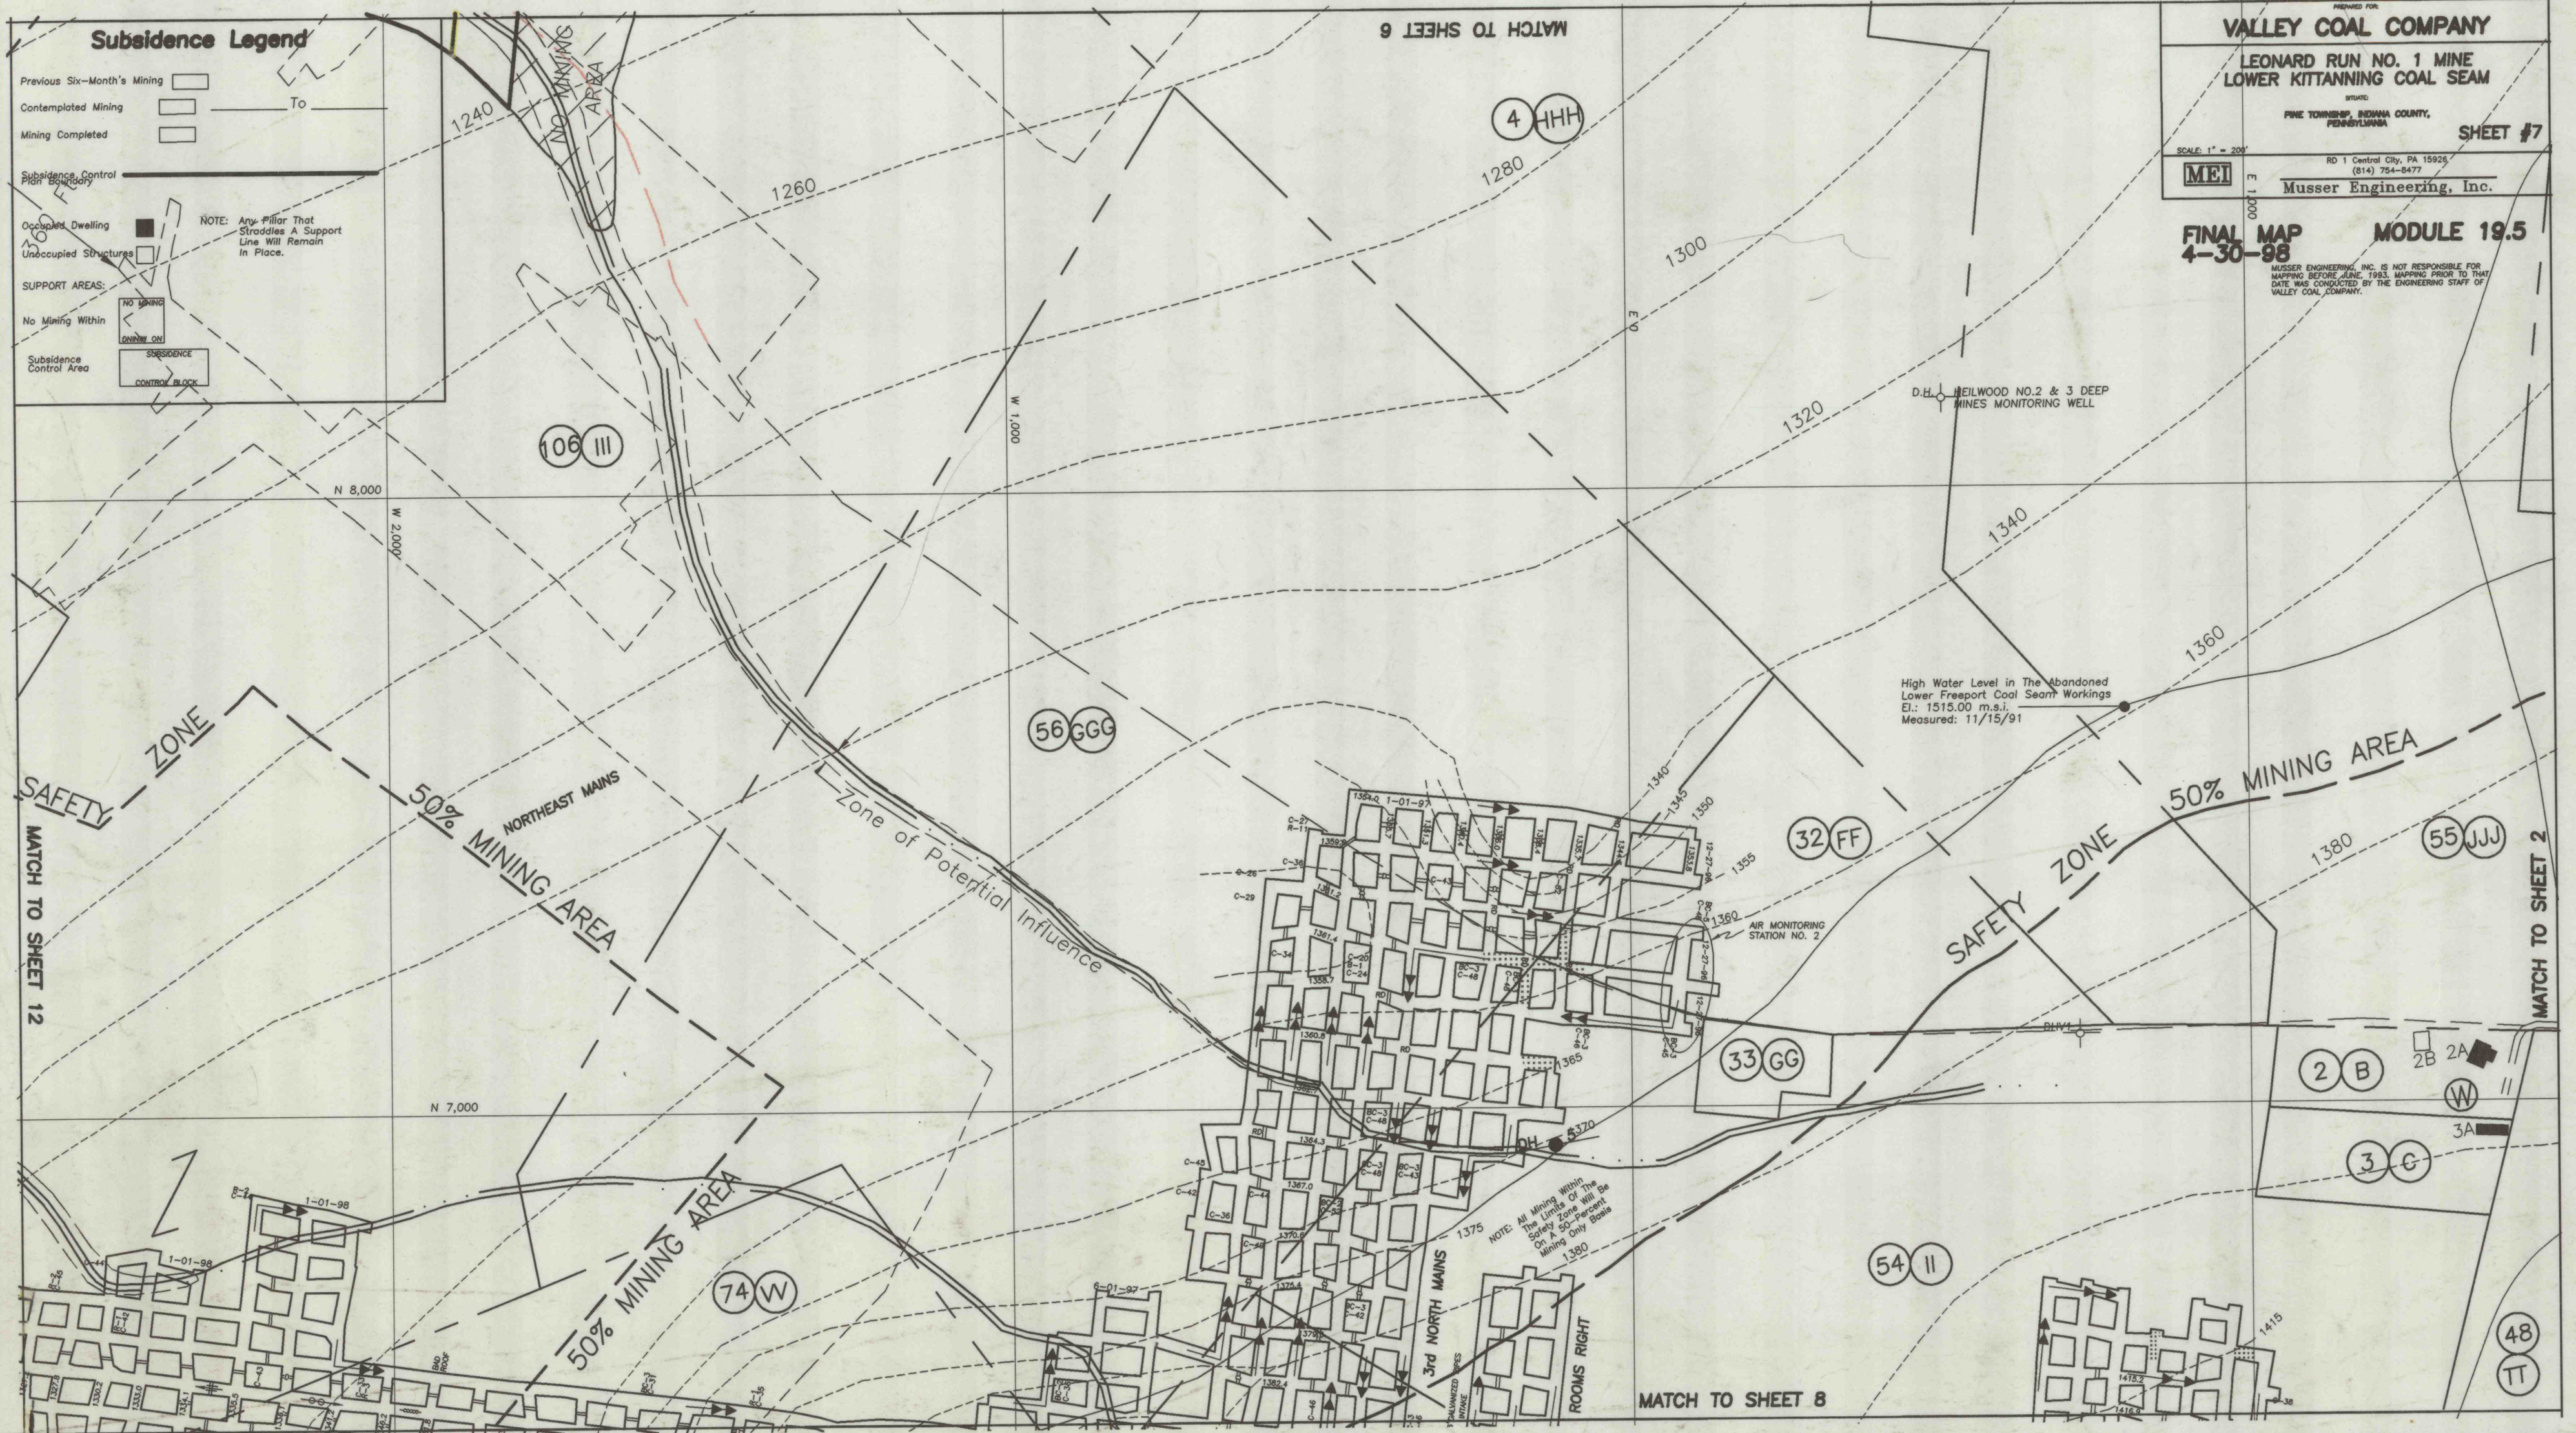

MATCH TO SHEET 12

MATCH TO SHEET 2

MATCH TO SHEET 8

48 TT