


101-337

PANTALL

CHAS. A. MORRIS

JORDAN

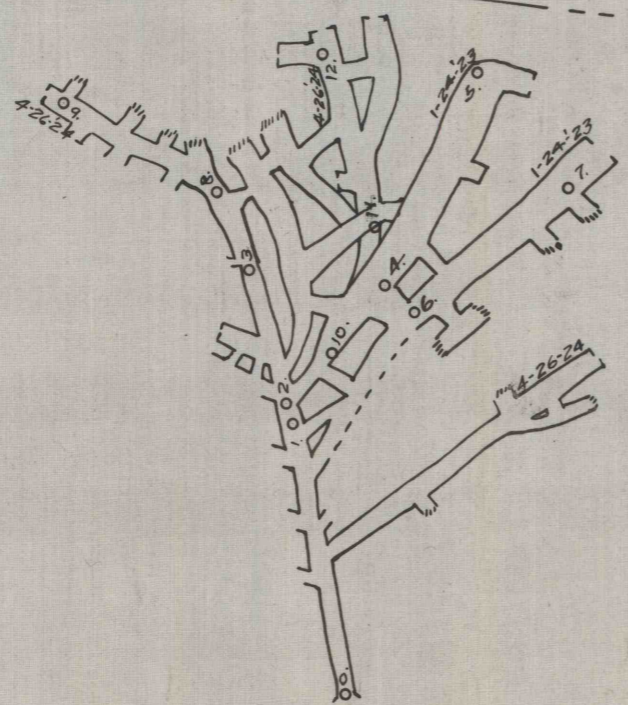

DINGER-COAL
MILLER-SURFACE

MINE MAP
 W. J. MILLER MINE
 Situate near Oliveburg Pa.
 Scale 1"=100' April 30, 1924.
 H.M. Kanarr Engineer
 Punxsutawney, Pa.

Handwritten notes:
Miller
Punxsutawney, Pa.

