


1-D-22

1-B-103

501-731

1-B-103

111 sink Holston hole  
found off of pit  
1-B-103

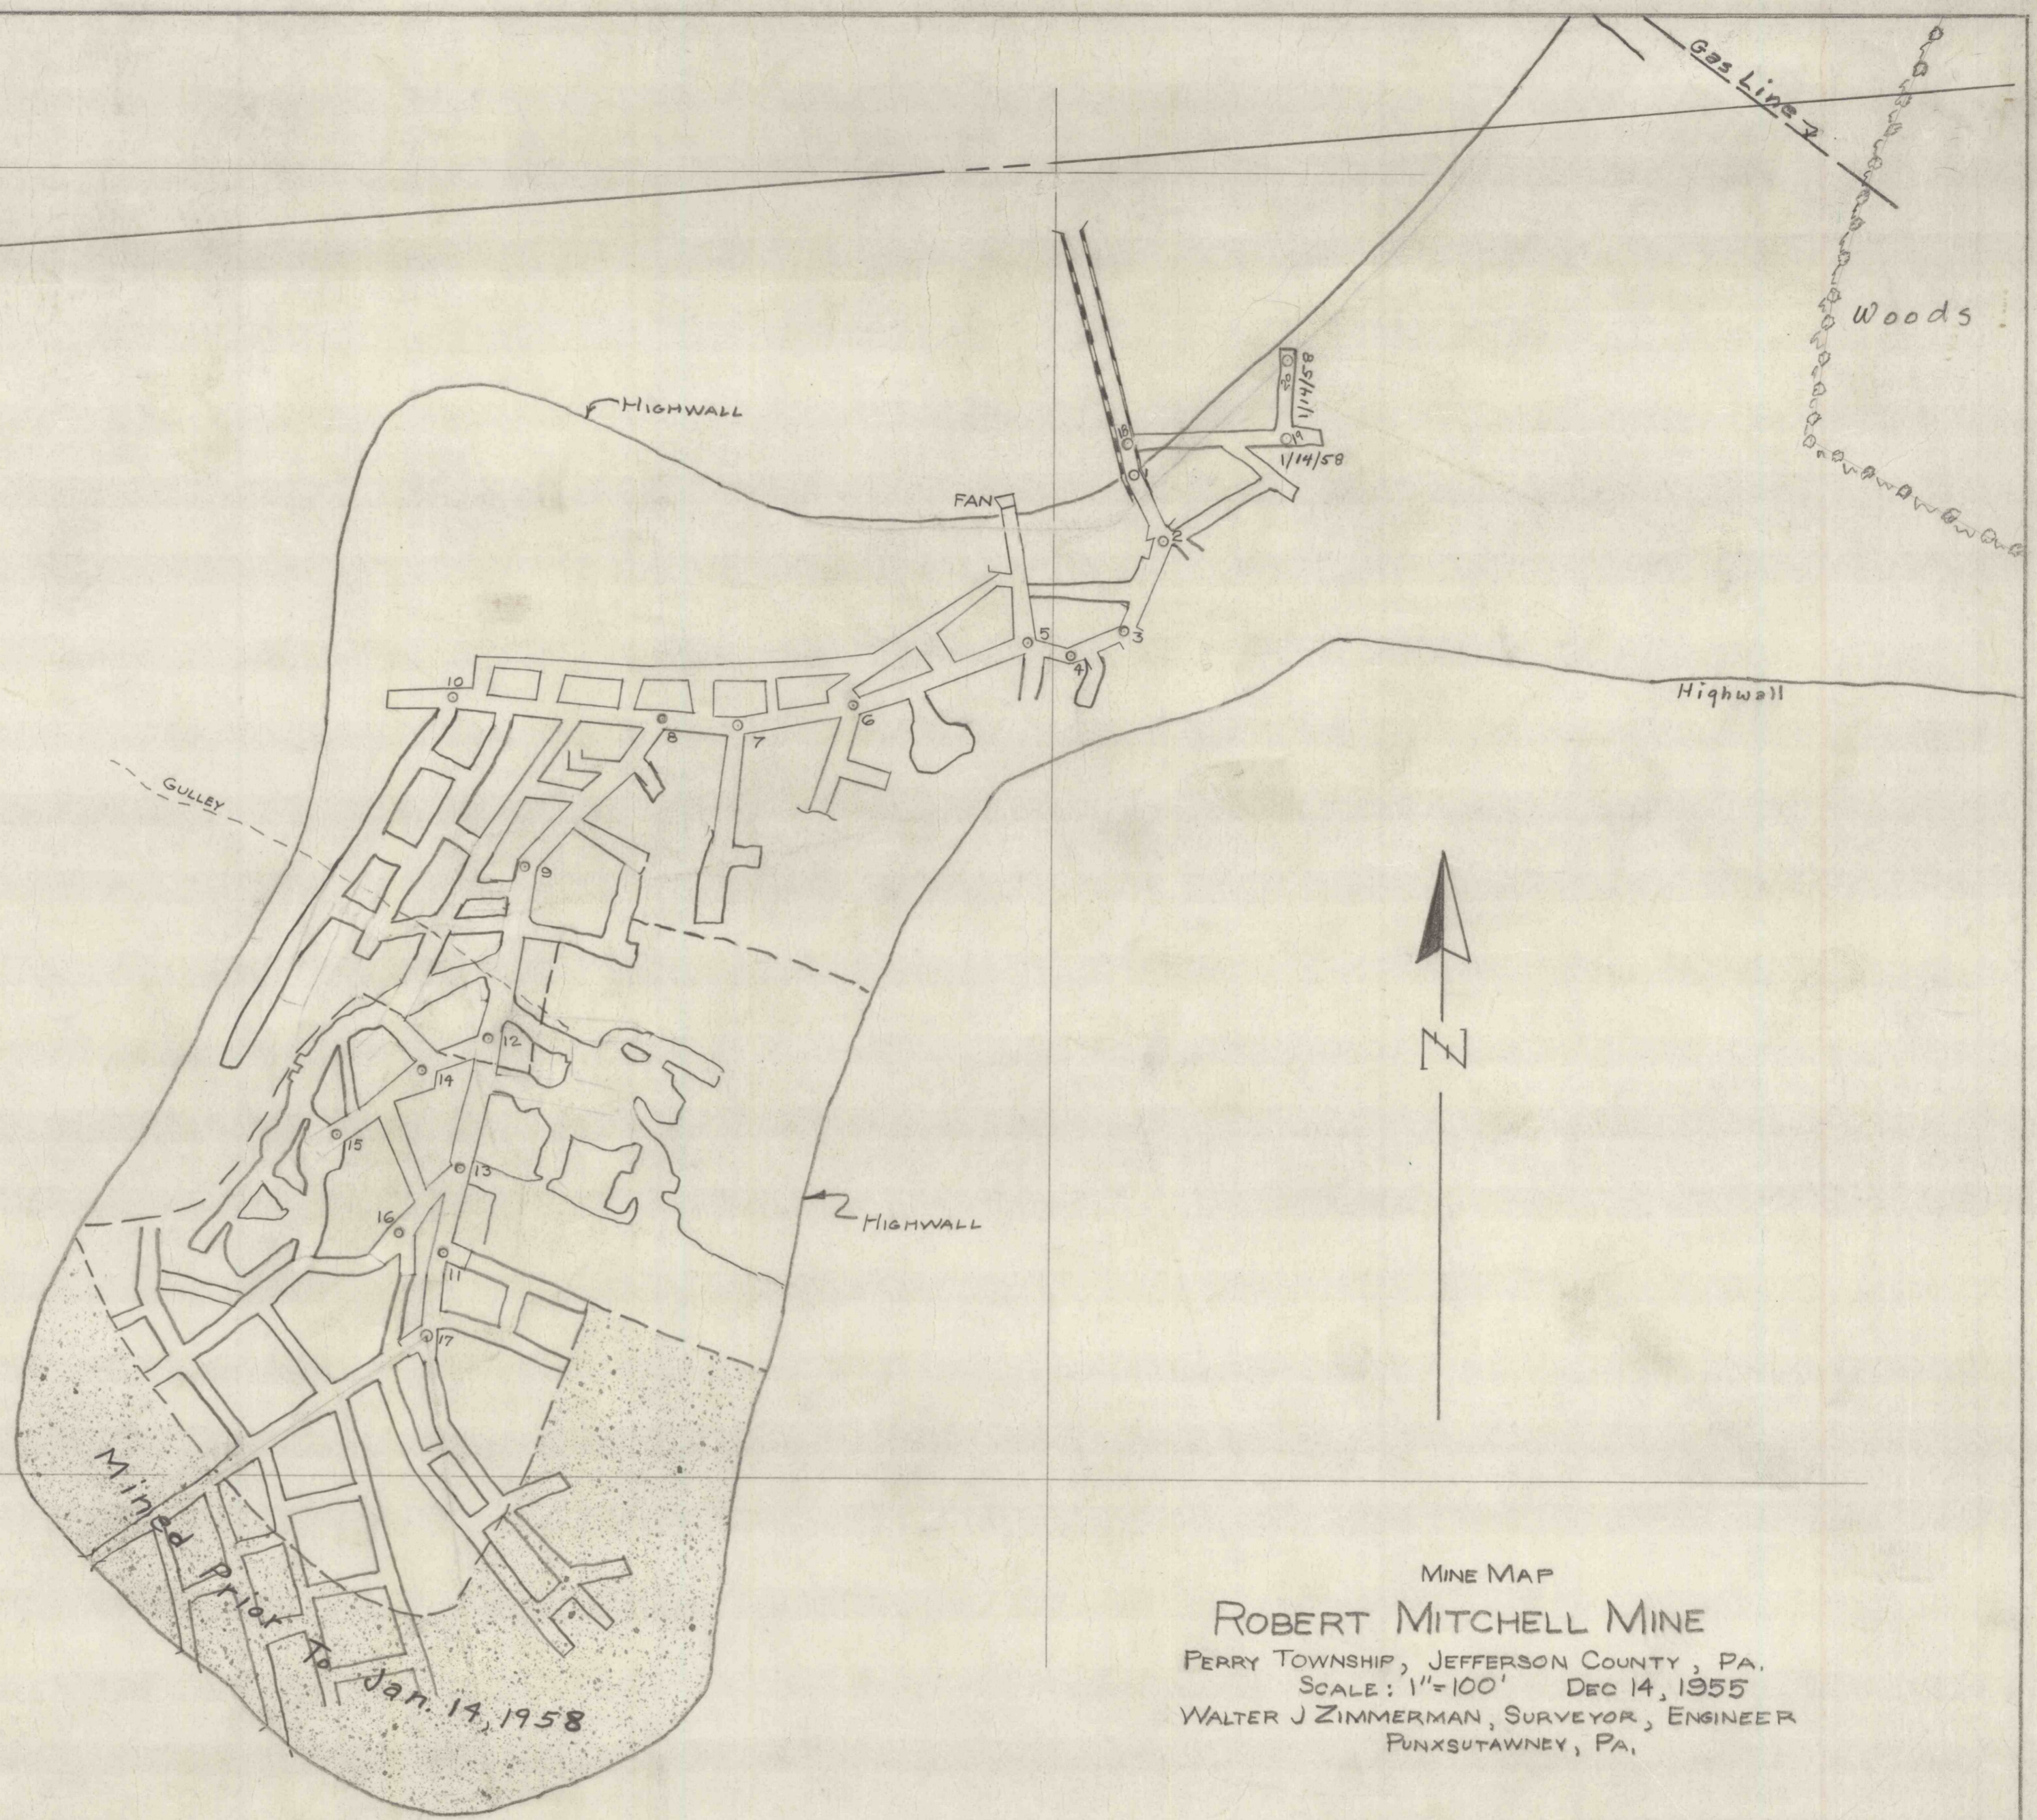

MINE MAP  
**ROBERT MITCHELL MINE**  
 PERRY TOWNSHIP, JEFFERSON COUNTY, PA.  
 SCALE: 1"=100' DEC 14, 1955  
 WALTER J ZIMMERMAN, SURVEYOR, ENGINEER  
 PUNXSUTAWNEY, PA.

1-B-103