


2-D-21



WILMORE COAL CO.

CAROLINE HAMILTON

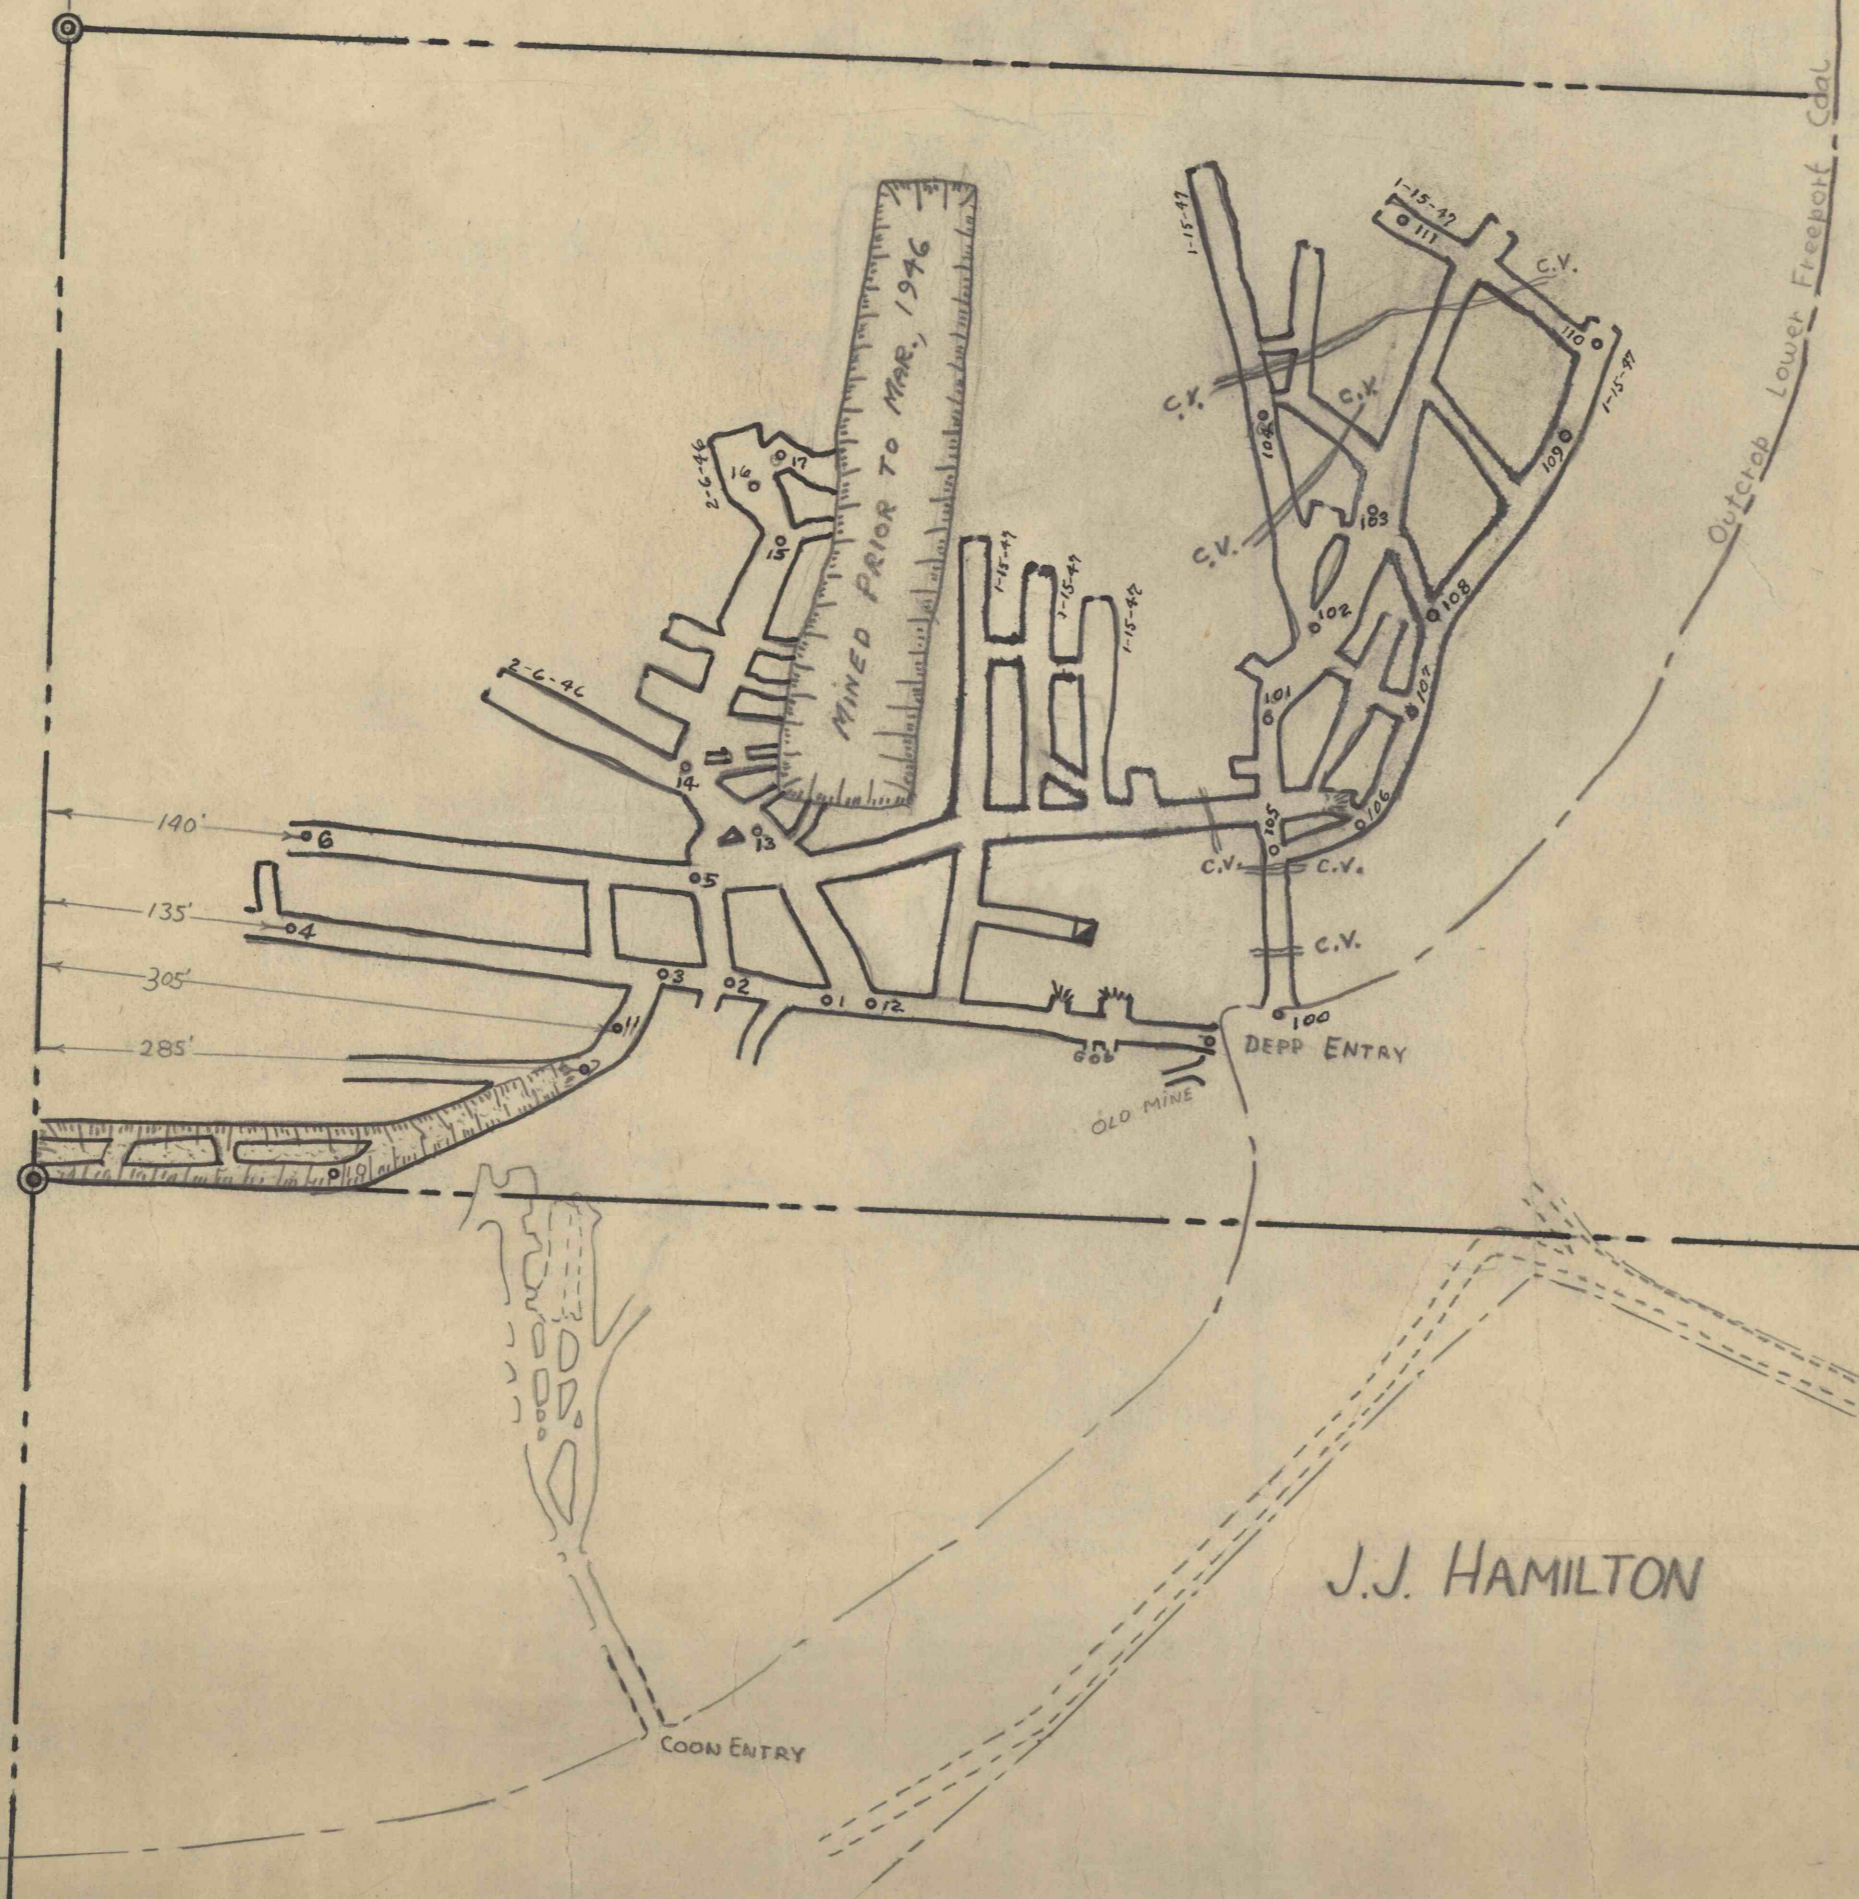

J.J. HAMILTON

MINE MAP
 OF
 W. R. DEPP & SONS MINE
 DERRY TOWNSHIP - JEFFERSON CO., PA.

SCALE 1"=100'

MARCH 1946

Walter J. Zimmerman
 Surveyor
 Pottsville, Pa.

2-D-21

2-D-21

256-108

2-D-21